


S-E 7-00-

N. Y. C.

500

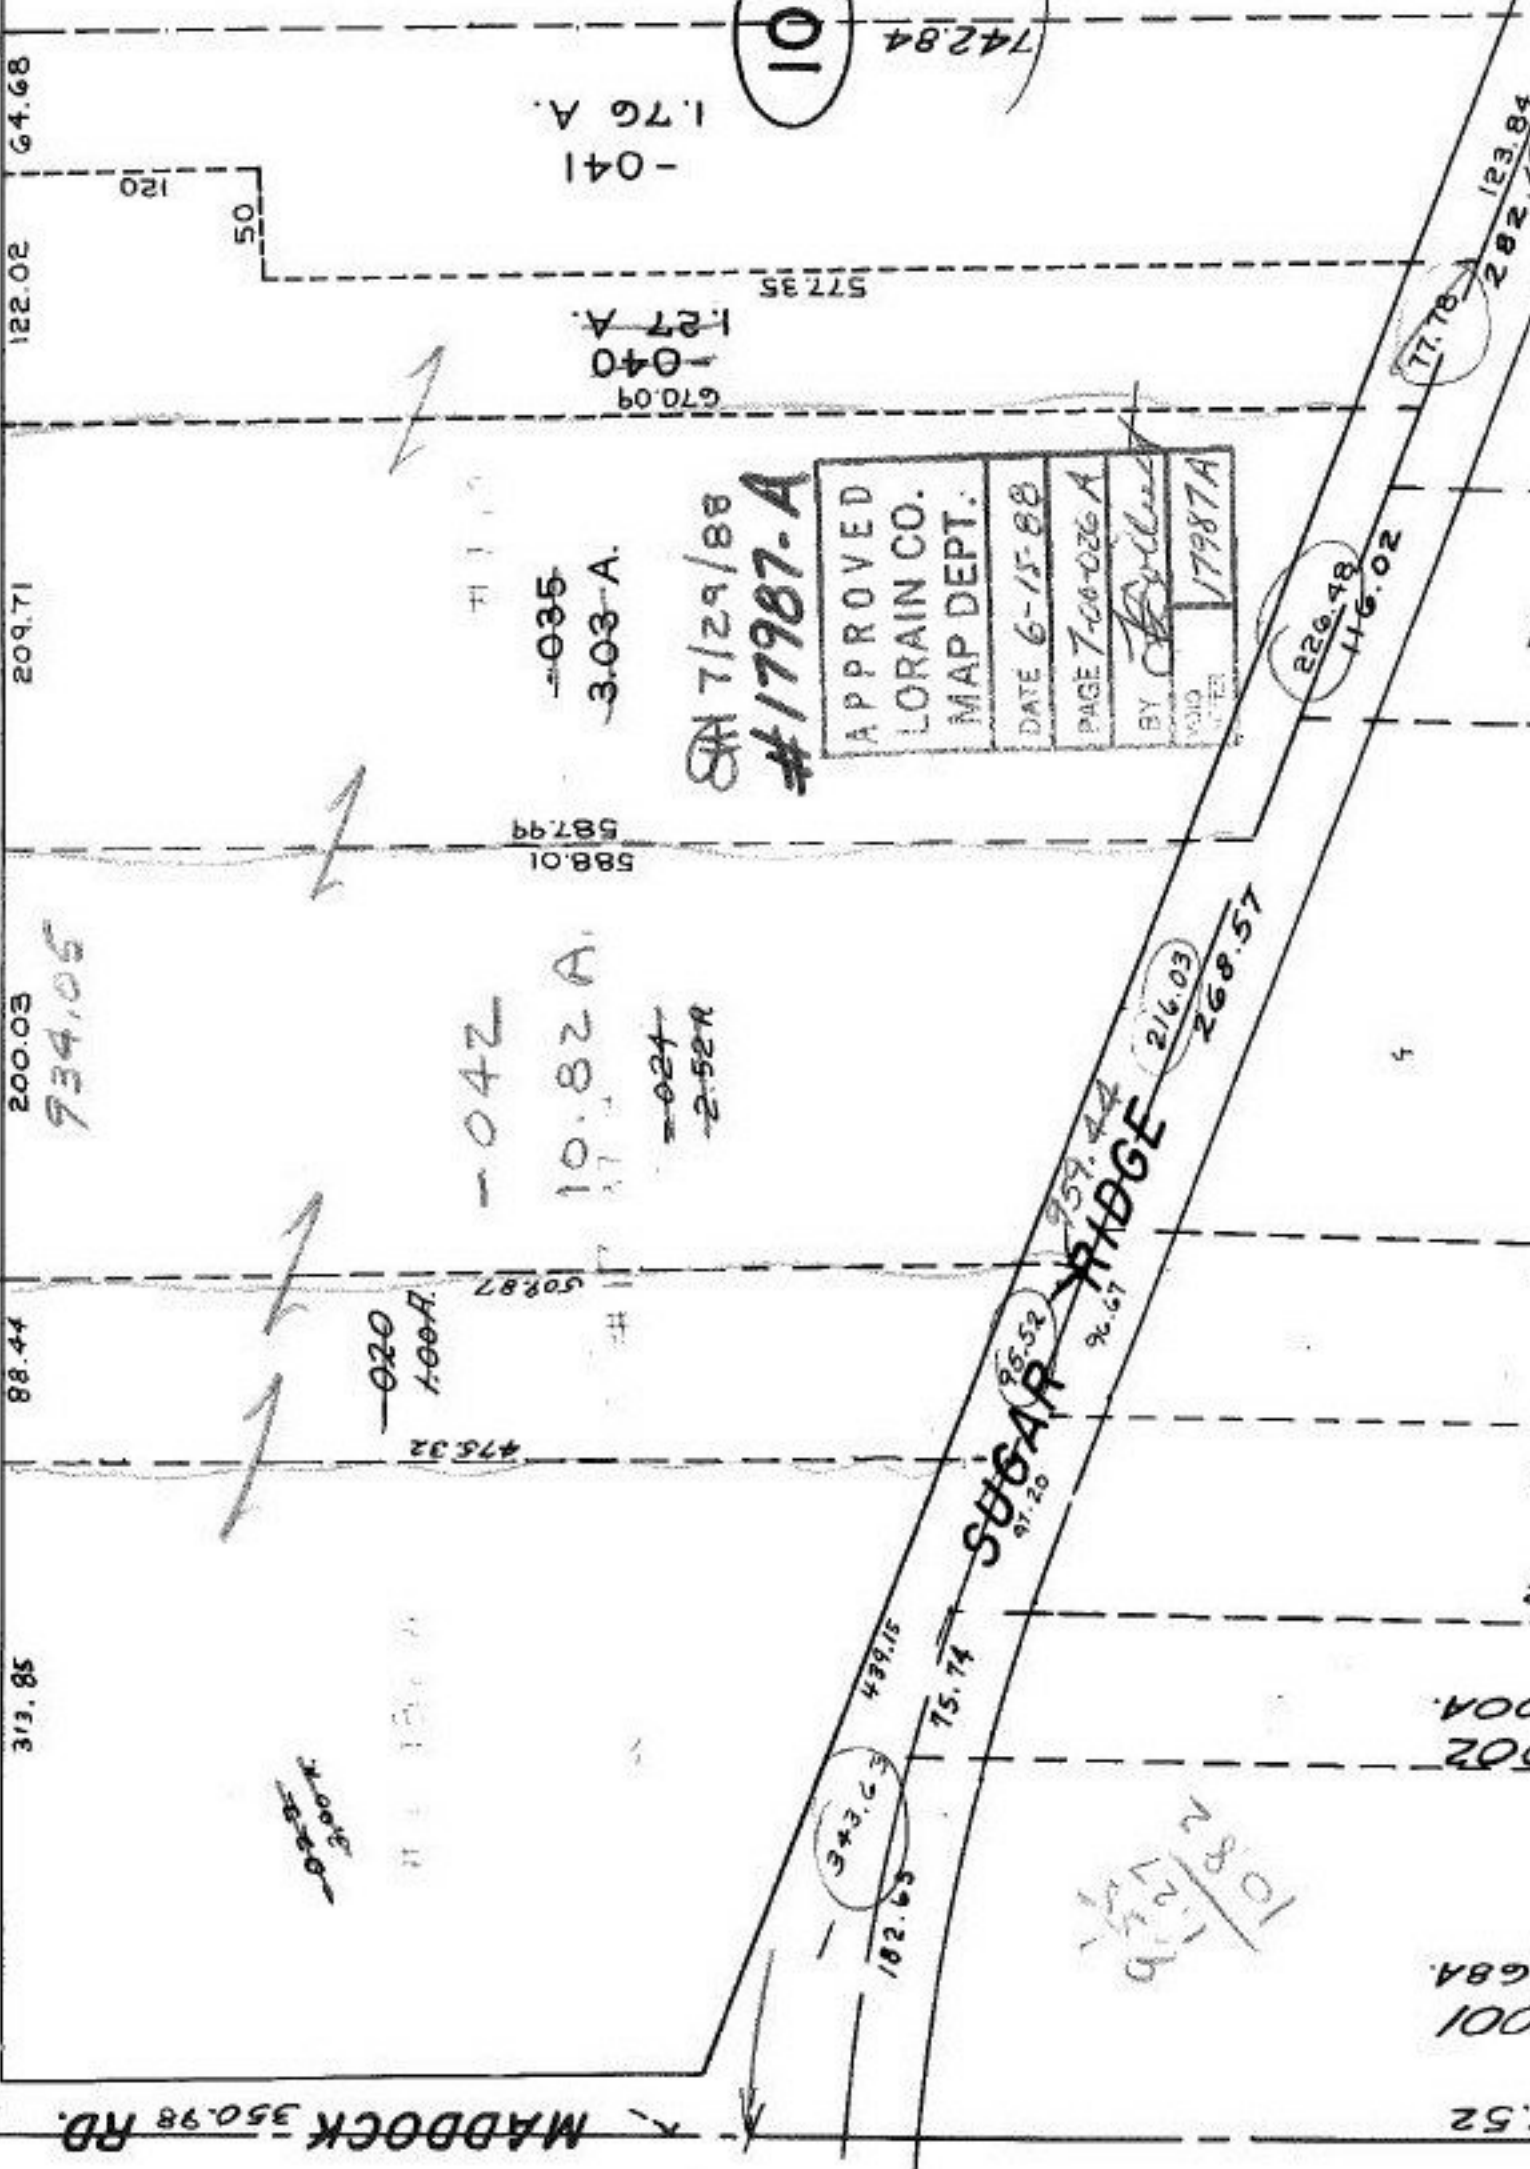

MADDOCK RD. 350.98

313.85

88.44

200.03

209.71

122.02

64.68

120

50

-041  
1.76 A.

670.09  
-040  
1.27 A.

-035  
3.03-A.

-042

10.82-A.

-024  
-2.52A

-020  
1.00A.

478.32

508.87

588.01  
587.99

SN 7/29/88  
#17987-A

APPROVED  
LORAIN CO.  
MAP DEPT.  
DATE 6-15-88  
PAGE 7-00-026 A  
BY *[Signature]*  
VOID AFTER 1/7987A

SUGAR HEDGE

75.74

489.15

182.63  
343.63

97.20  
95.52

96.67  
959.44

216.03

268.57

226.48  
116.02

177.78

123.84  
282.76

002

001

4.52

0.68A

101

742.84

101  
9.2  
1.2  
1.2