


SEE 5-00-017-B


-021
.73 A
403.62

110

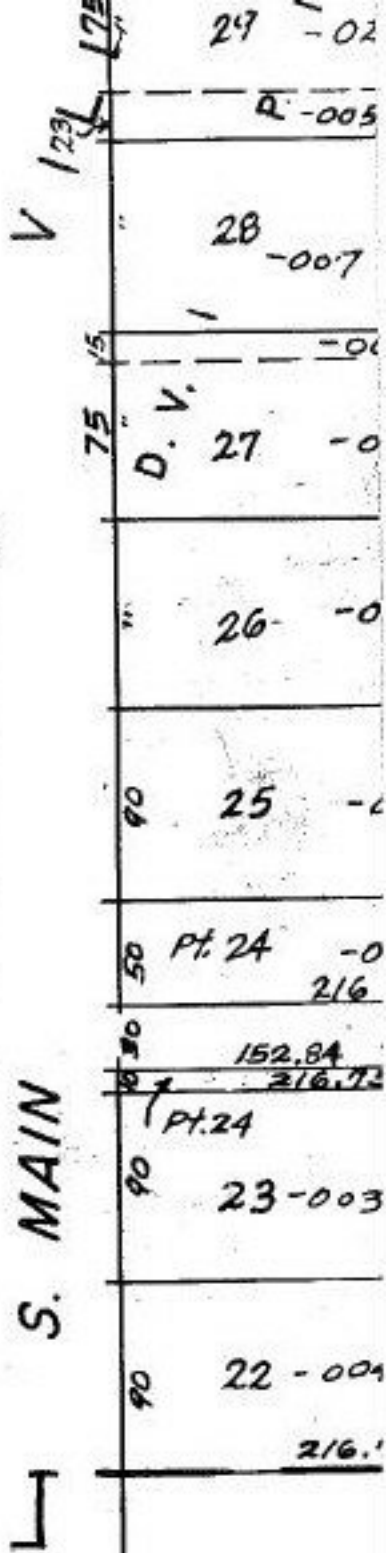

NAME CORR.
 Change J.C.
 BARNES ADD
 To: V2 P.7
 J.C. BARNEYS ADD
 -026 V.2 P7
 3.53A.

MAP CORR.

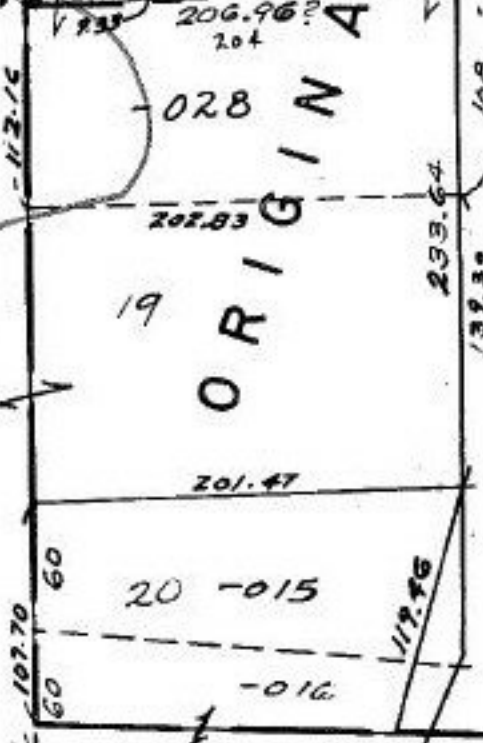

116

7/5/88

ELIASHA A.

APPROVED

FOR THE

MARY DEPT.

JUNE 6 - 24 88

PAGES 00-024 A

17988 A