

INDEPENDENCE  
VOL. 3

BLOCK C

- 049  
5.43 A.

MAP CORR.

Add To  
TAX MAP

Sub No. 3

-050  
1.84 A.


WASHKA

05-00-041-102-013  
91A

LN. 630.00

INTERSTATE 54

KANE VALLEY

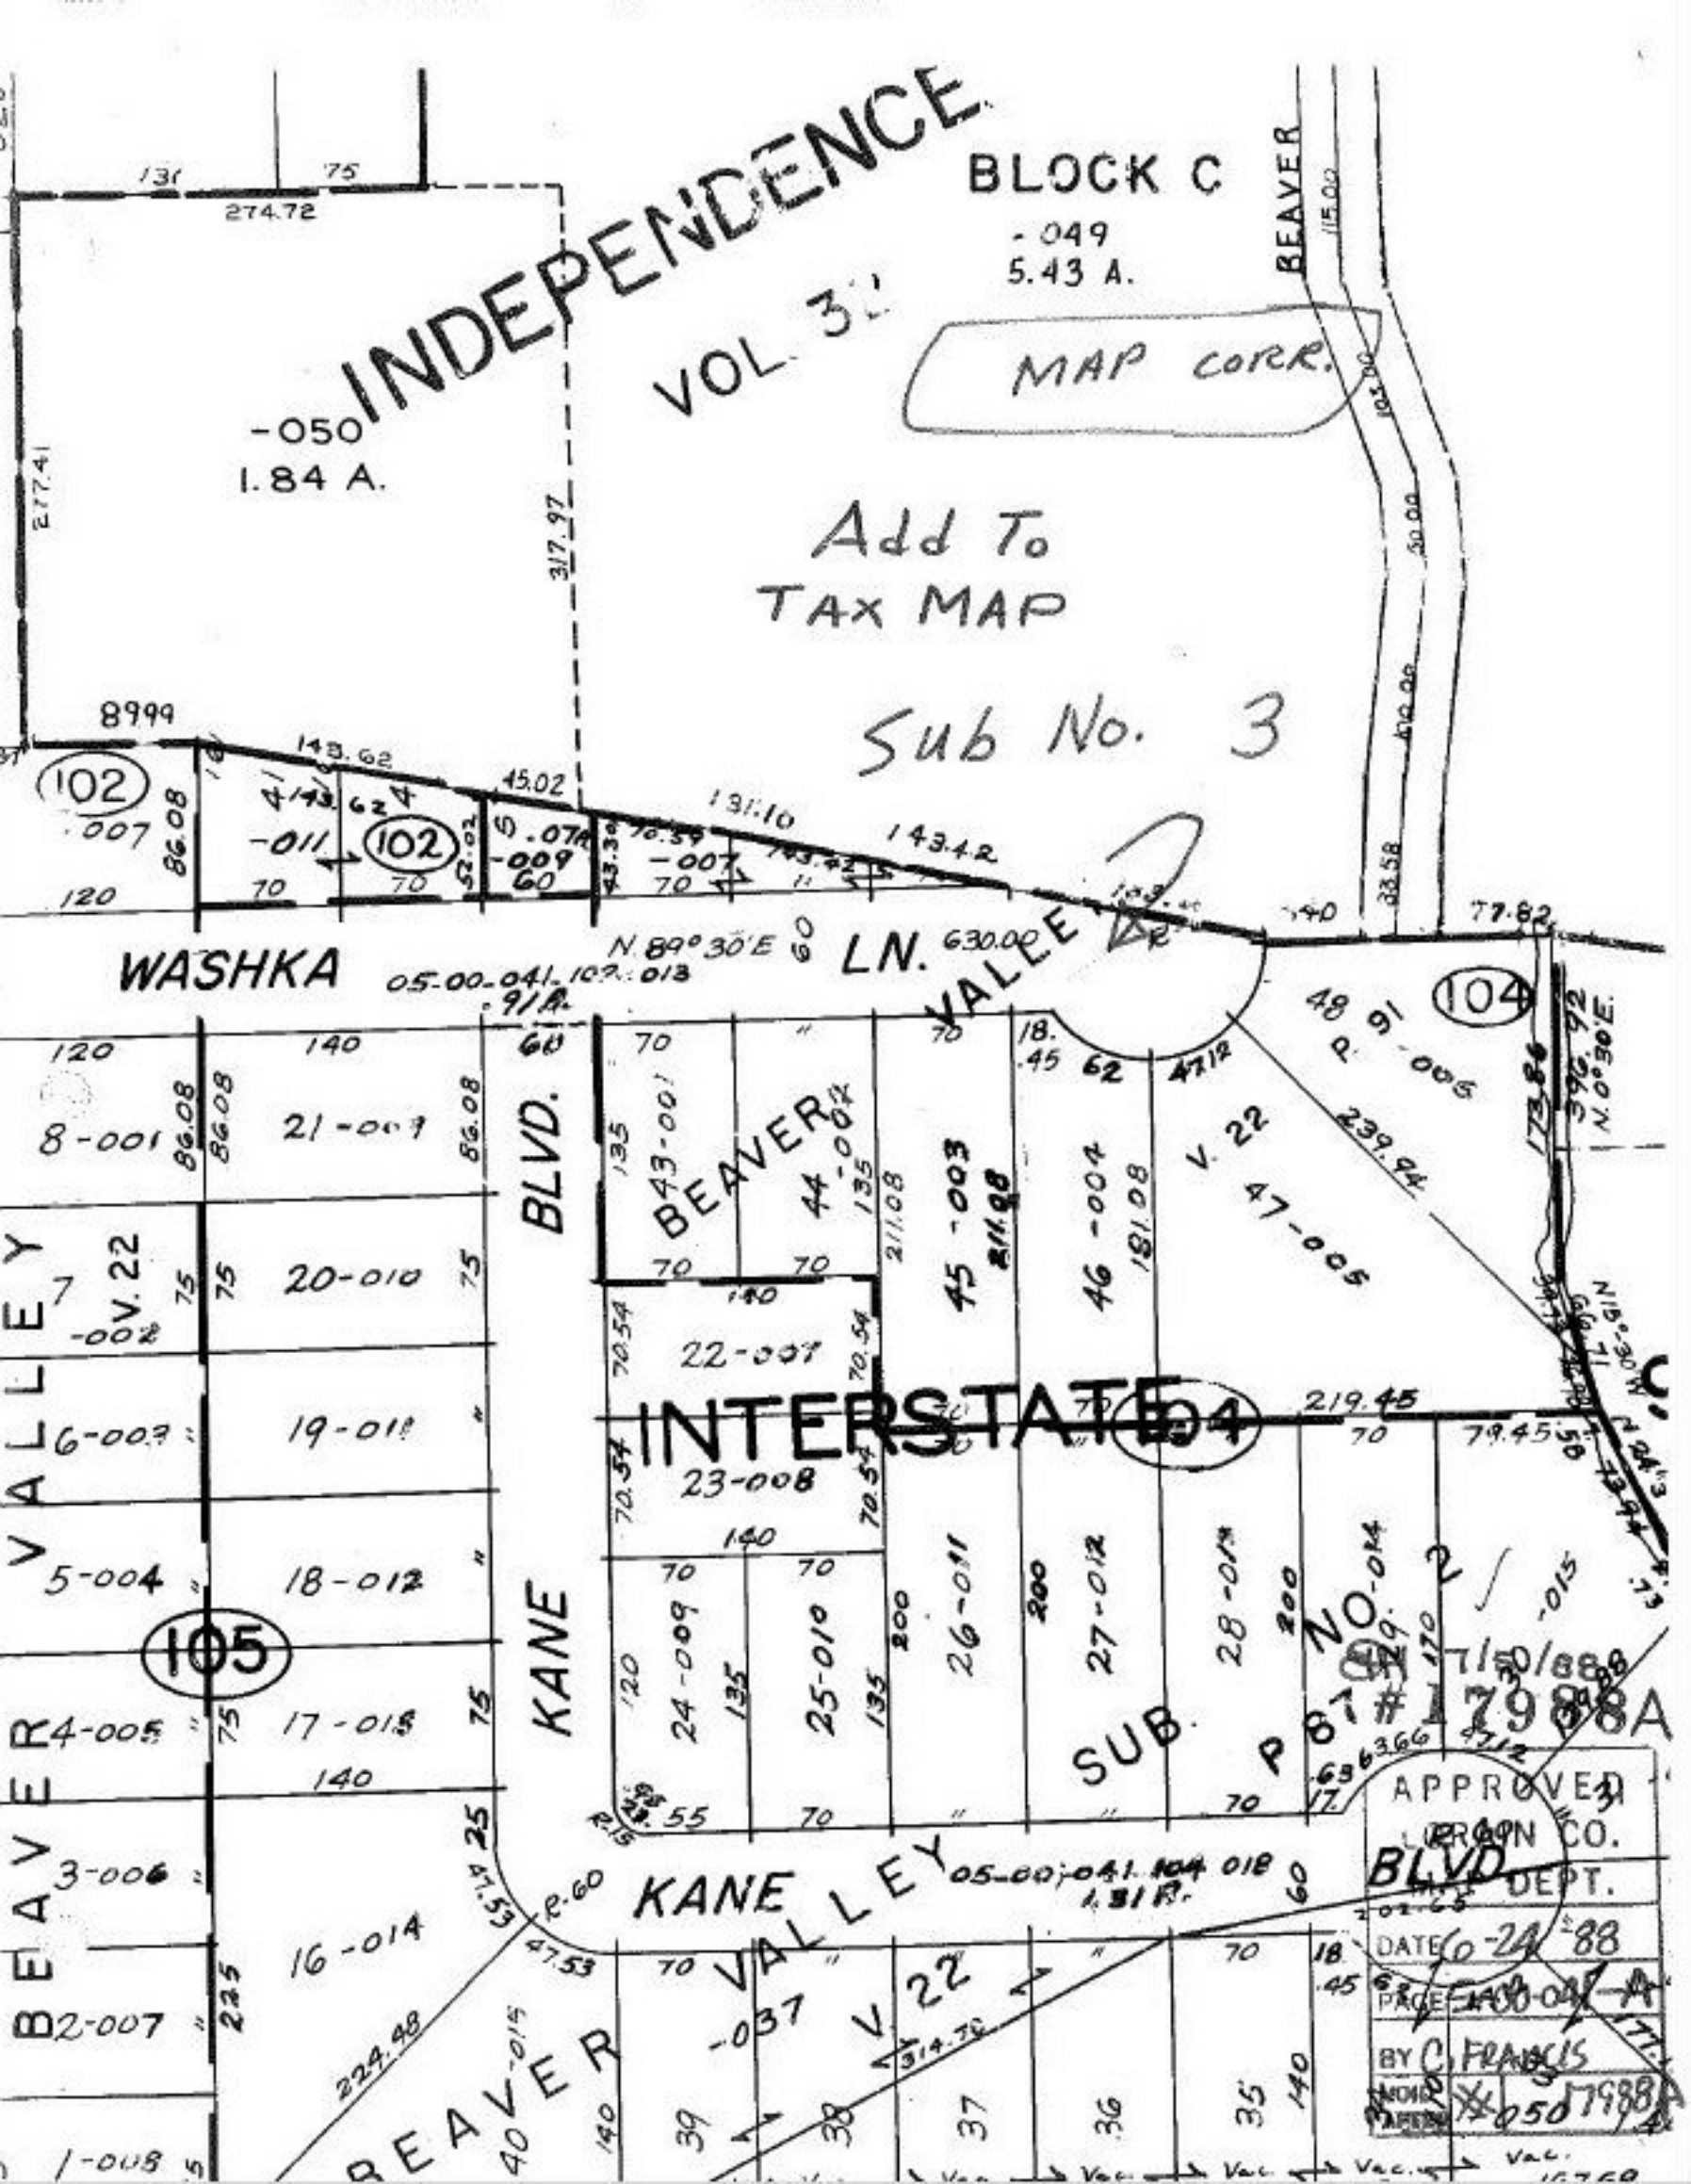

APPROVED  
LERRON CO.  
BLVD DEPT.  
DATE 6-24-88  
PAGE 100-04-A  
BY C. FRANCIS  
MONO X 0507988