


SEE 12-00-043-A

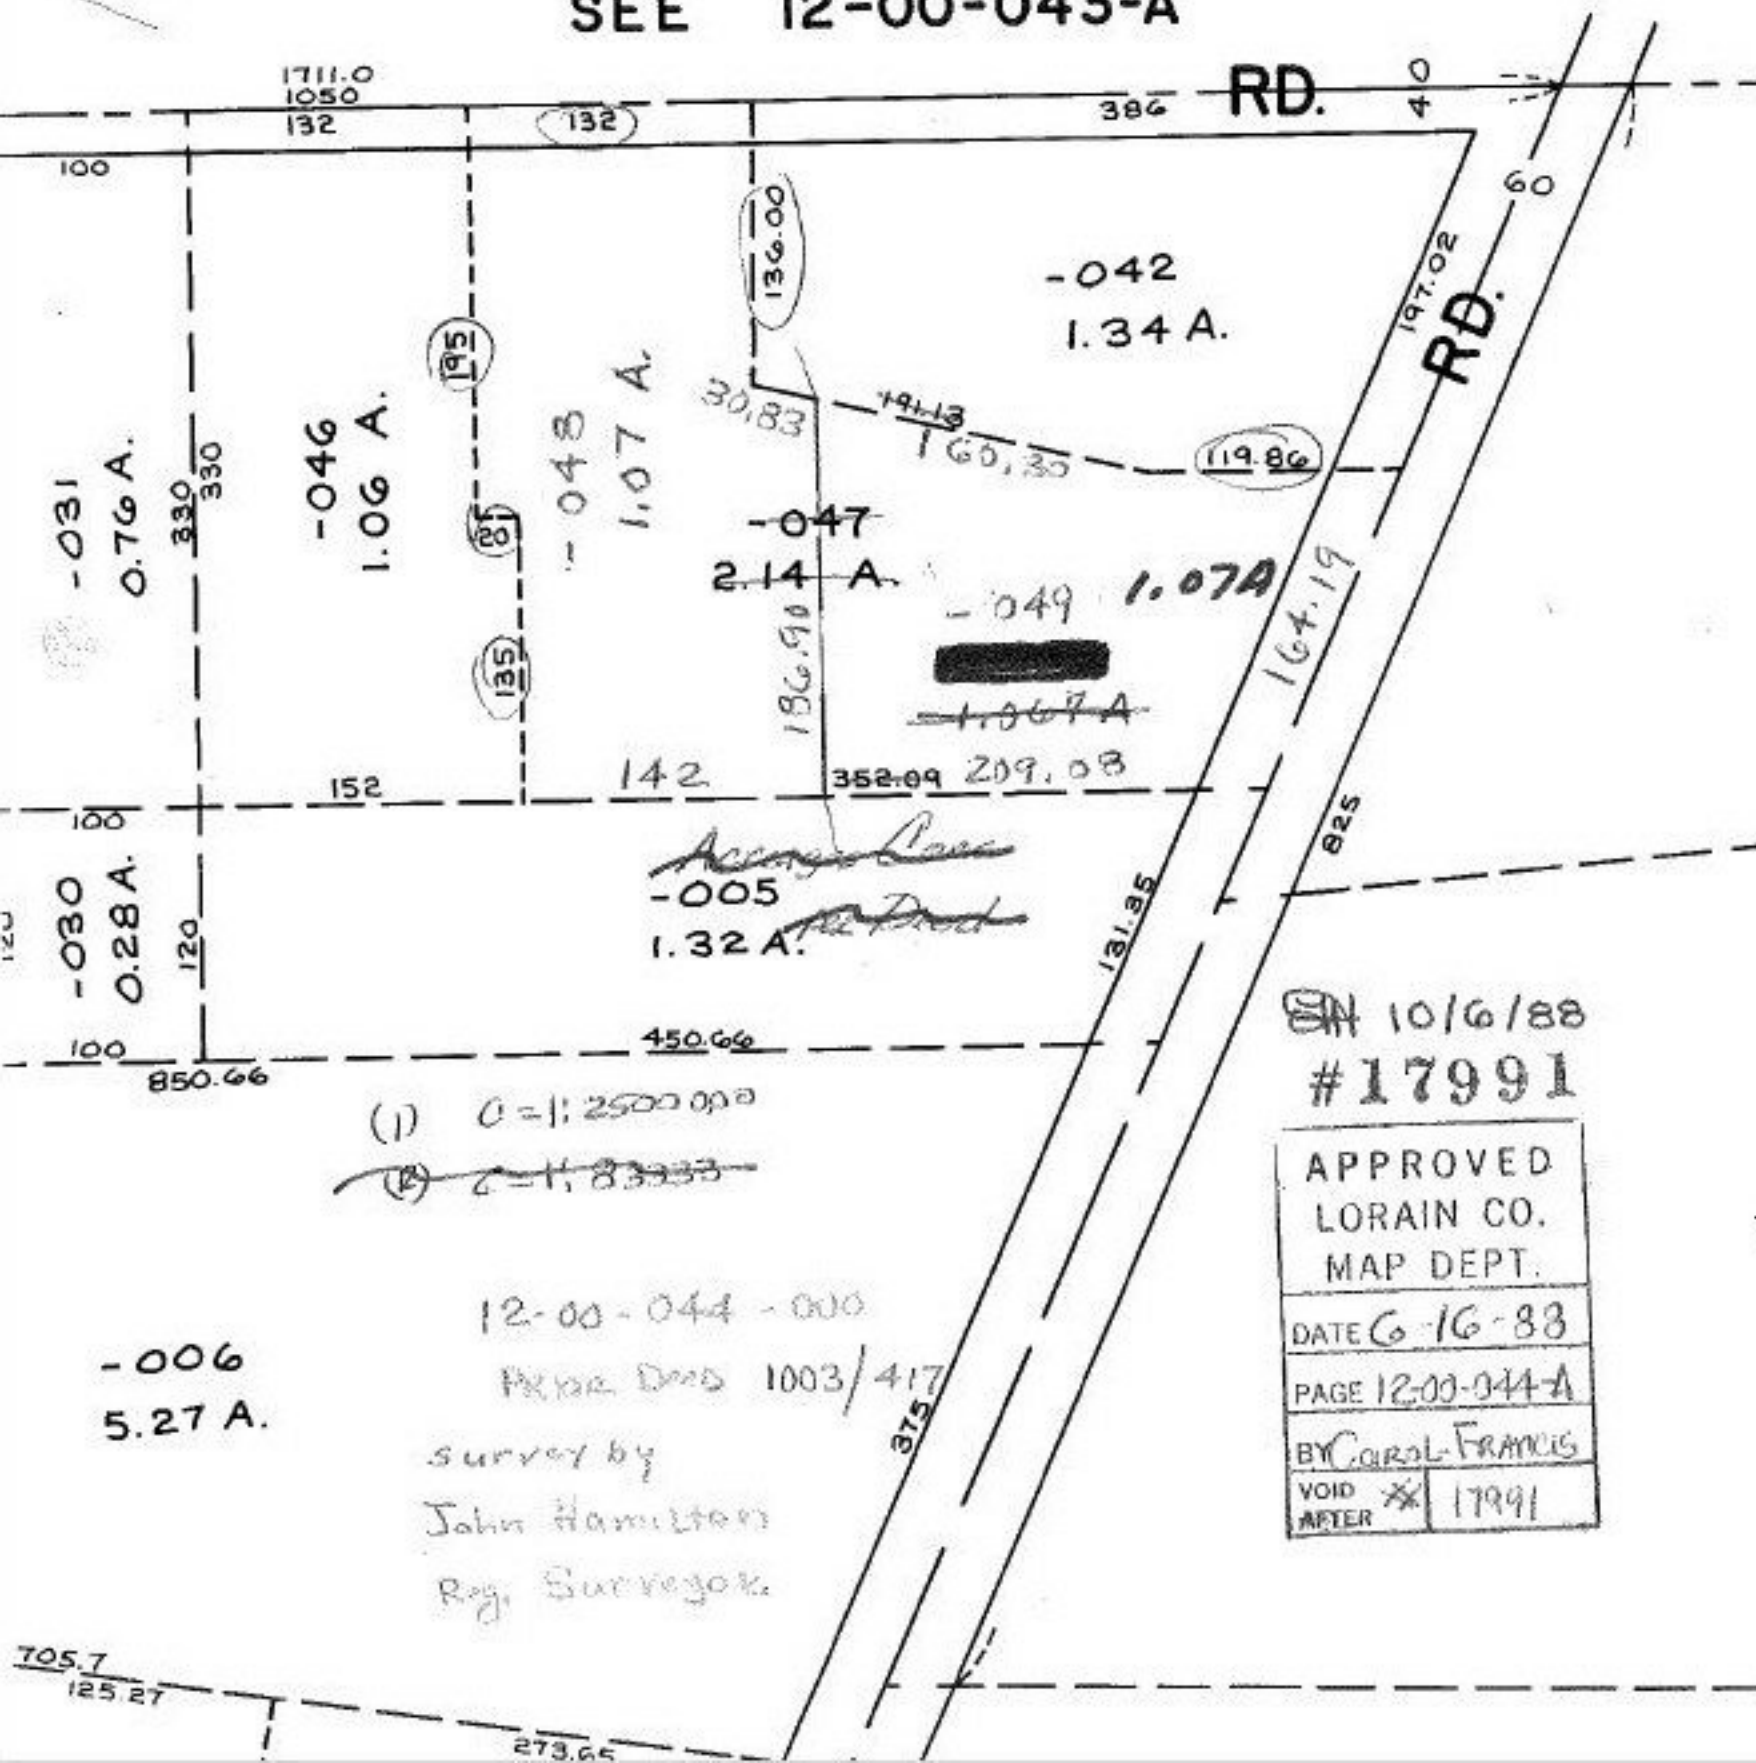

(1) 1" = 2500' 000
~~(2) 1" = 833.33'~~

12-00-044-000
 Plat Dwd 1003/417

Survey by
 John Hamilton
 Reg. Surveyor.

10/6/88
 #17991

APPROVED LORAIN CO. MAP DEPT.	
DATE 6-16-88	
PAGE 12-00-044-A	
BY CAROL FRANCIS	
VOID AFTER	* 17991