


WEBSTER

RD.

(60)

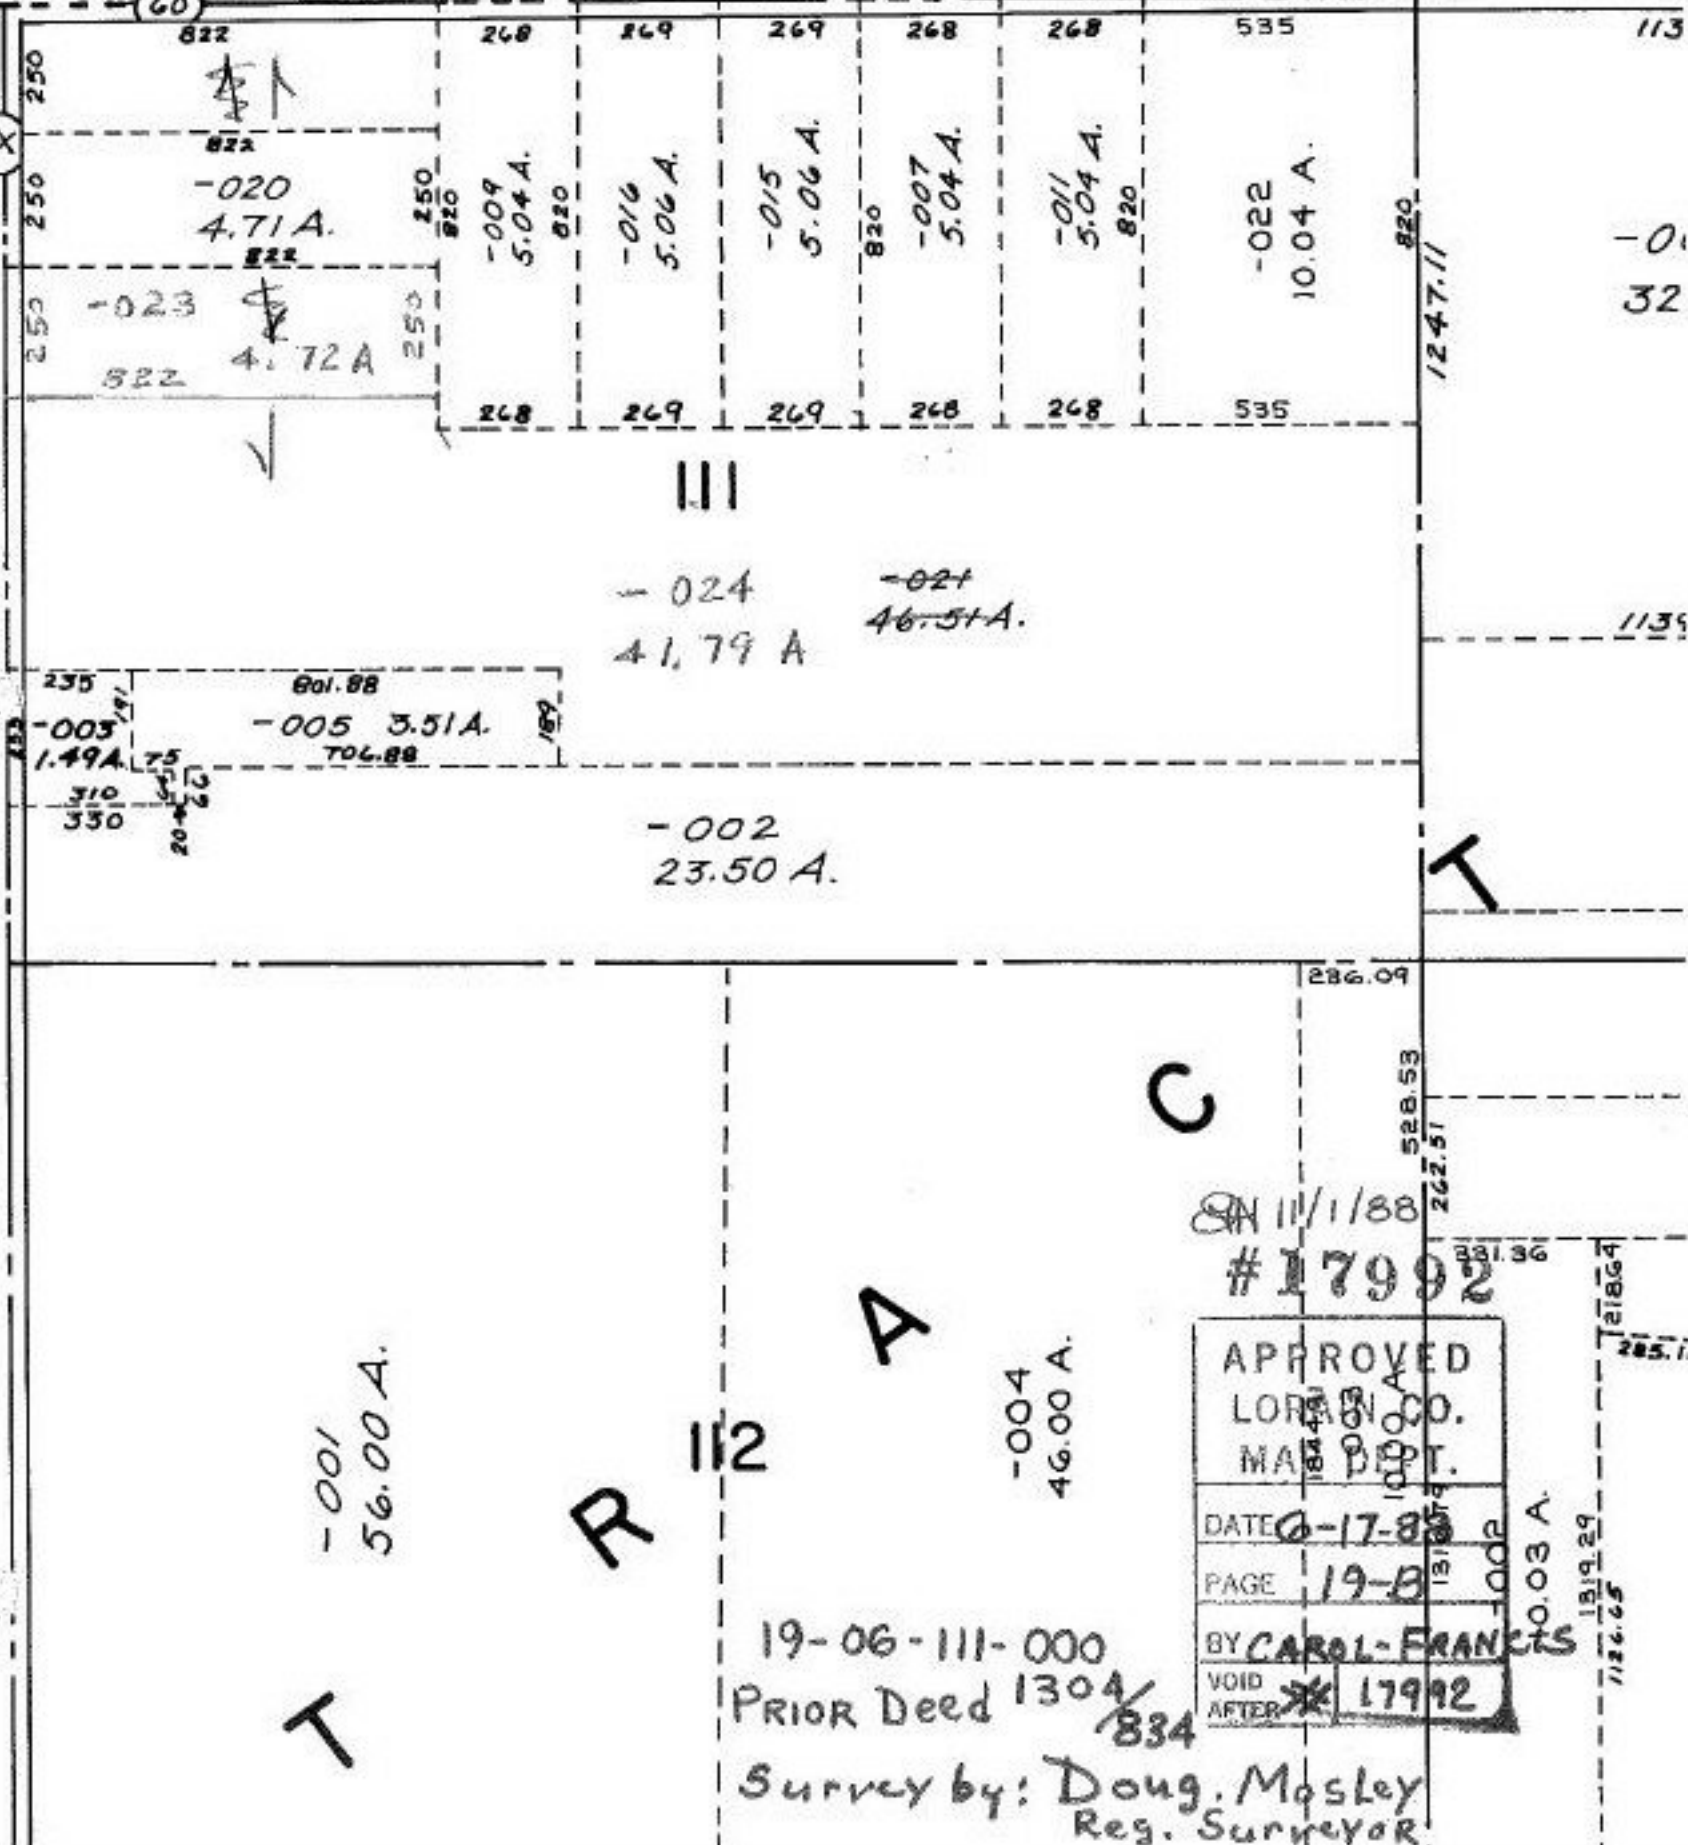

-024 41.79 A. -021 46.51 A.

-002 23.50 A.

-001 56.00 A.

-004 46.00 A.

ON 11/1/88
#17992

APPROVED	
LORDEN CO.	
MAINT. DEPT.	
DATE	10-17-85
PAGE	19-B
BY	CAROL-FRANCIS
VOID AFTER	* 17992

19-06-111-000
Prior Deed 1304/834

Survey by: Doug. Mosley
Reg. Surveyor.

T

R

112

A

C

T

-0.32

1135

285.7

1247.11

286.09

528.53

262.51

331.36

100.03 A

1319.29

1126.65

822

268

269

269

268

268

535

113

822

250
820

-009 5.04 A.

-016 5.06 A.

-015 5.06 A.

-007 5.04 A.

-011 5.04 A.

-022 10.04 A.

820

-023

4.72 A

250

268

269

269

268

268

535

235

601.88

-005 3.51 A.

1.49 A

310
330

20.4
25

-002

23.50 A.

169

286.09

528.53

262.51

331.36

100.03 A

1319.29

1126.65