


4015 120	4016-025 120.02	4017-044 120.02	4018-043 120	4059-024 120	4060-025 120.02	4062-044 120	4061-045 120.02
39	39	39	39	39	39	39	39
30	30	30	30	30	30	30	30

19th 435.60

House Numbers  
Should be checked in the field

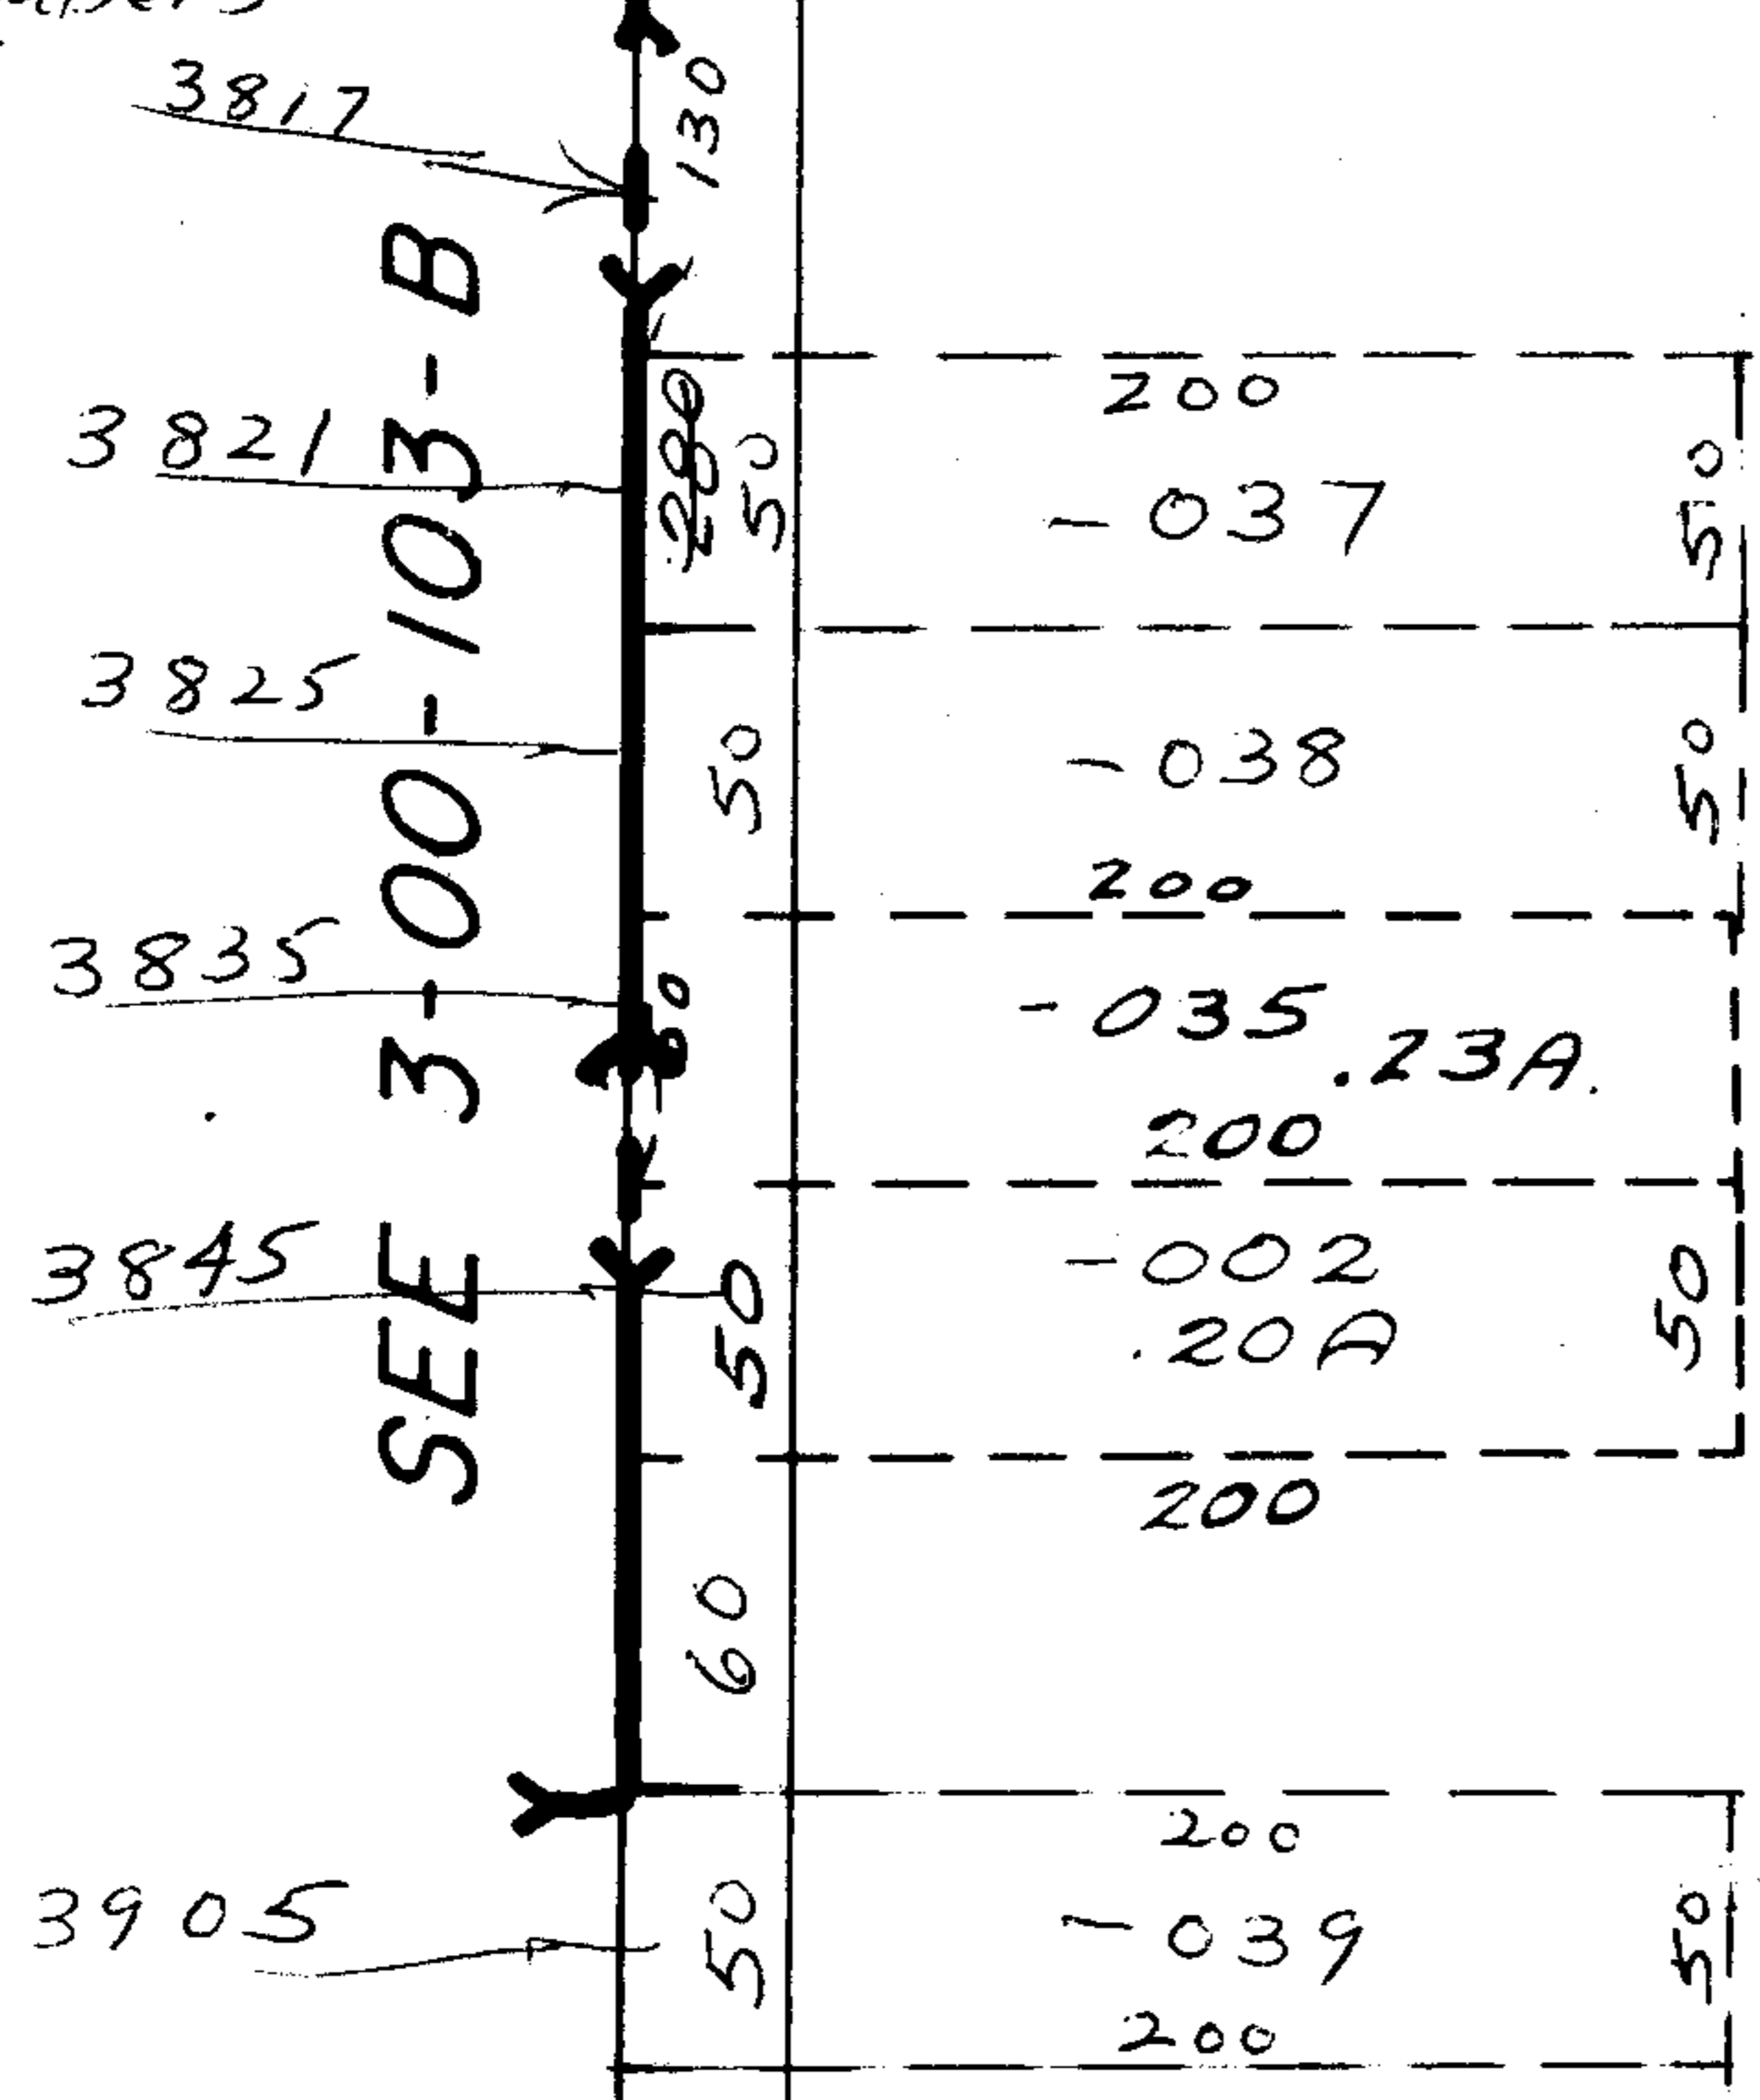


~~036~~ -040  
7.08A. 6.39A.

#1800  
**APPROVED**  
**LORAIN CO.**  
**MAP DEPT.**  
DATE 5-24-68  
3-00-102-A  
BY *D. Mays*

DA R7/29/86

DALLAS

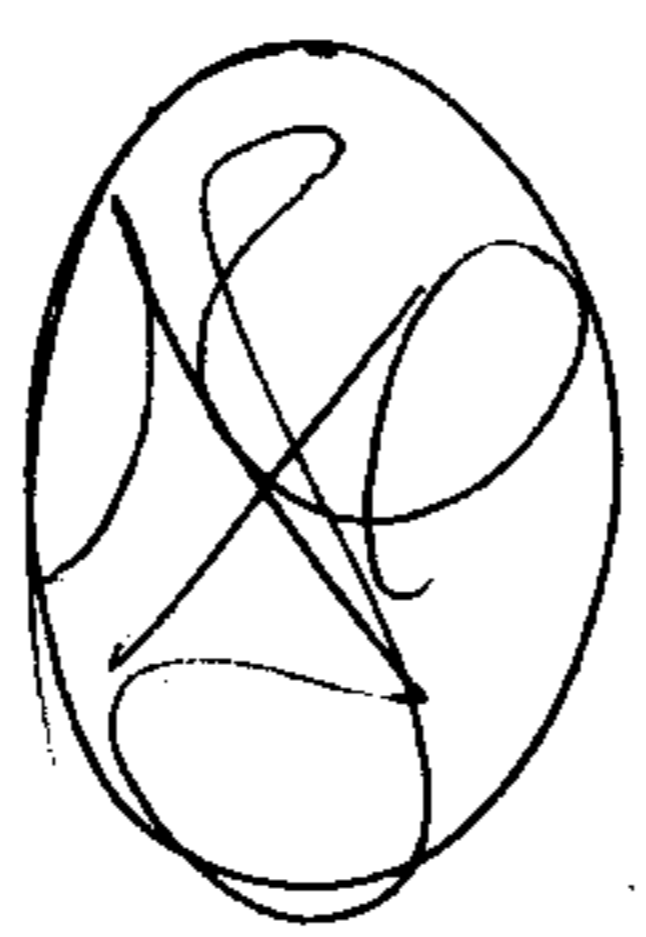

115

60  
30  
915.50

435.55

245.31

-003  
3.22A.

55

88

Done 7-6-68

-004 L W Hall

794.13

-009  
4.49A

24