


ISLAND

SEE 7-00-013-C

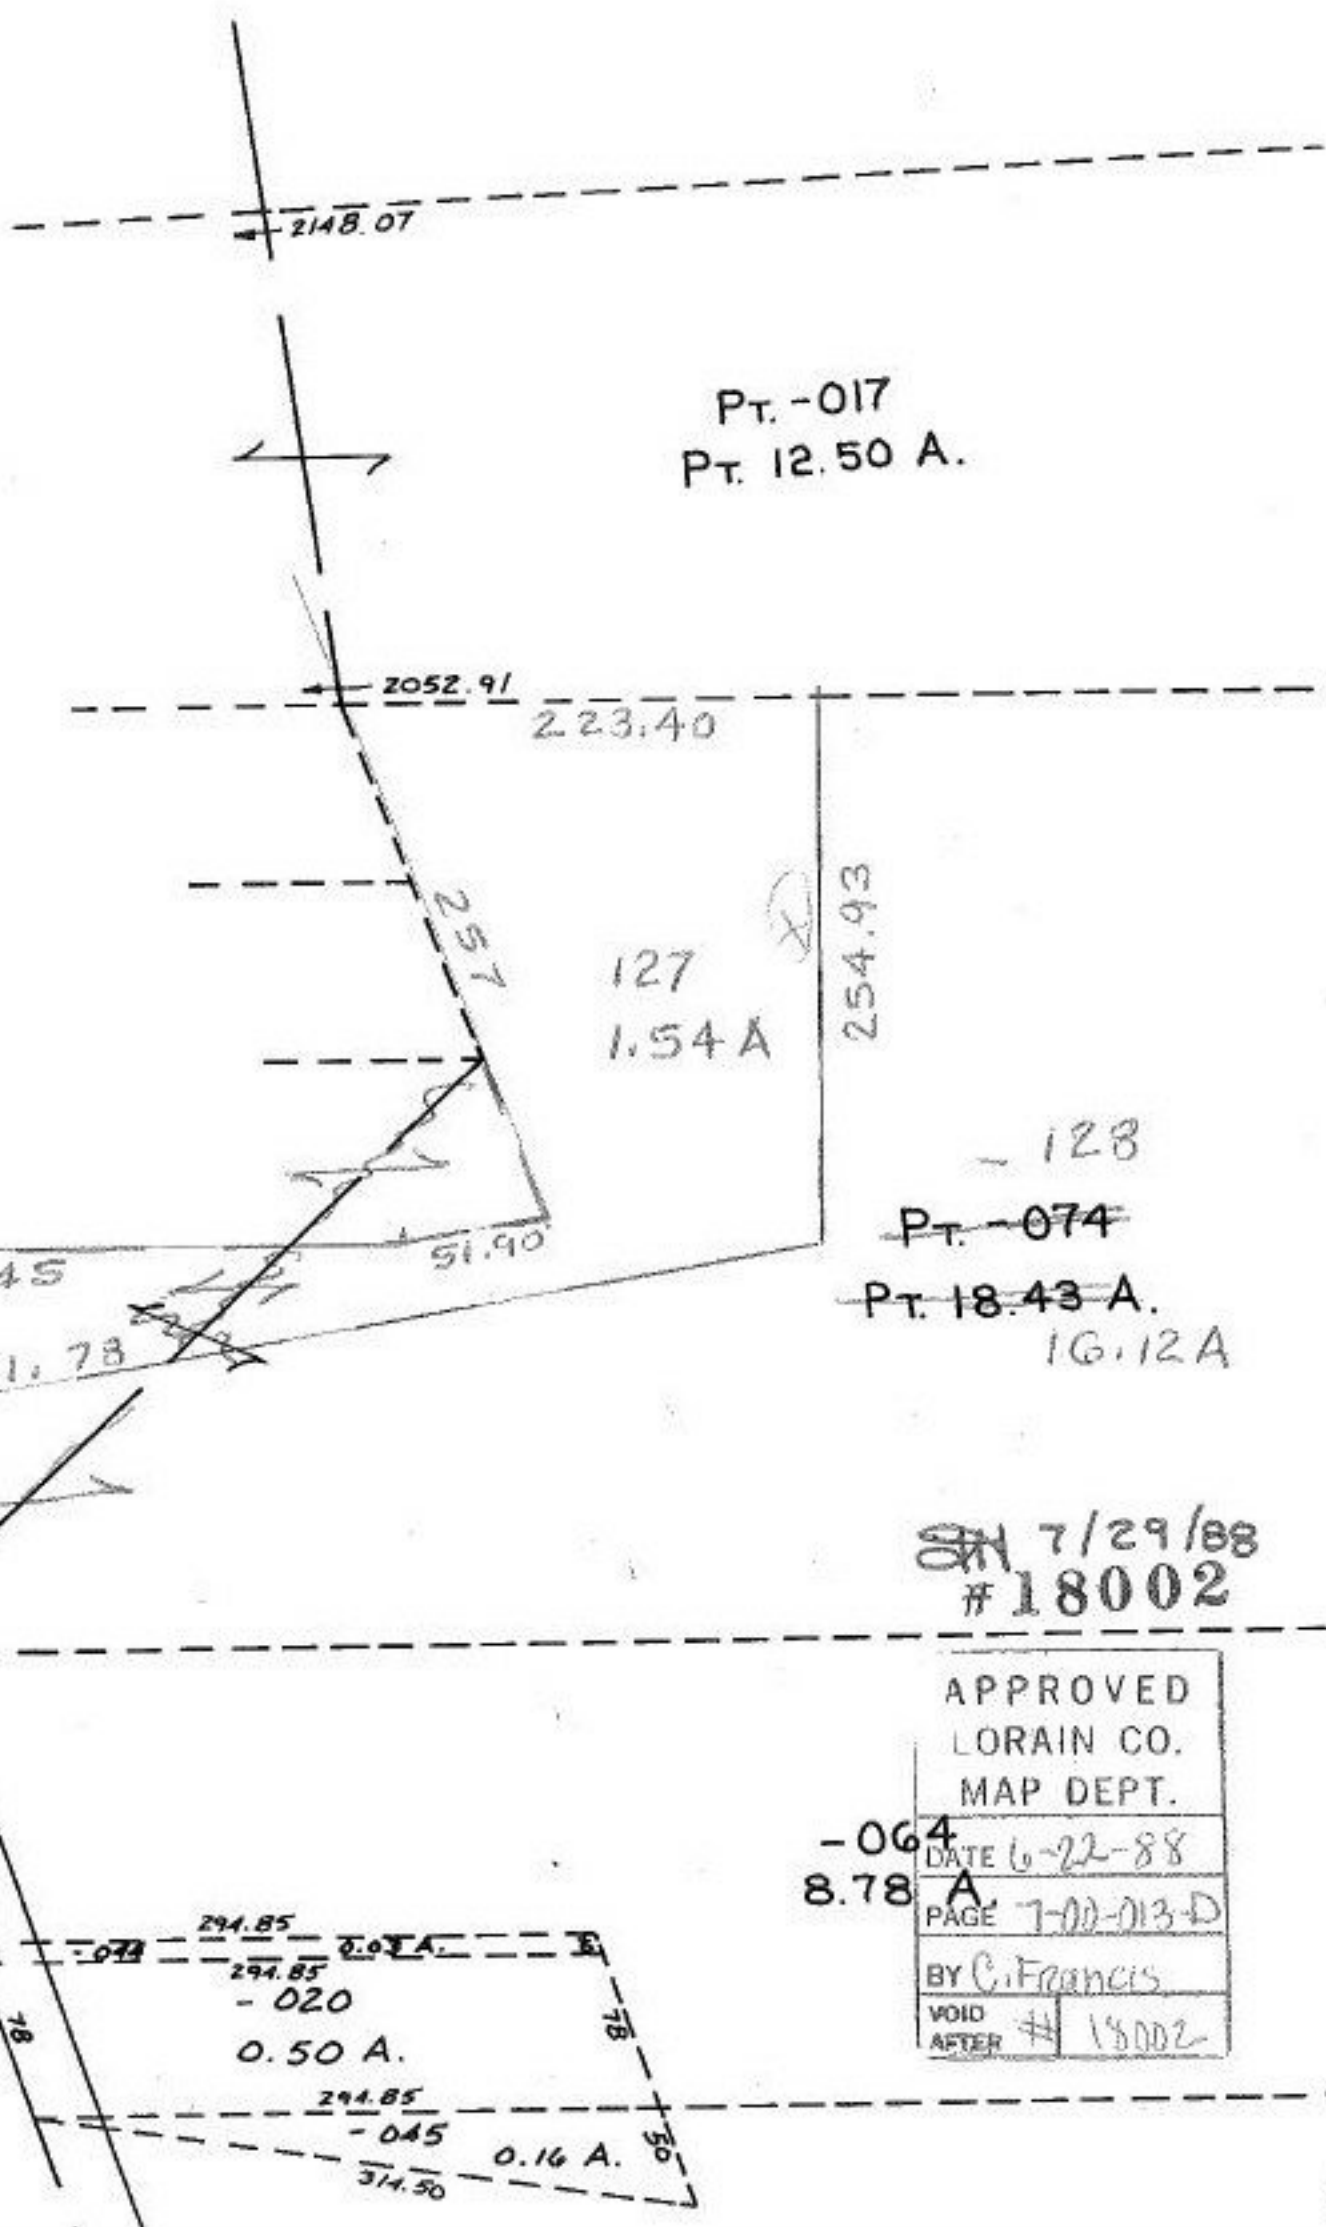

PT. -017
PT. 12.50 A.

127
1.54 A

254.93

128
~~PT. -074~~
~~PT. 18.43 A.~~
16.12 A

SN 7/29/88
18002

APPROVED
LORAIN CO.
MAP DEPT.
-064 DATE 6-22-88
8.78 PAGE 7-00-013-D
BY C. Francis
VOID AFTER # 18002

294.85
-020
0.50 A.

294.85
-045
0.16 A.
314.50