


-049
22.29 A.

~~-061~~
~~18.91 A.~~

-063
17.82 A.

SEE SURVEY MAP BY
WH. BARTON
CL. 13 INF
PRIOR DEED 1353/284

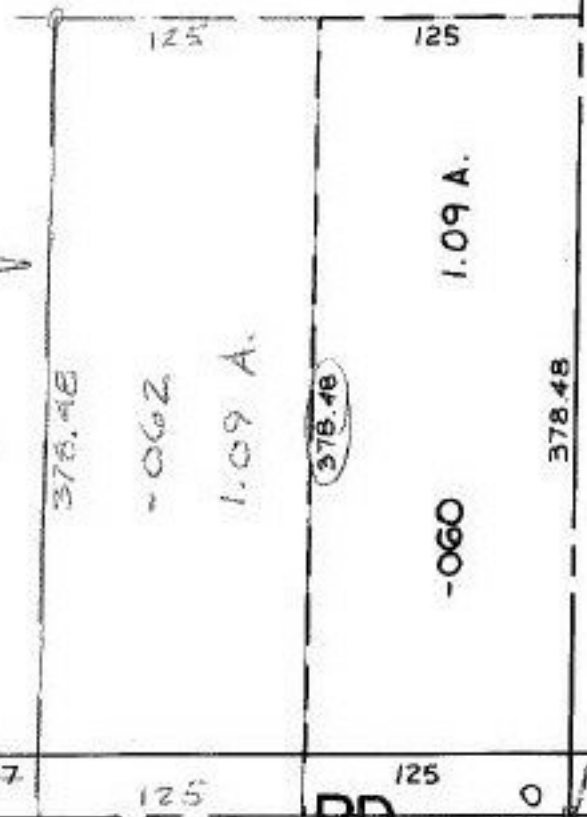

SEE 12-A

309.47	18.91
125.00	1.09
184.47	17.82

RD 1816/88
#18020

APPROVED LORAIN CO. MAP DEPT.	
DATE 7-7-88	
PAGE 12-00-082 (3)	
BY T. McMan	
VOID AFTER	18020