

14.48
0.29
14.19

Rocky

Lot 3


#18021

~~-030~~


~~14.48 A.~~

~~-032~~

14.19 A.

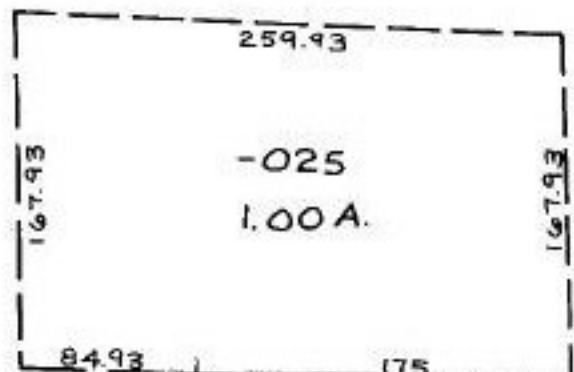

SEE SURVY MAP
HARDNER & ASSOC.
ET AL INF.
PRIOR DEED 1321/756

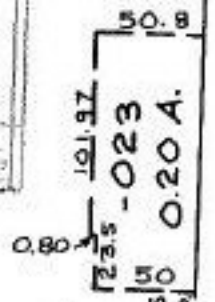

SEE 12-00-046-B

483.55

RD. 10/6/88

#18021

APPROVED
LORAIN CO.
MAP DEPT.
DATE 7-7-88
PAGE 12-00-045-B
BY T. Moran
VOID AFTER 18021