


14.48  
0.29  
14.19

ROCKY

Lot 3

#130-1  
~~030~~  
~~14.48 A.~~  
-032  
14.19 A.

SEE SURVEY MAP  
HAPONEK & ASSOC.  
CL. 1: INF.  
PRIOR DECD 1321/756

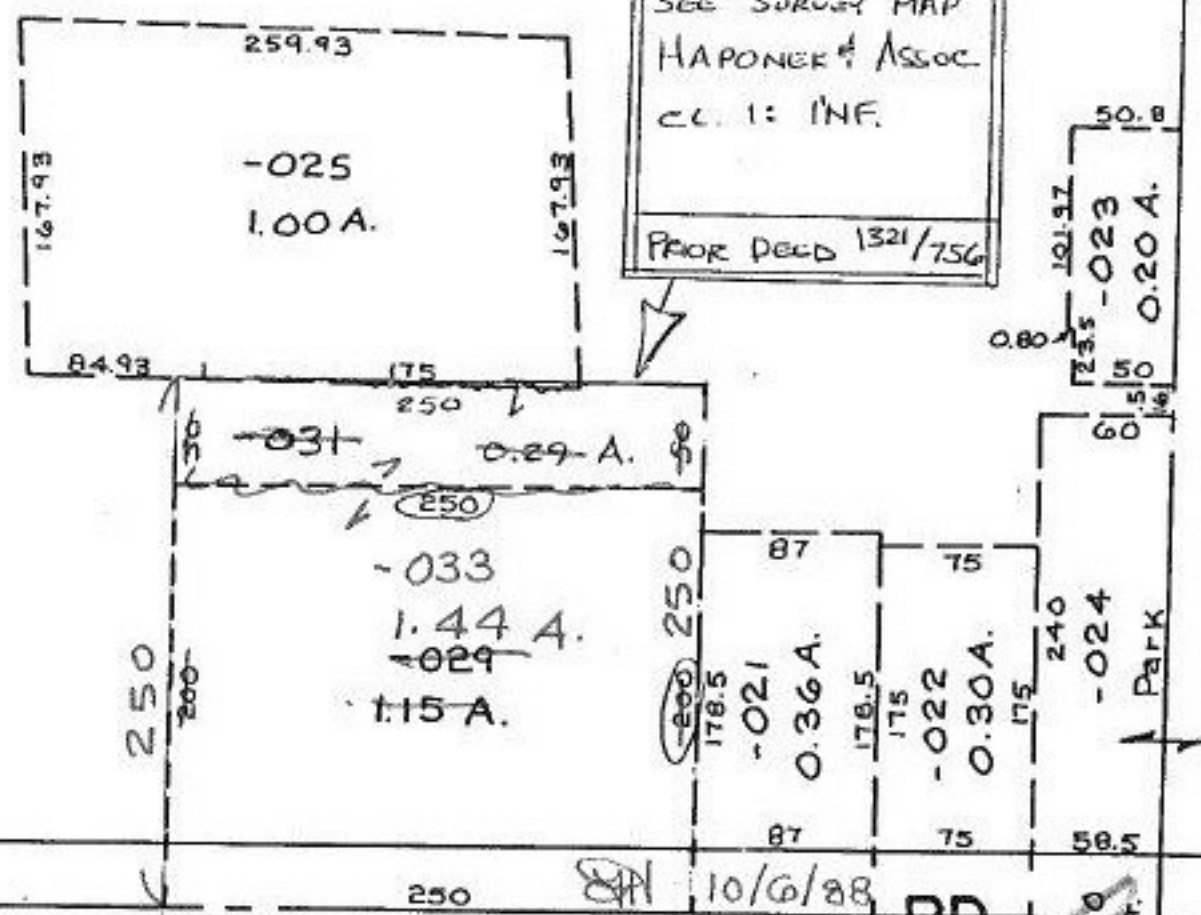

82

SEE 12-00-046-B #18025A RD. #18021

12-00-045-000-

COMBINATION

APPROVED  
LORAIN CO.  
MAP DEPT.  
DATE 7-15-88  
PAGE 12-00-045B  
BY CAROL FRANCIS  
VOID AFTER #18025A

APPROVED  
LORAIN CO.  
MAP DEPT.  
DATE 7-7-88  
PAGE 12-00-045B  
BY F. McMan