


SEE II-A

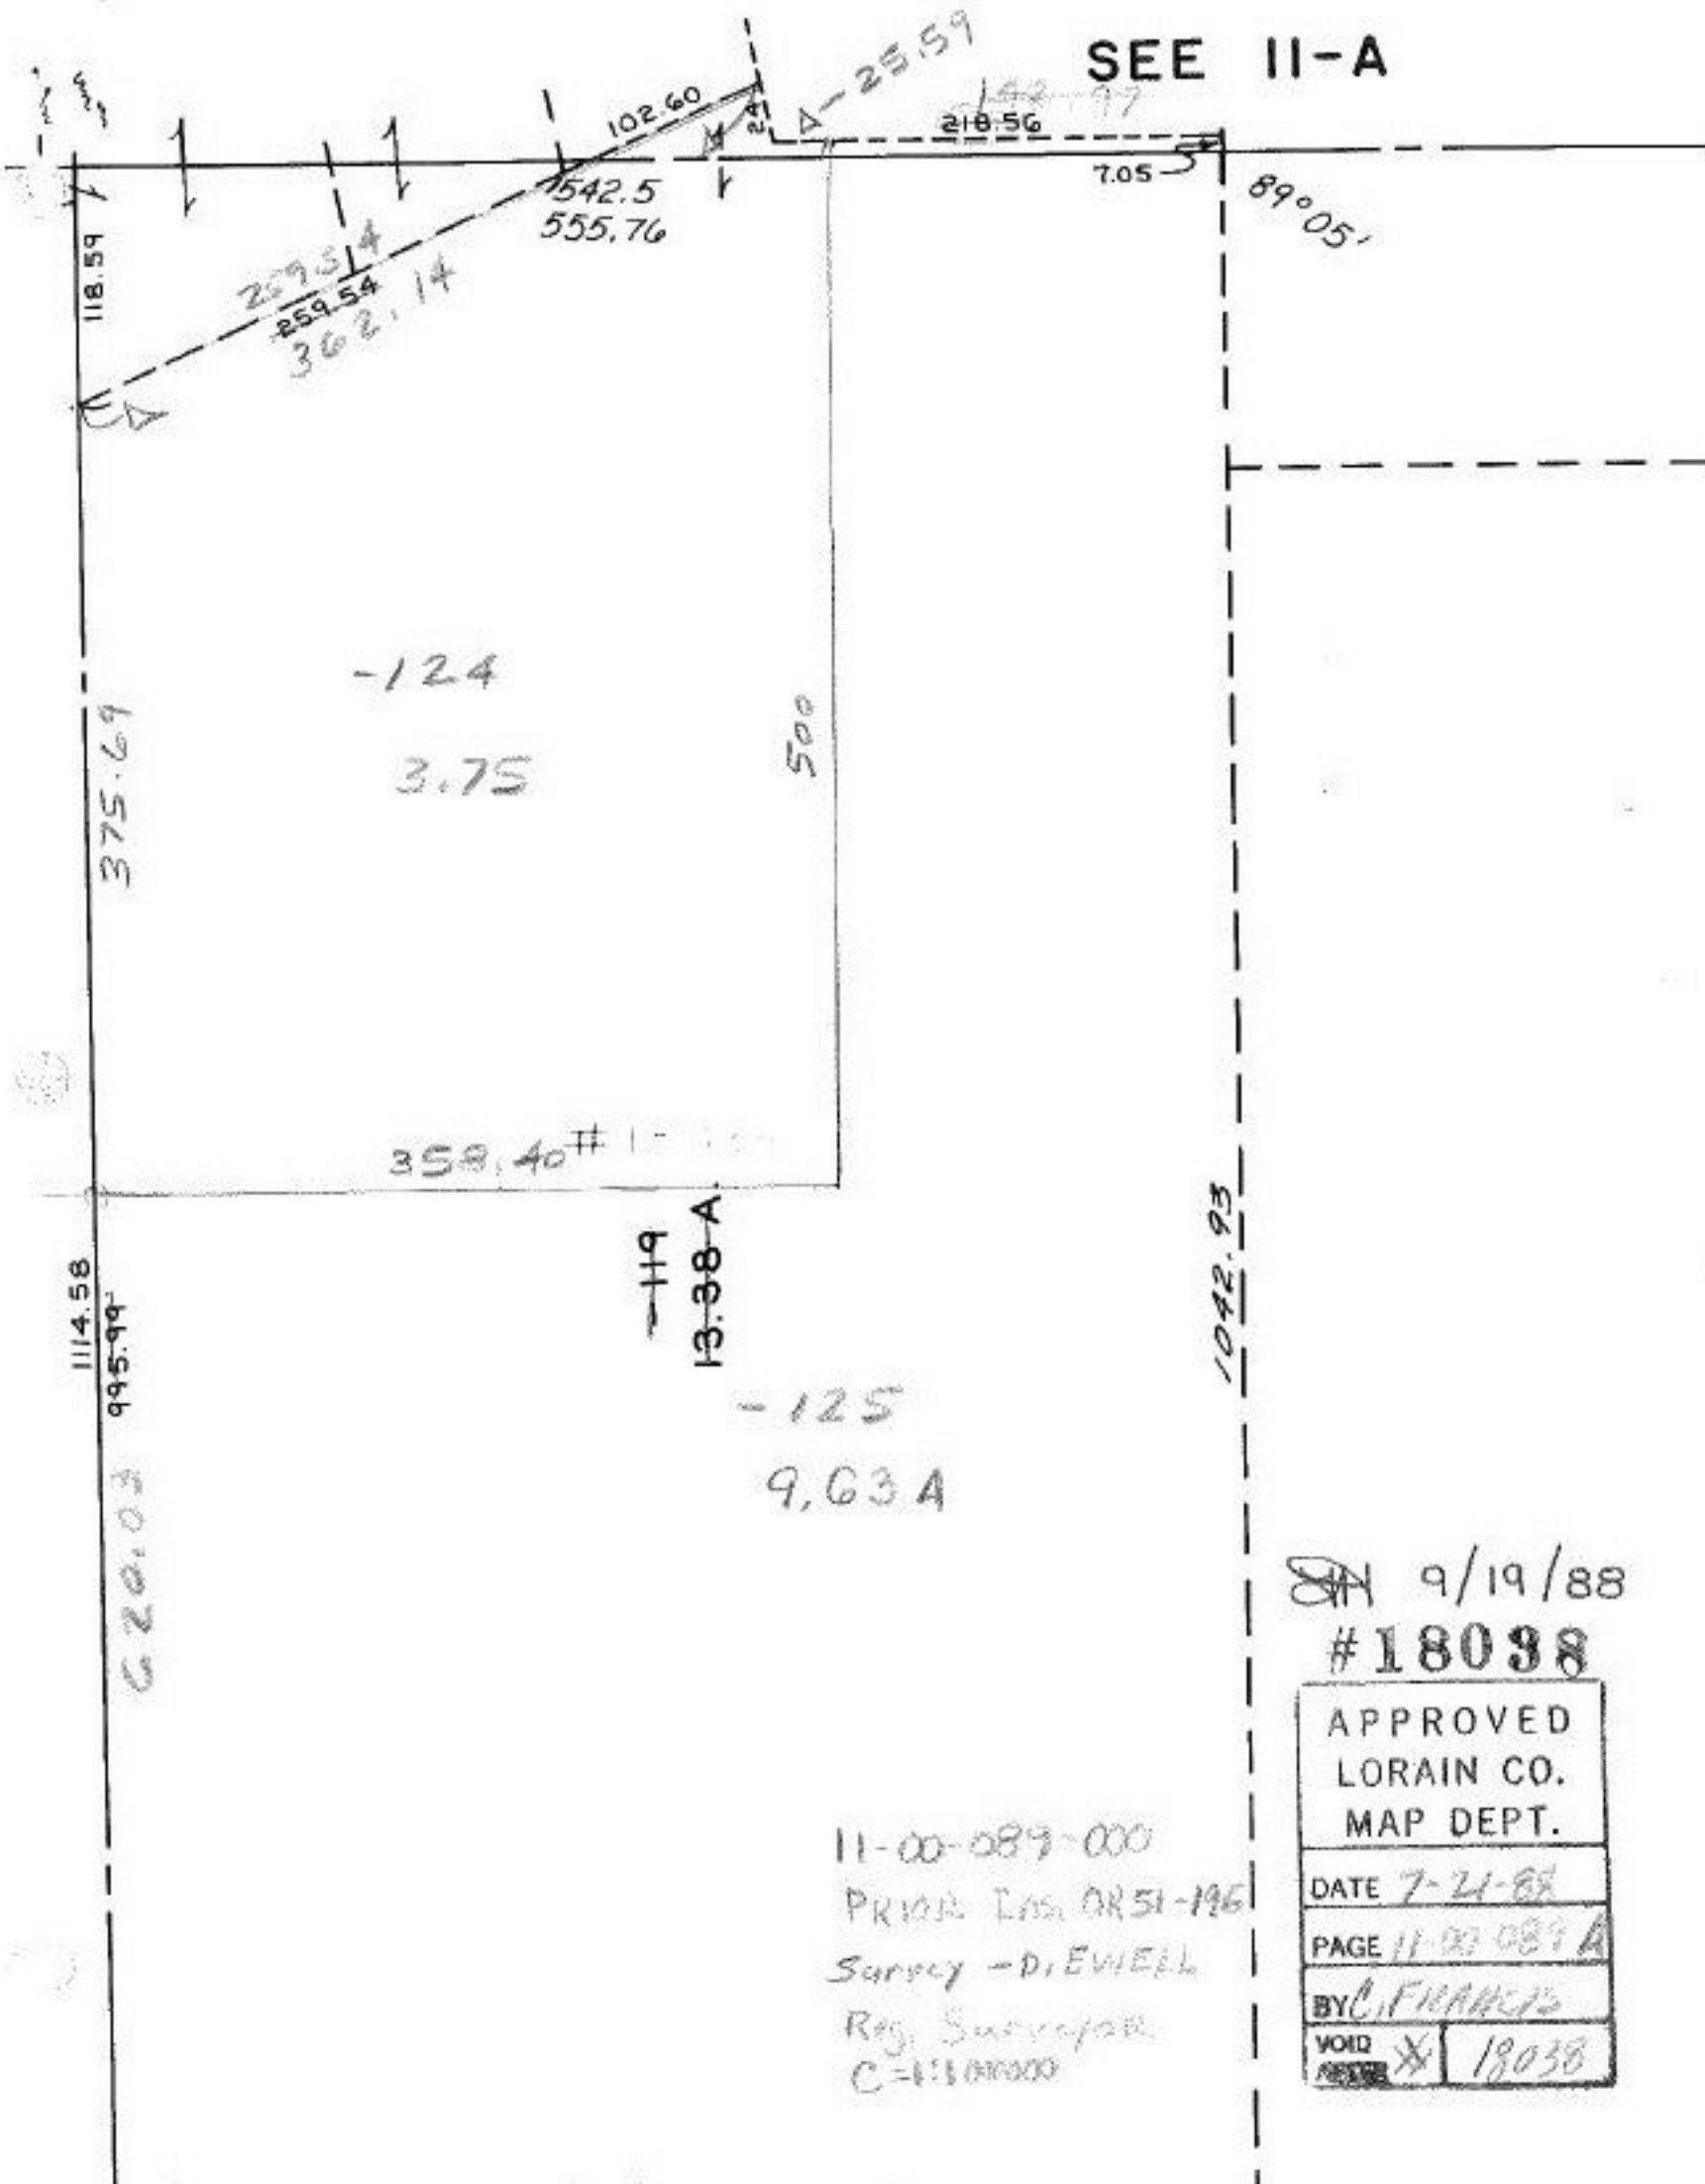

9/19/88
#18038

APPROVED LORAIN CO. MAP DEPT.
DATE 7-21-88
PAGE 11-00-089-A
BY C. FRANCIS
VOID <input checked="" type="checkbox"/> 18038

11-00-089-000
Prior Inv. OR 51-196
Survey - Dr. Eviell
Reg. Surveyor
C-111010000