


SEE 6-100

Ac. Corr
06-24-106-000-018

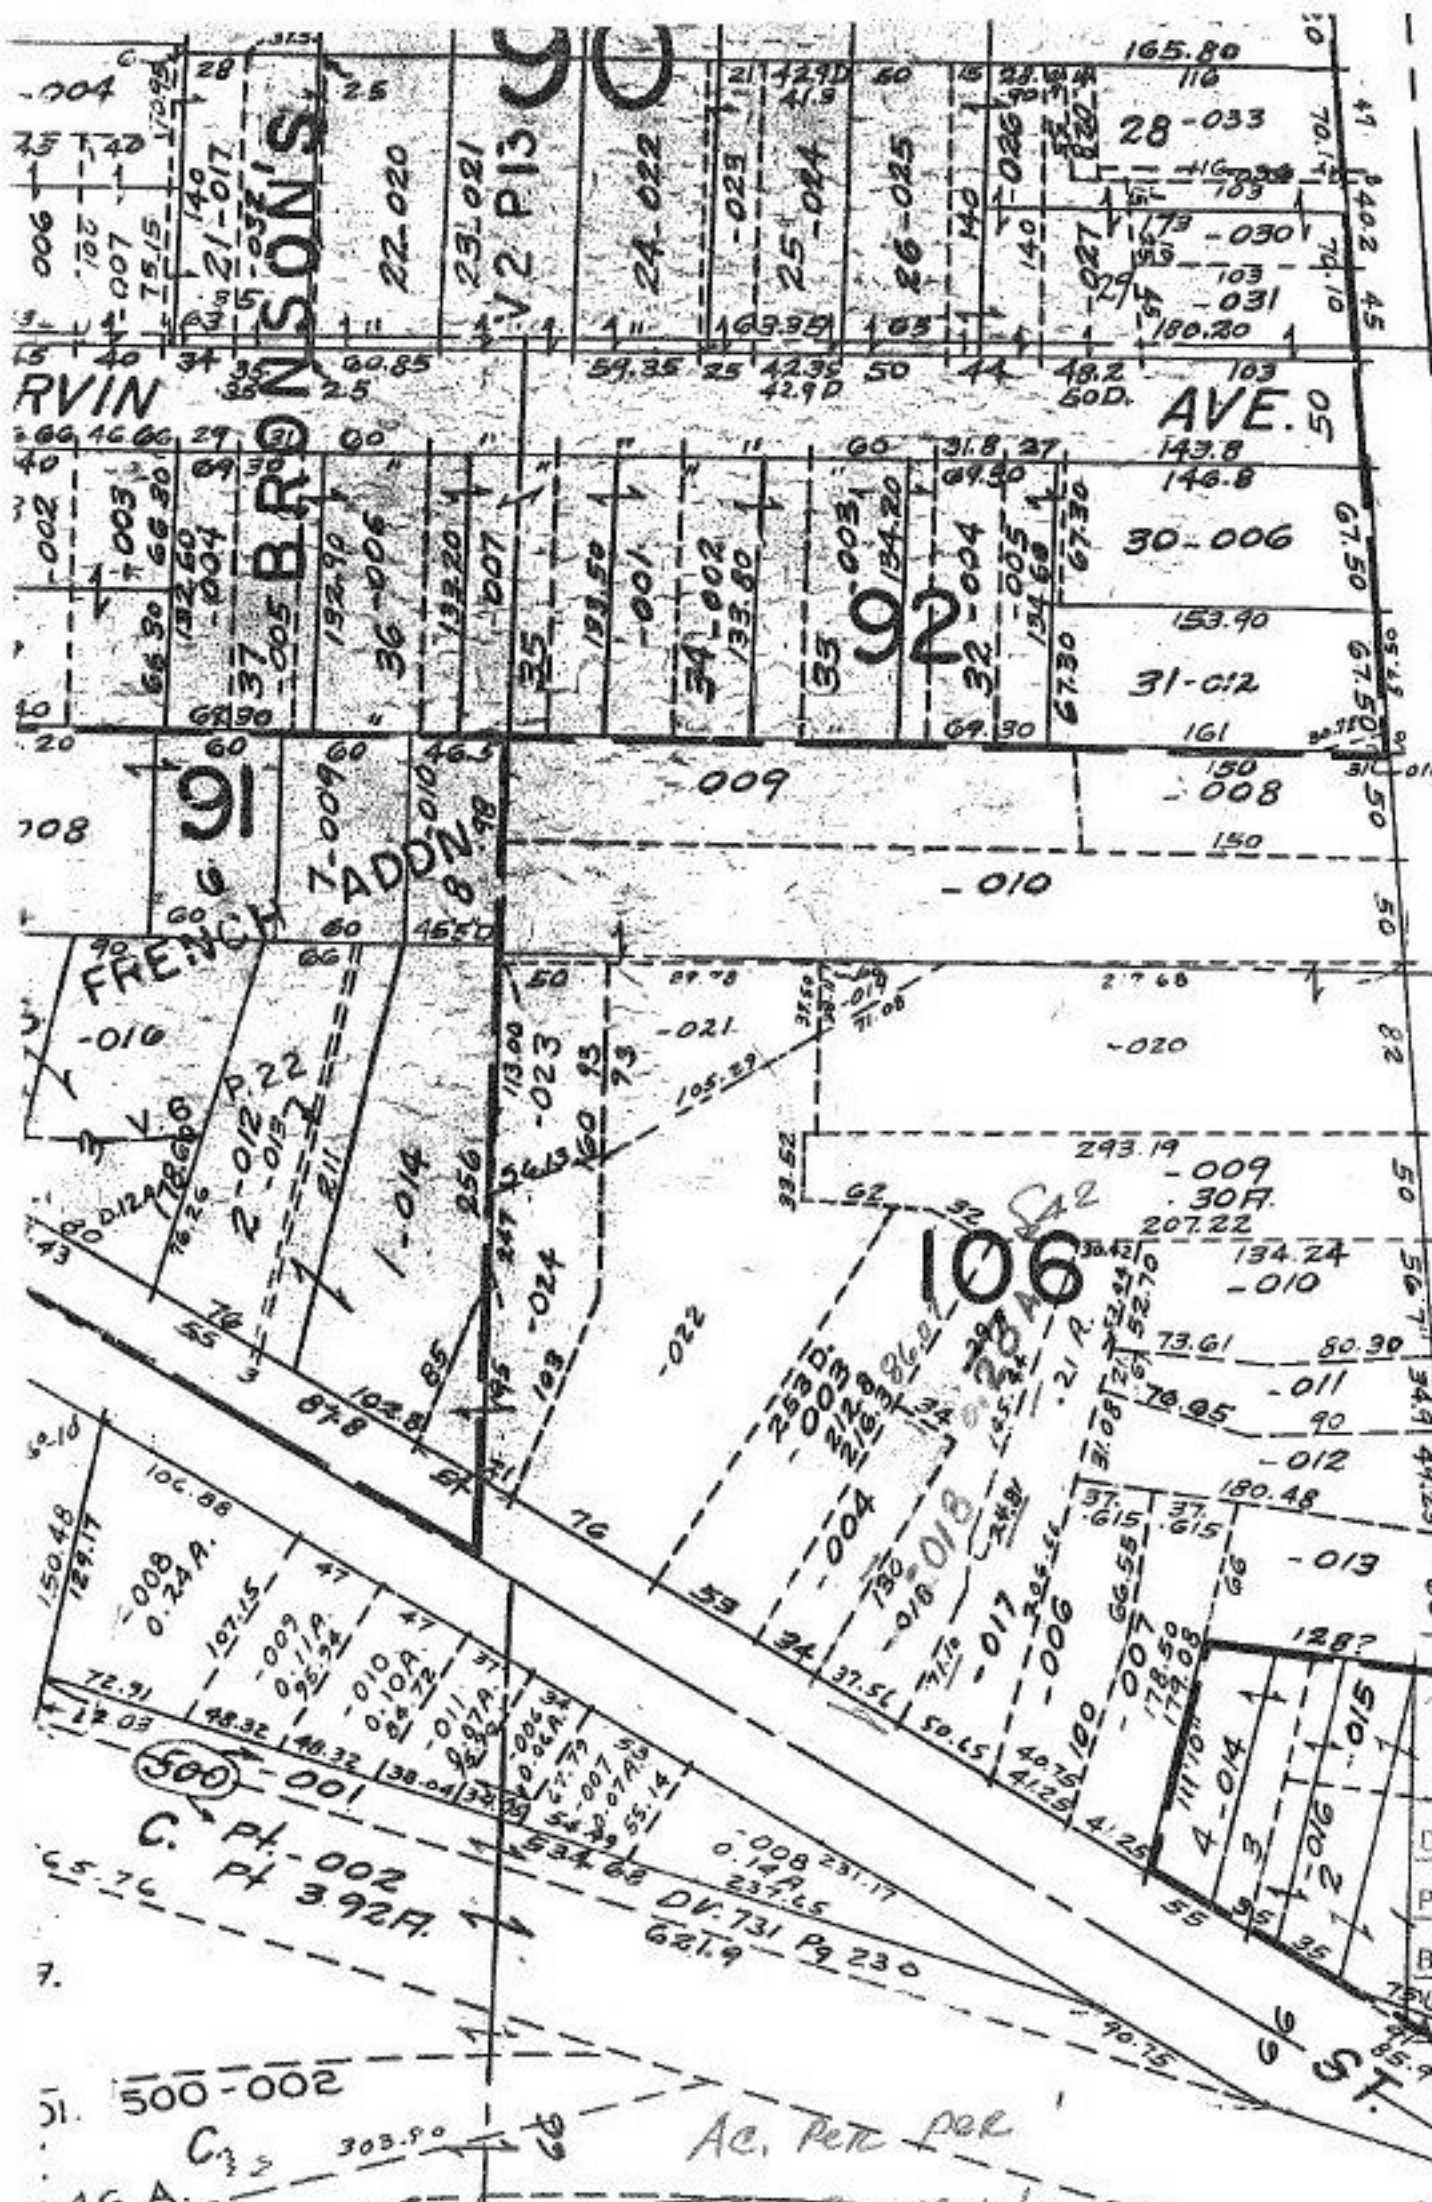

7/29/88
#18043A

APPROVED	DRYIN CO.
MAP DEPT.	
DATE	7-22-88
PAGE	6/99
BY	C. FRANCIS
#	18043A

Ac. Per per
Survey by
Gary Penfound - Reg. Surveyor. C-1:83333