

1805

Done 7-6-68 LWHall



1805


*[Handwritten signature]*



SEE 2-02-005 - A

S.S.  
7-14-86

APPROVED	
LORAIN CO.	
MAP DEPT.	
DATE 5-25-68	
2-02-004-B	
BY	<i>[Signature]</i>

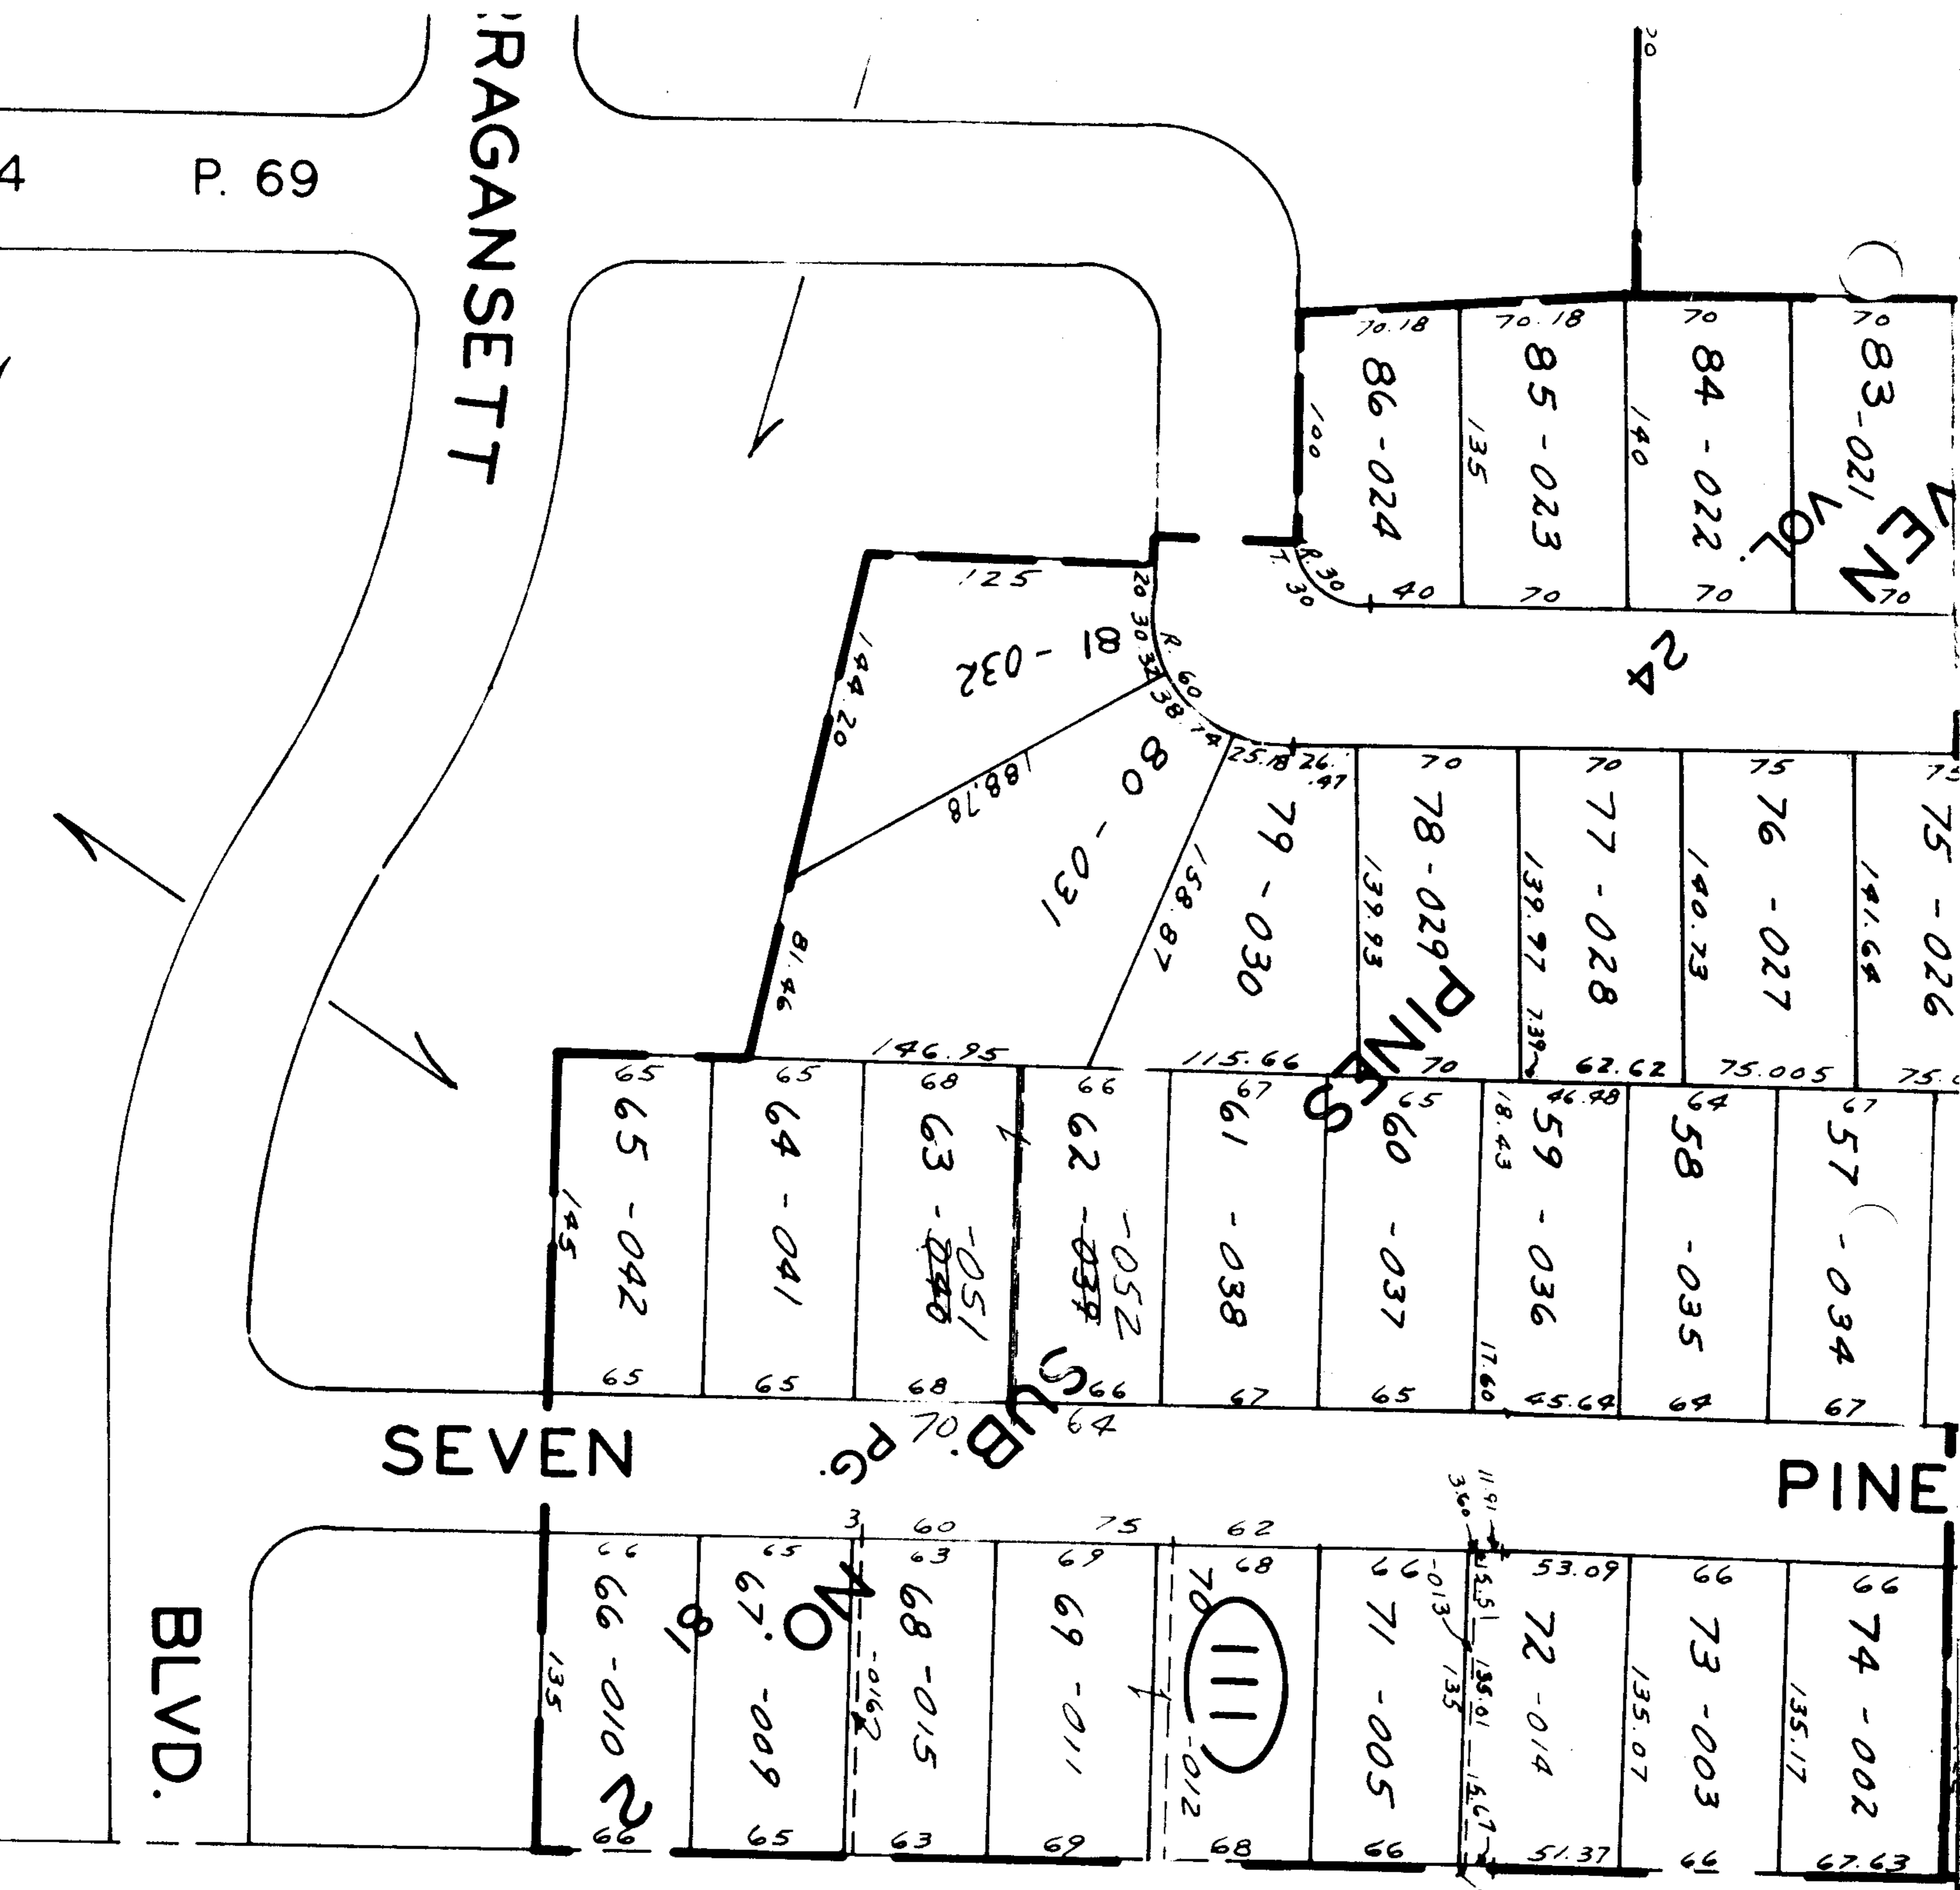

P. 69

RAGANSETT

SEVEN

PINE

BLVD.