

COMBINATION


19-02-059-000-005
-009

11/1/88
#18061-A

APPROVED LORAIN CO. MAP DEPT.
DATE 8-4-88
PAGE 19-H
BY Carol Francis
VOID AFTER #18061-A

#18039

APPROVED LORAIN CO. MAP DEPT.
DATE 7-22-88
PAGE 19-H
BY Carol Francis
VOID AFTER #18039

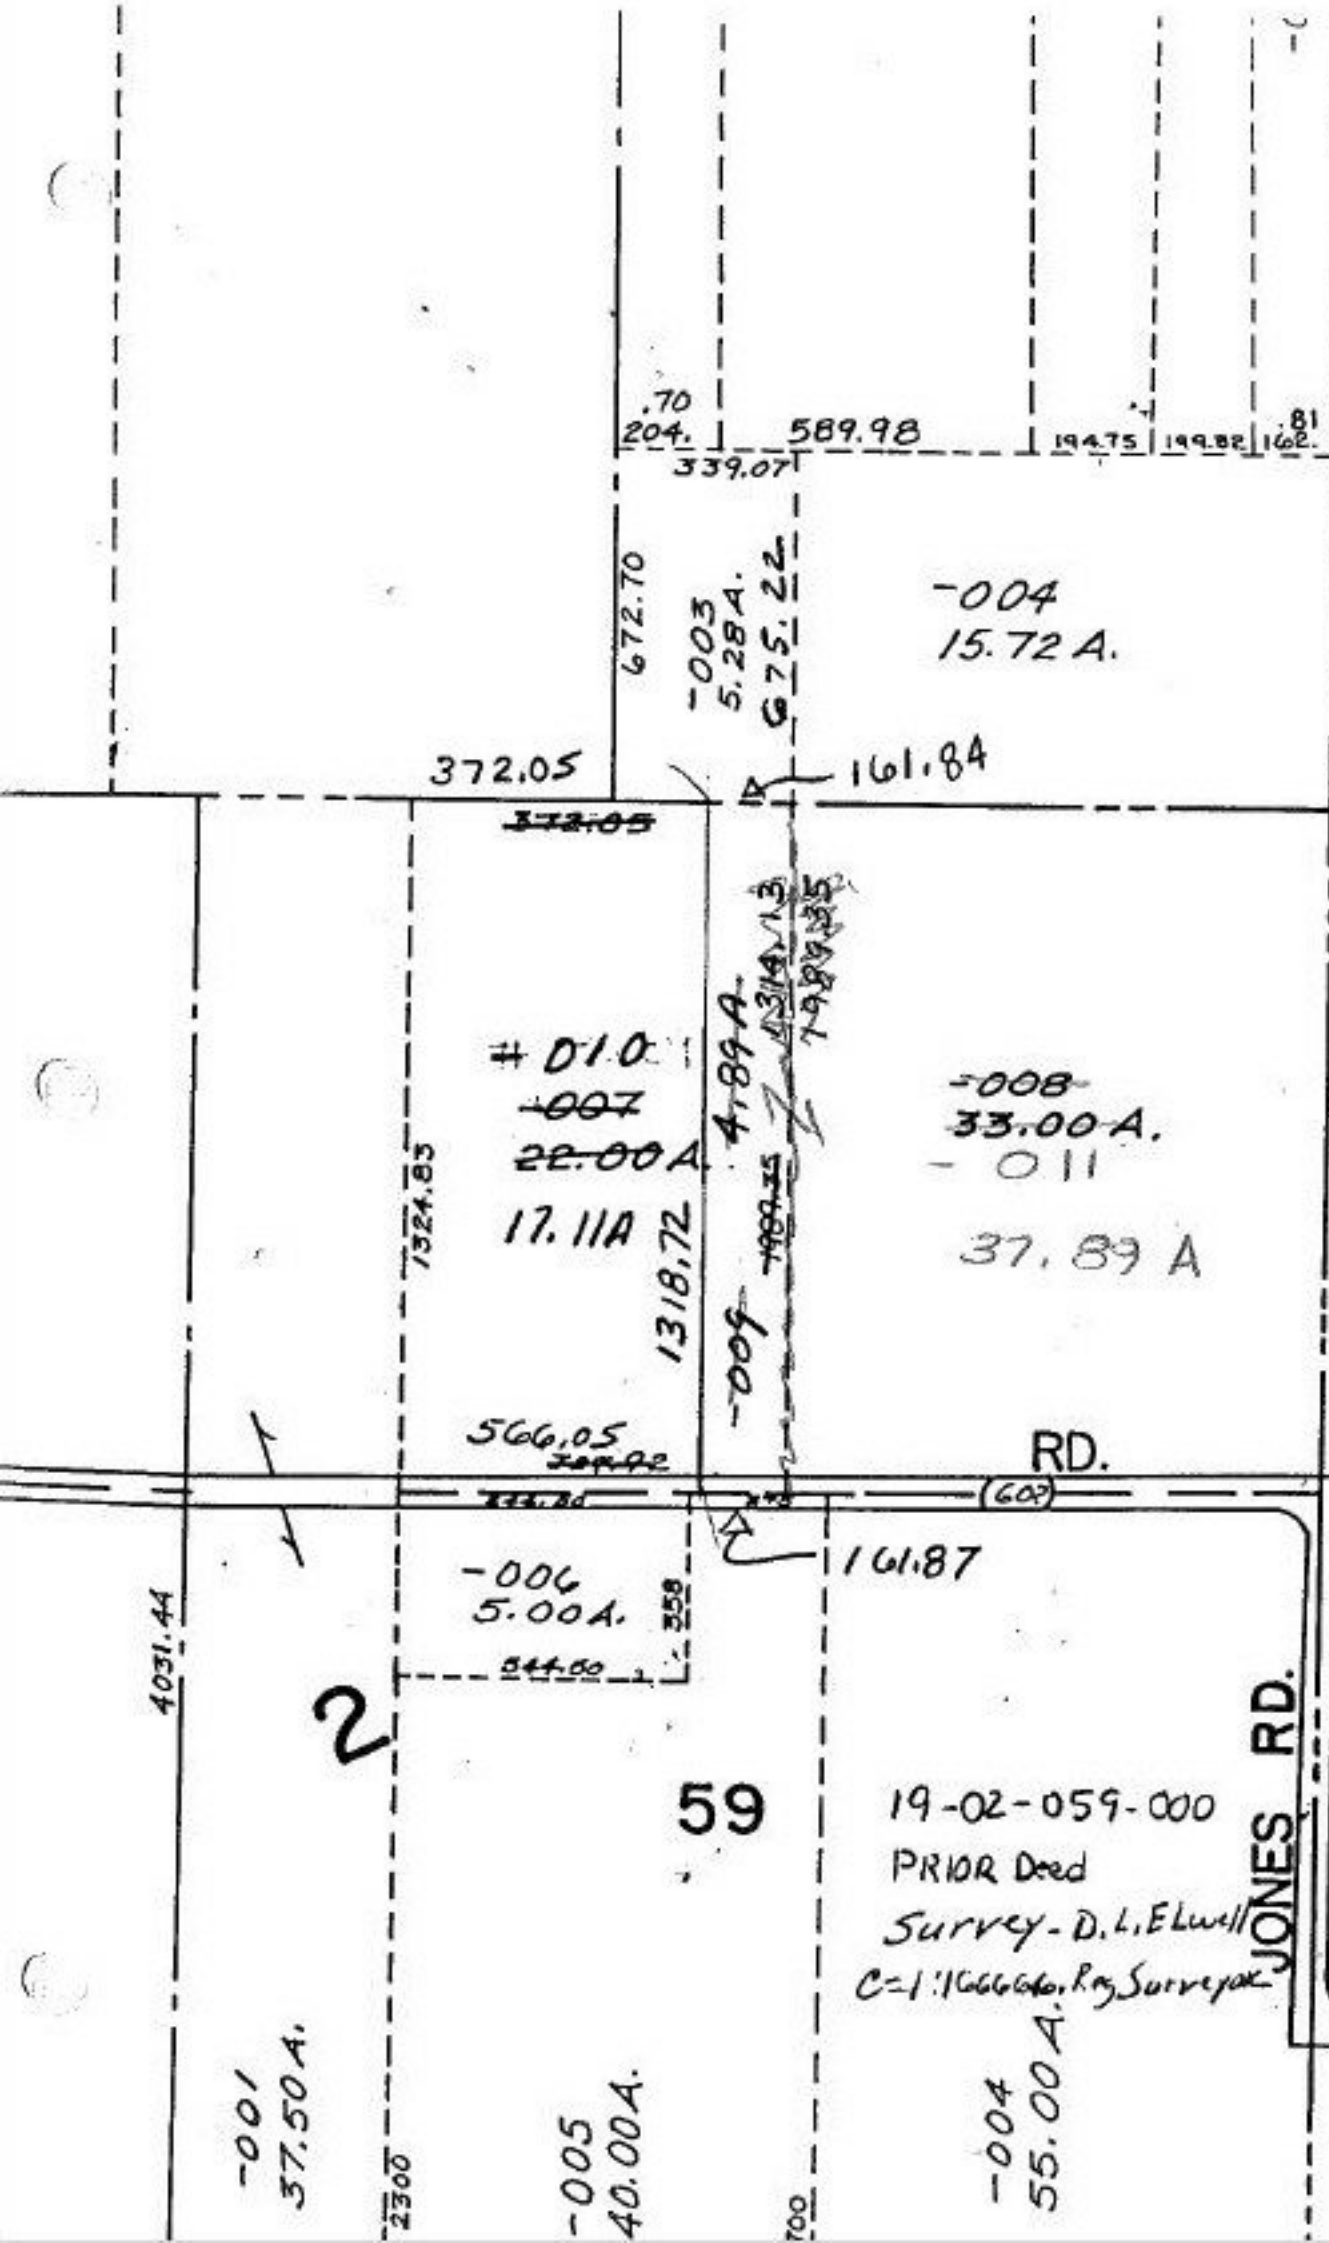

19-02-059-000
PRIOR Deed
Survey - D. L. Elwell
C-1: 1666666, R. G. Surveyor