

705.47 ON NORTH LINE

3036.37

-036  
~~-032~~  
40.42 A  
46.11 A


(A)

2785.99

SURVEYED BY H.C. REITZ ENG.  
SEE NAME ON DEED  
(A) CL = 1:30,303  
(B) CL = 1:333,333

9/9/88  
#18061

APPROVED  
LORAIN CO.  
MAP DEPT.  
DATE 8-2-88  
PAGE 4-00-030H  
BY *Carol Francis*  
VOID AFTER #18061

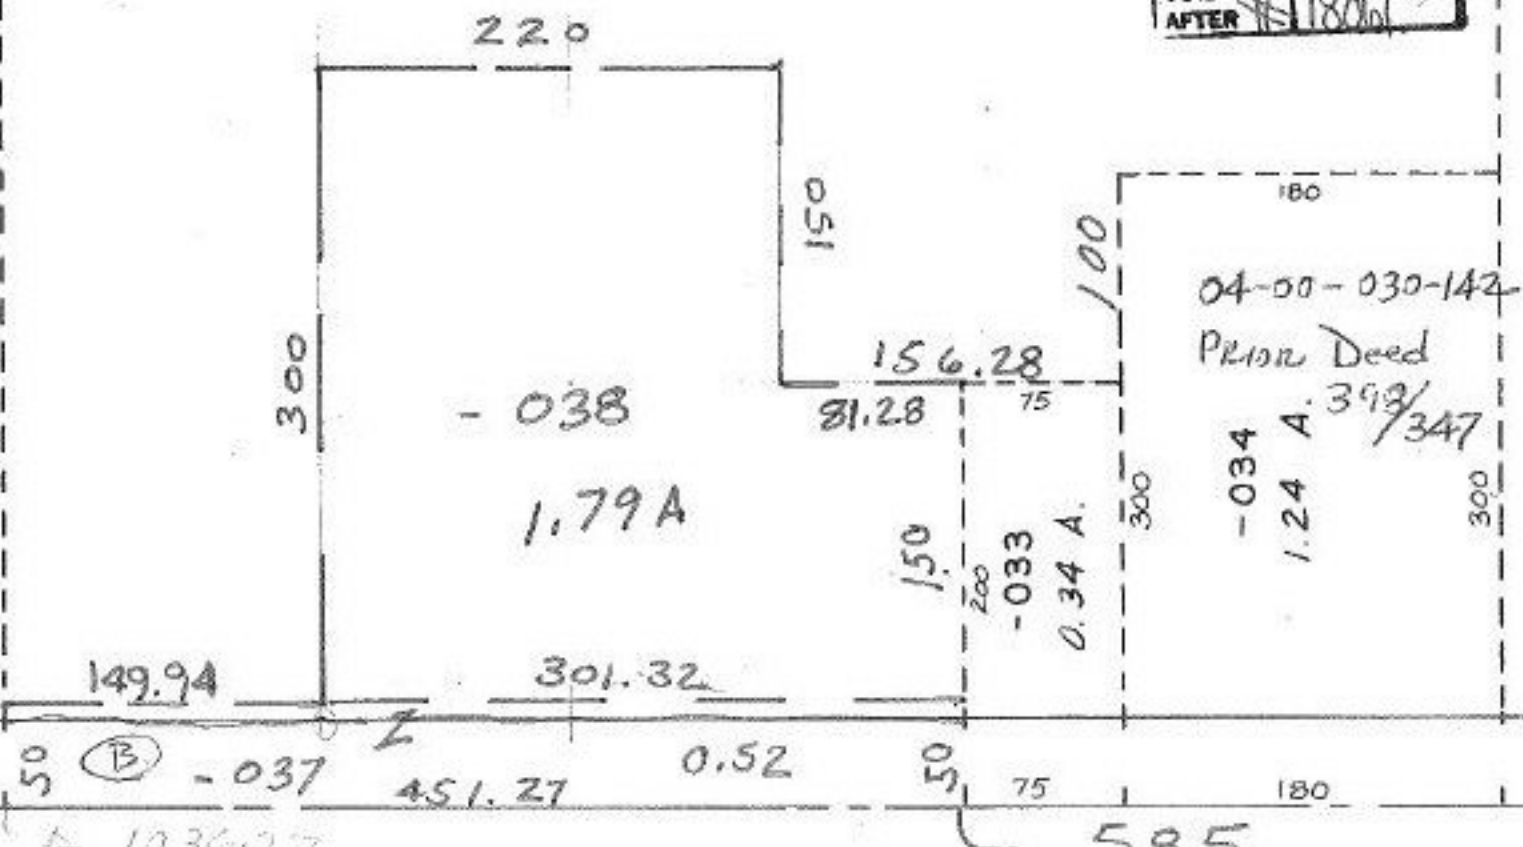

04-00-030-142  
Prior Deed  
-034  
1.24 A. 393/347

50 (B) -037

1036.27

585