


N.

Y.

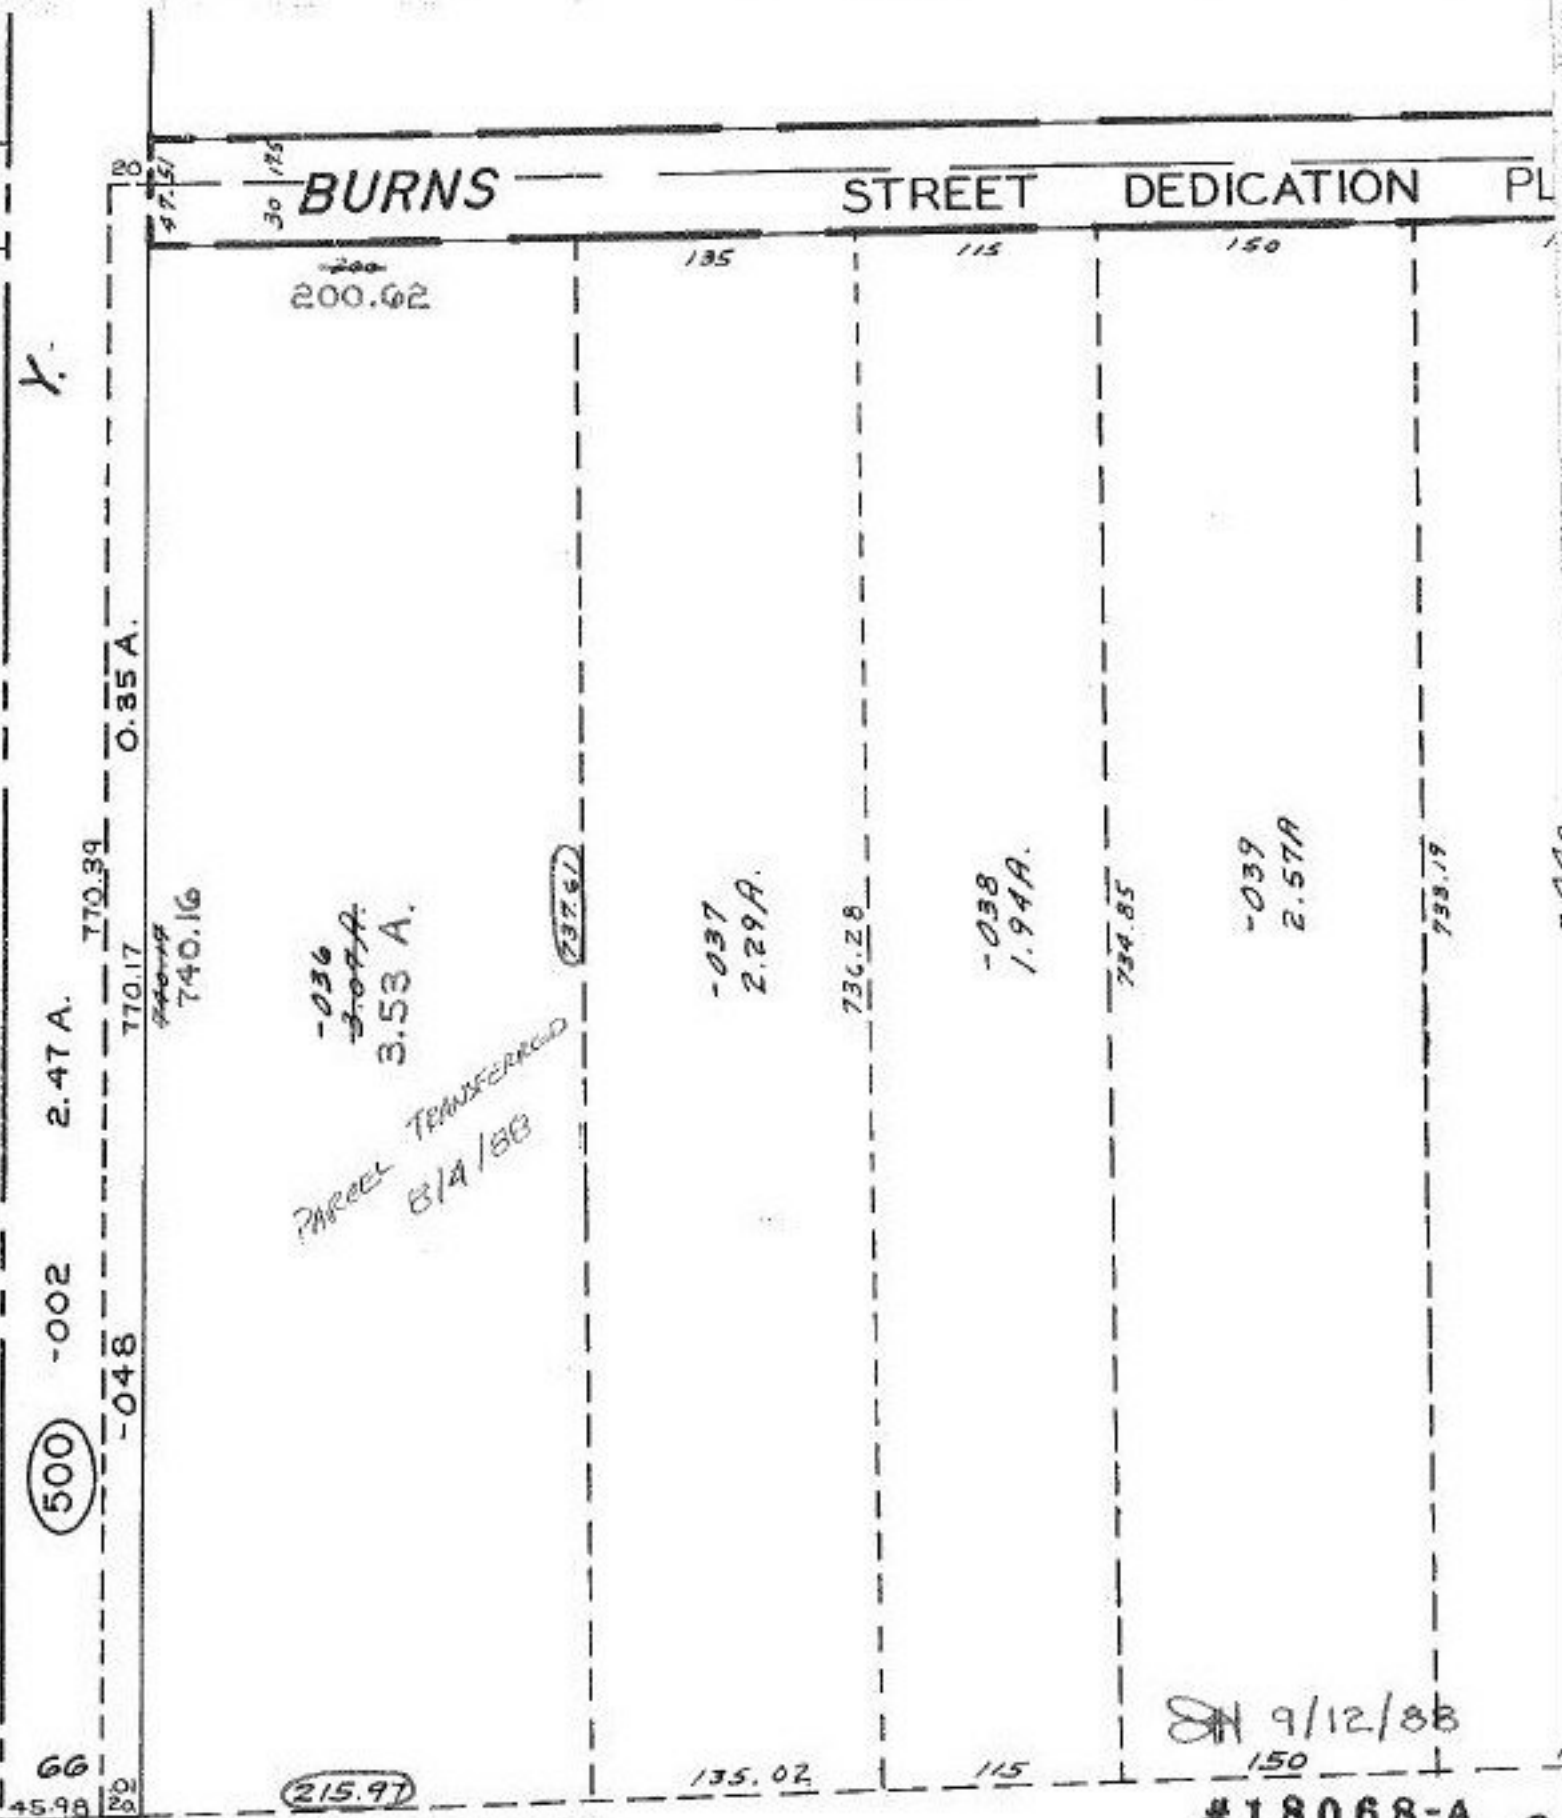

ACREAGE CORRECTIONS  
 PER SURVEY BY K.S. & ASSOC.  
 -0.023276  
 0.162275  
 1:11,494  
 CLOSURE

9/12/88

#18068-A

APPROVED LORAIN CO. MAP DEPT.	
DATE 8/8/88	
PAGE 7-00-044-A	
BY T. HOLLIS	
VOID AFTER	18068-A