


Lake

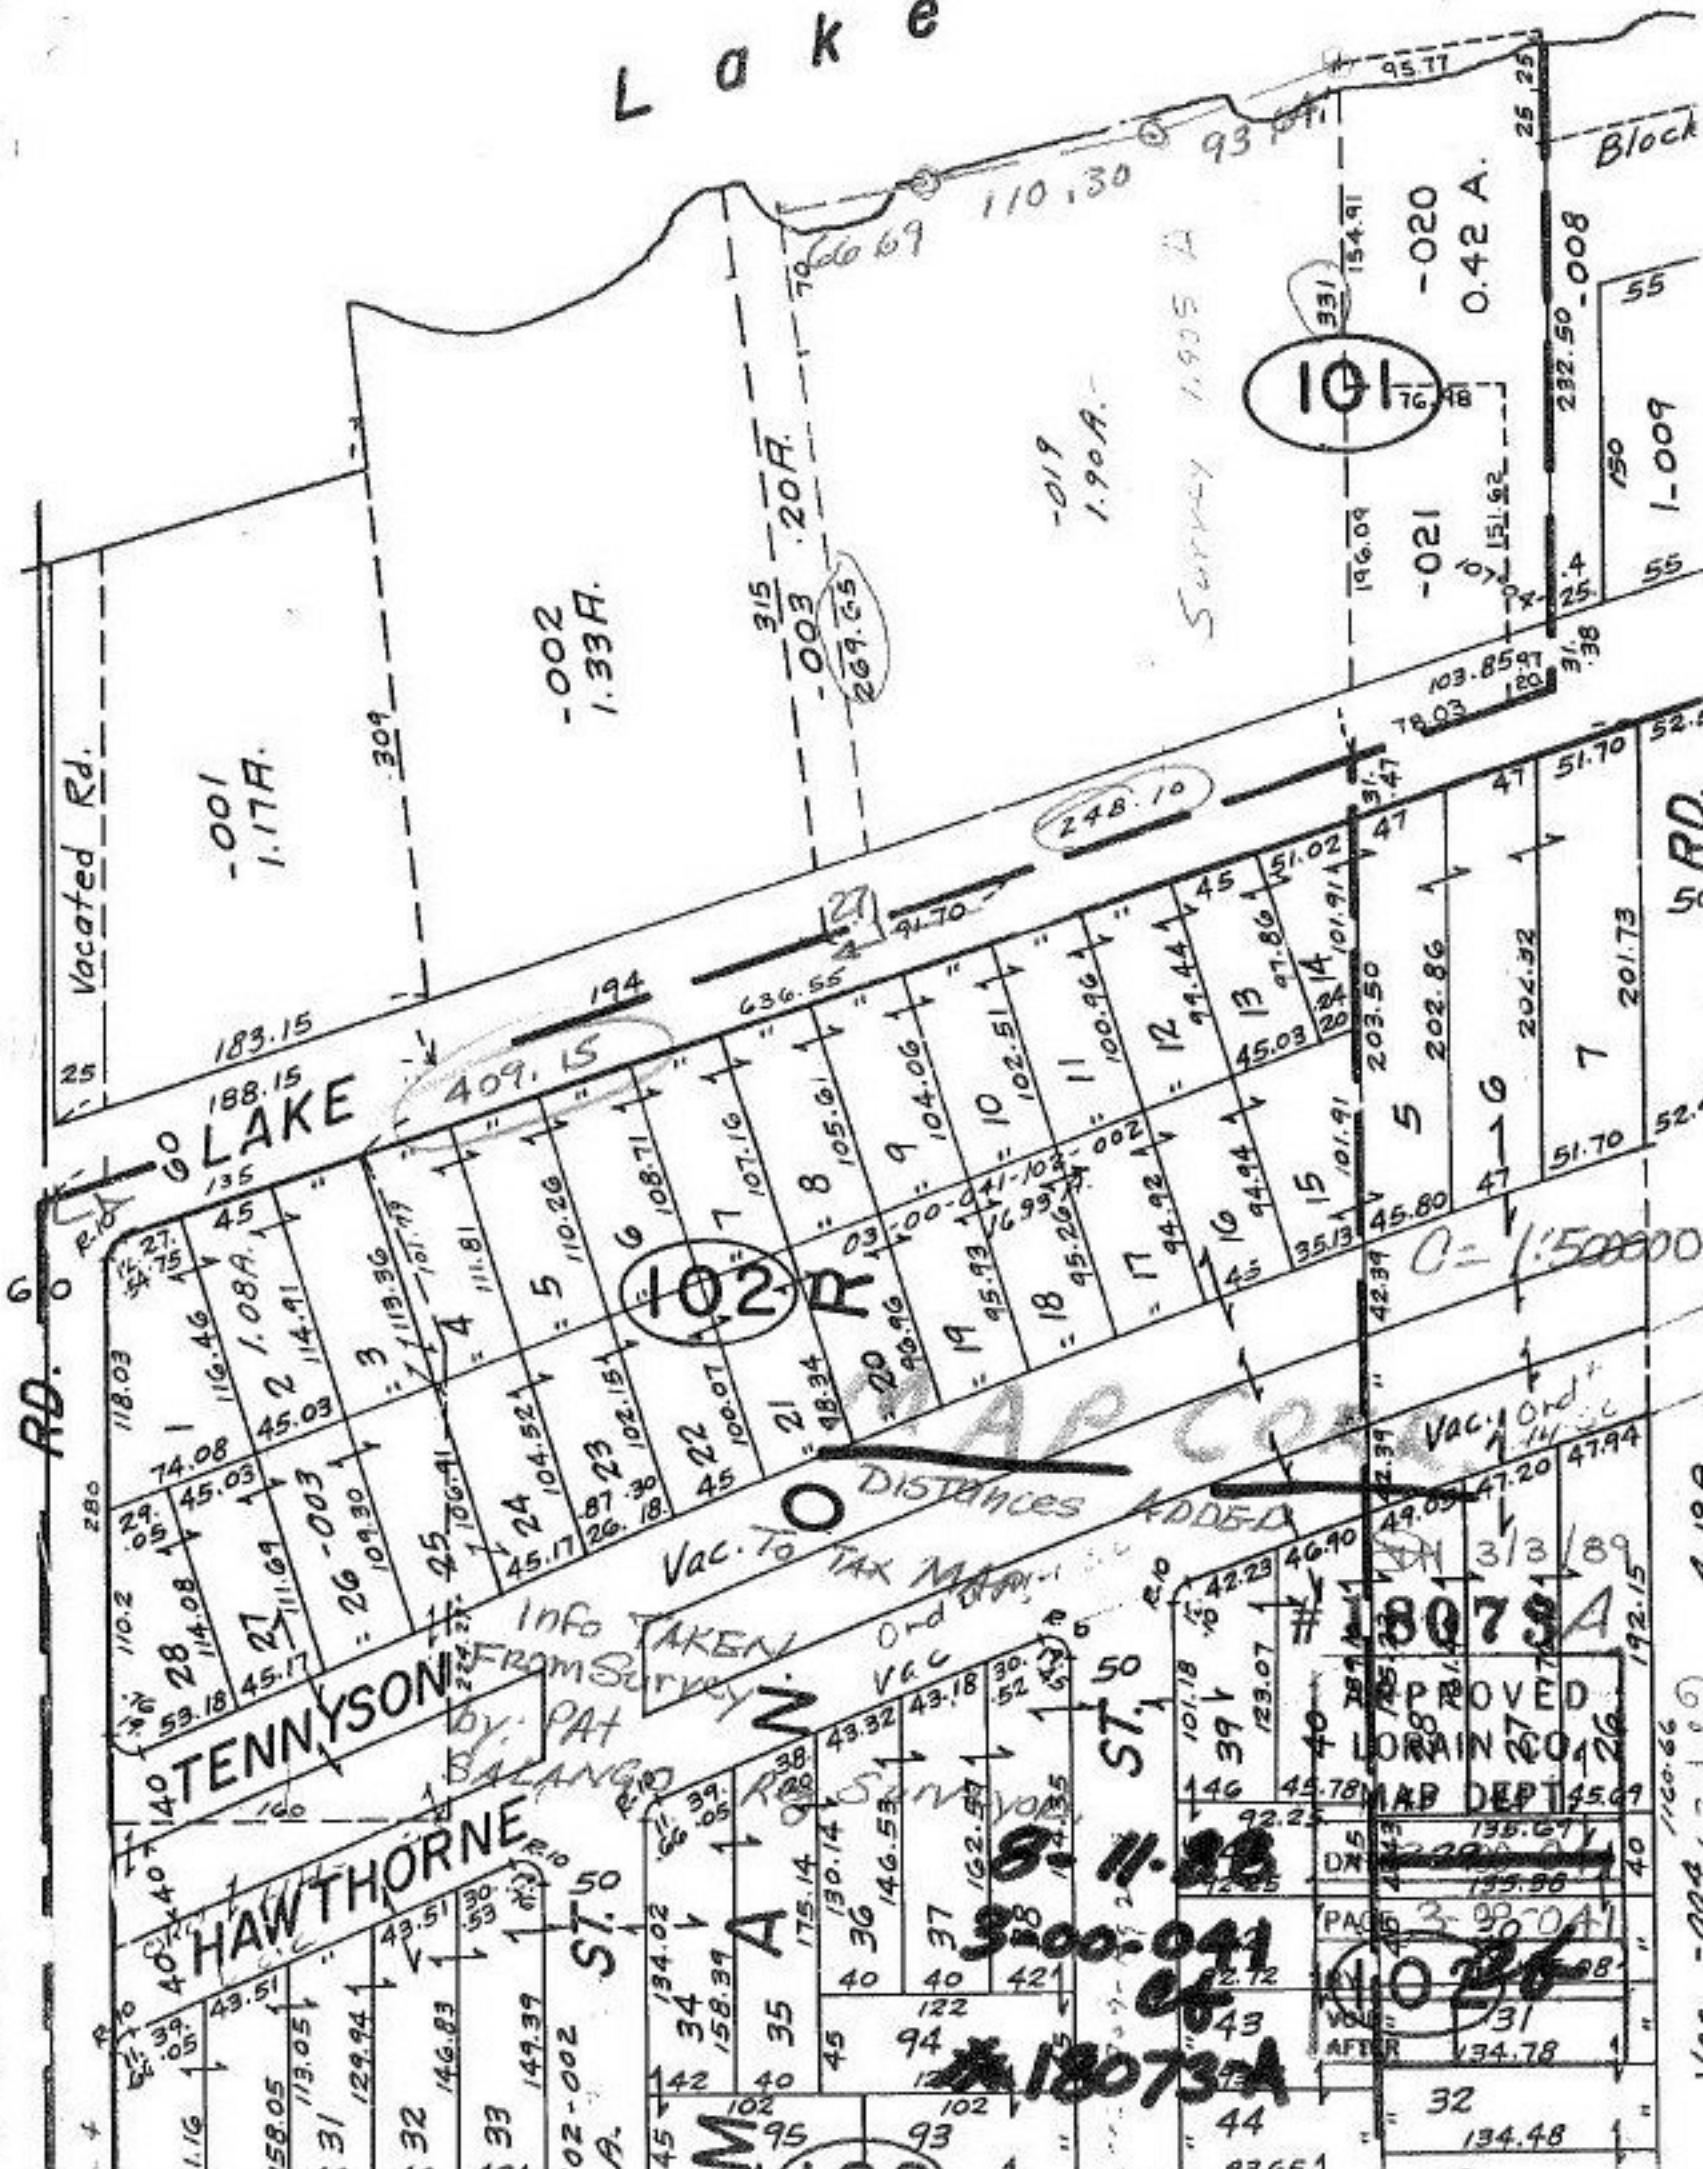

Vacated Rd.

-001
1.17A.

-002
1.33A.

315
003
20F.

269.65

-019
1.90A.

Survey 1.905 A

101

-020
0.42 A.

232.50-008

Block

55

150

55

1-009

LAKE

102

Distances Added

TENNYSON

HAWTHORNE

ST. 50

M

34

35

36

-042-A

Vac. -004 52.68

C = 1:50000

18073A

3.00-041
18073A

APPROVED
LORAIN CO
MAB DEPT

102

32
134.48

192.15

4.19A.

50 RD.

55

55

