

-004  
1.44 A.  
815.32

105.98

272.22  
-054  
1.00 A.  
272.22  
160.02  
-070  
0.24 A.  
160.02  
65

-073  
23.11 A

18063  
-071  
27.12 A

# COMBINATION

SN 9/12/88

#18074-A

910

APPROVED  
LORAIN CO.  
MAP DEPT.  
DATE 3-12-88  
PAGE 9-00-100B  
BY Coed-Franck  
VOID AFTER #18074-A


1887.24  
77.24

-072 - 074  
4.01 A 5.01 A

637.78 910

09-00-100-000

PRIOR INST. 1112-374  
Survey by Doug Mosley  
Reg. Surveyor  
CI-1:1NF

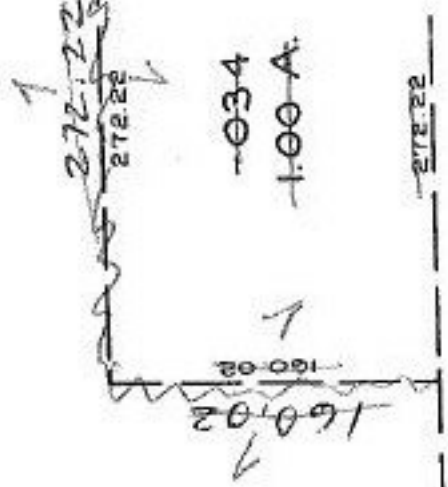

250.00

45