


-010  
4.05 A.

105

617.28

-011  
5.05 A.

# Acresages CORR.

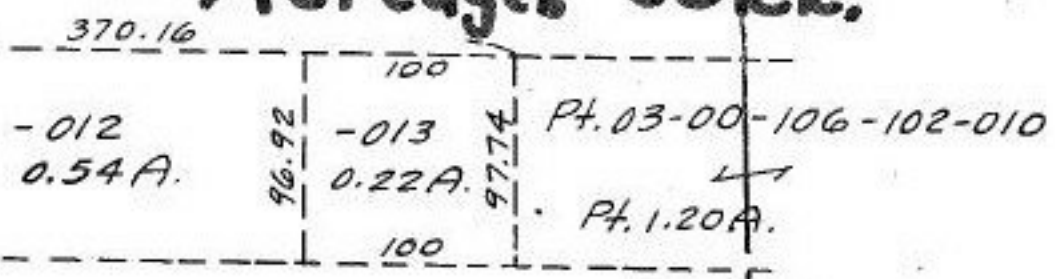

-014  
0.83 A.

313/89

## #18077 A

APPROVED	
LORAIN CO.	
MAP DEPT.	
DATE	9-21-88
PAGE	3-00-107-B
BY	Carol Francis
VOID AFTER #	18077-A

#18077-A