

58

85

105

HALLAUER

1808

96

7-25-86 L.L.L.

APPROVED

LORAIN CO.




MAP DEPT.

DATE 6-3-68

14-6

BY *H. Collier*

Handwritten signature

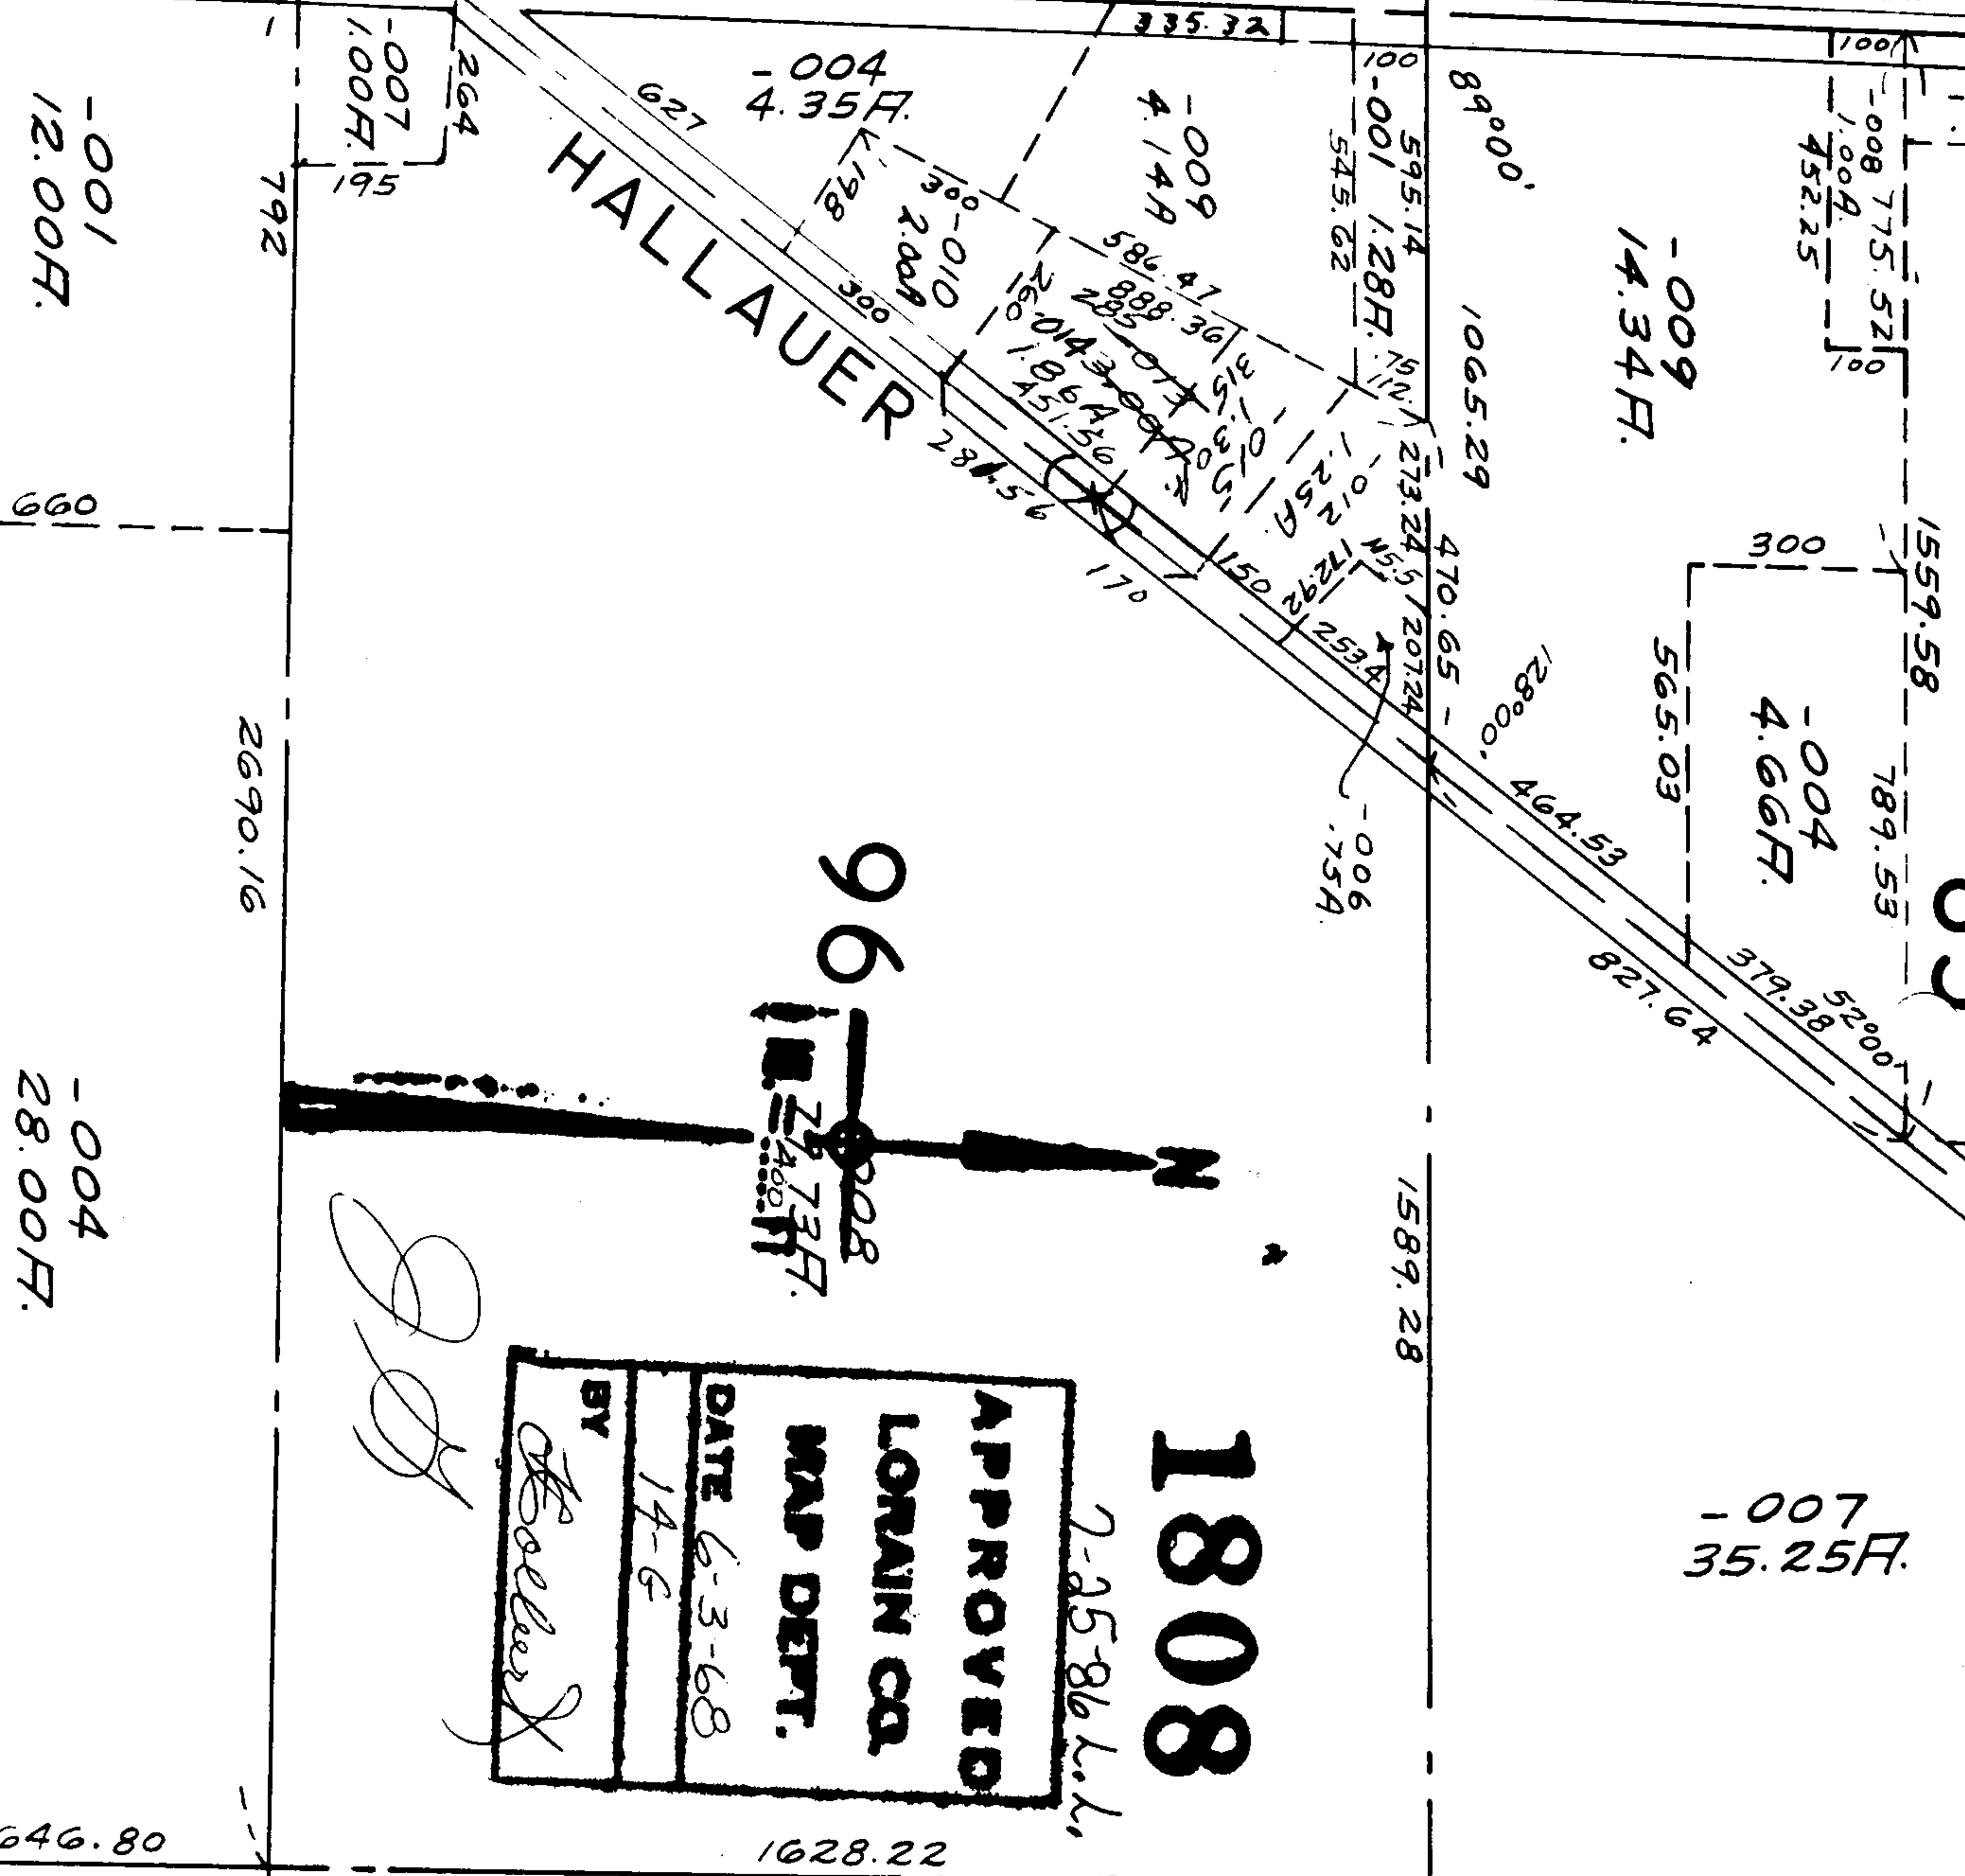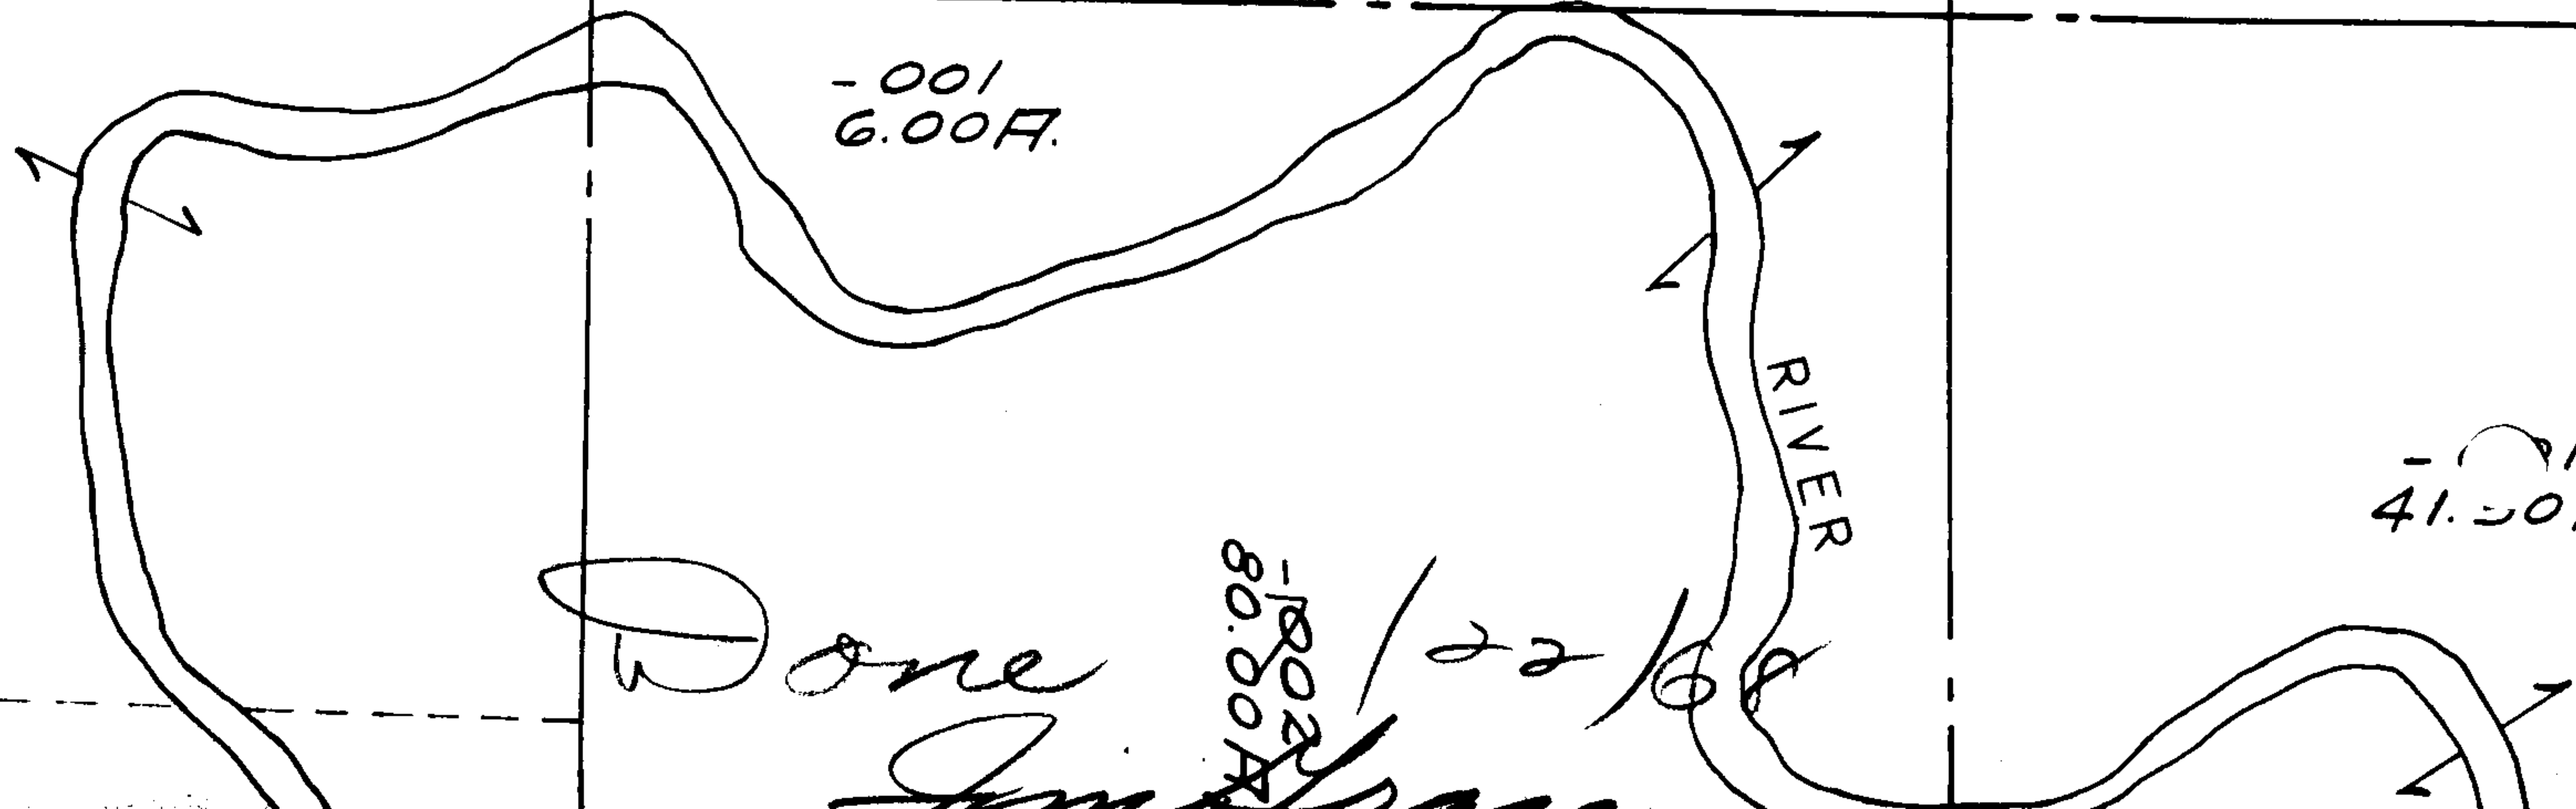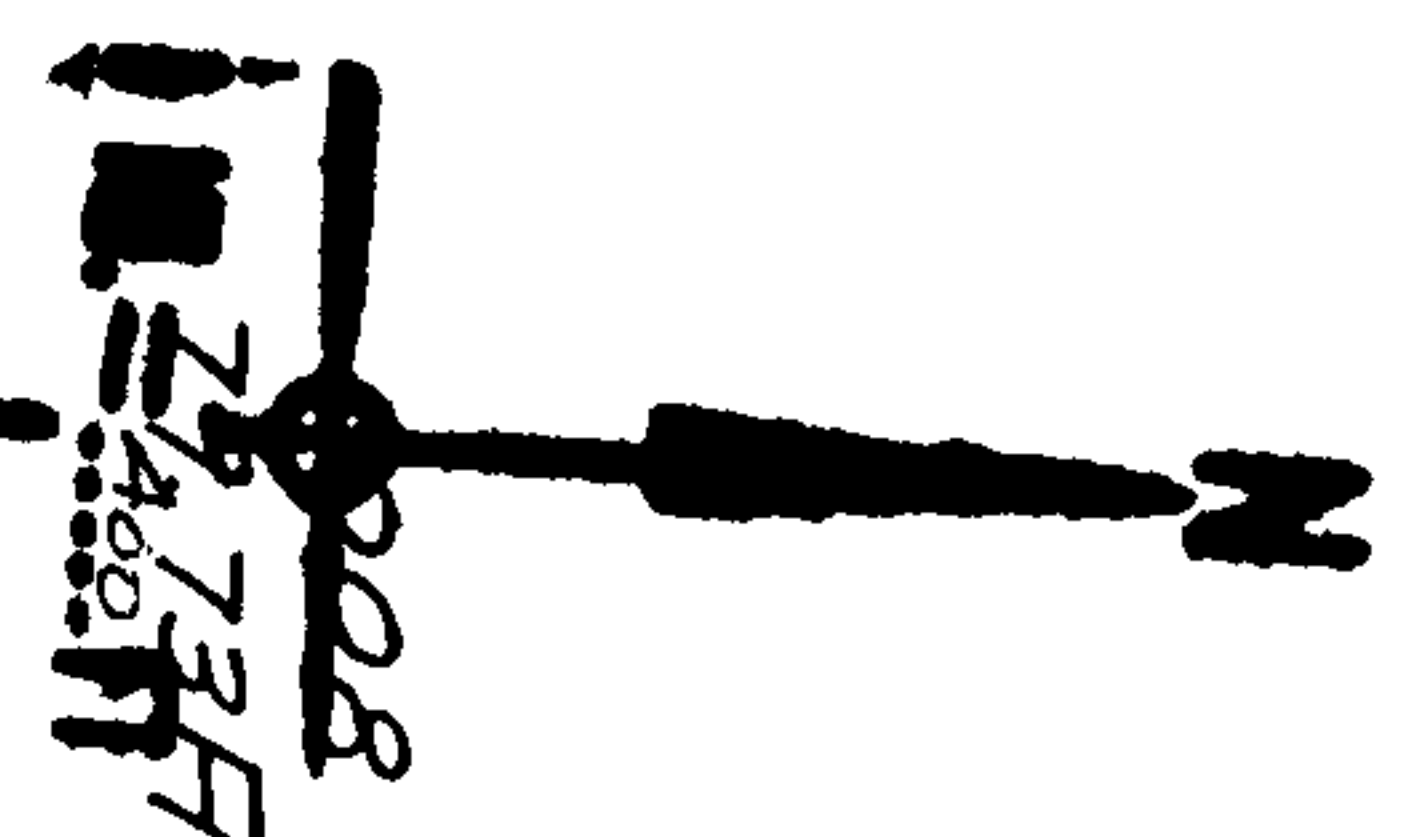

-008 775.5210
1.000 F.
752.25

-009
14.34 F.

-004
4.66 F.

-007
35.25 F.

-004
4.35 F.

-009
4.14 F.

-001 1.28 F.
545.62

84°00'
1065.29

1589.28

-007
1.00 F.

-001
12.00 F.

-004
28.00 F.

-001
6.00 F.

-1802
80.00 F.

-01
41.00 F.

Handwritten signature

2702.04

2690.16

646.80

1628.22

792

660

335.32

300

1559.58

789.53

565.03

827.64

128°00'

464.53

595.14

470.65

273.24

1201.24

545.62

172.92

151

586.47

285

259.4

170

315.30

315.30

152

152

260

260

251.56

284.56

201.4

201.4

251.56

284.56

201.4

201.4

251.56

284.56