


SEE 4-00-002-H

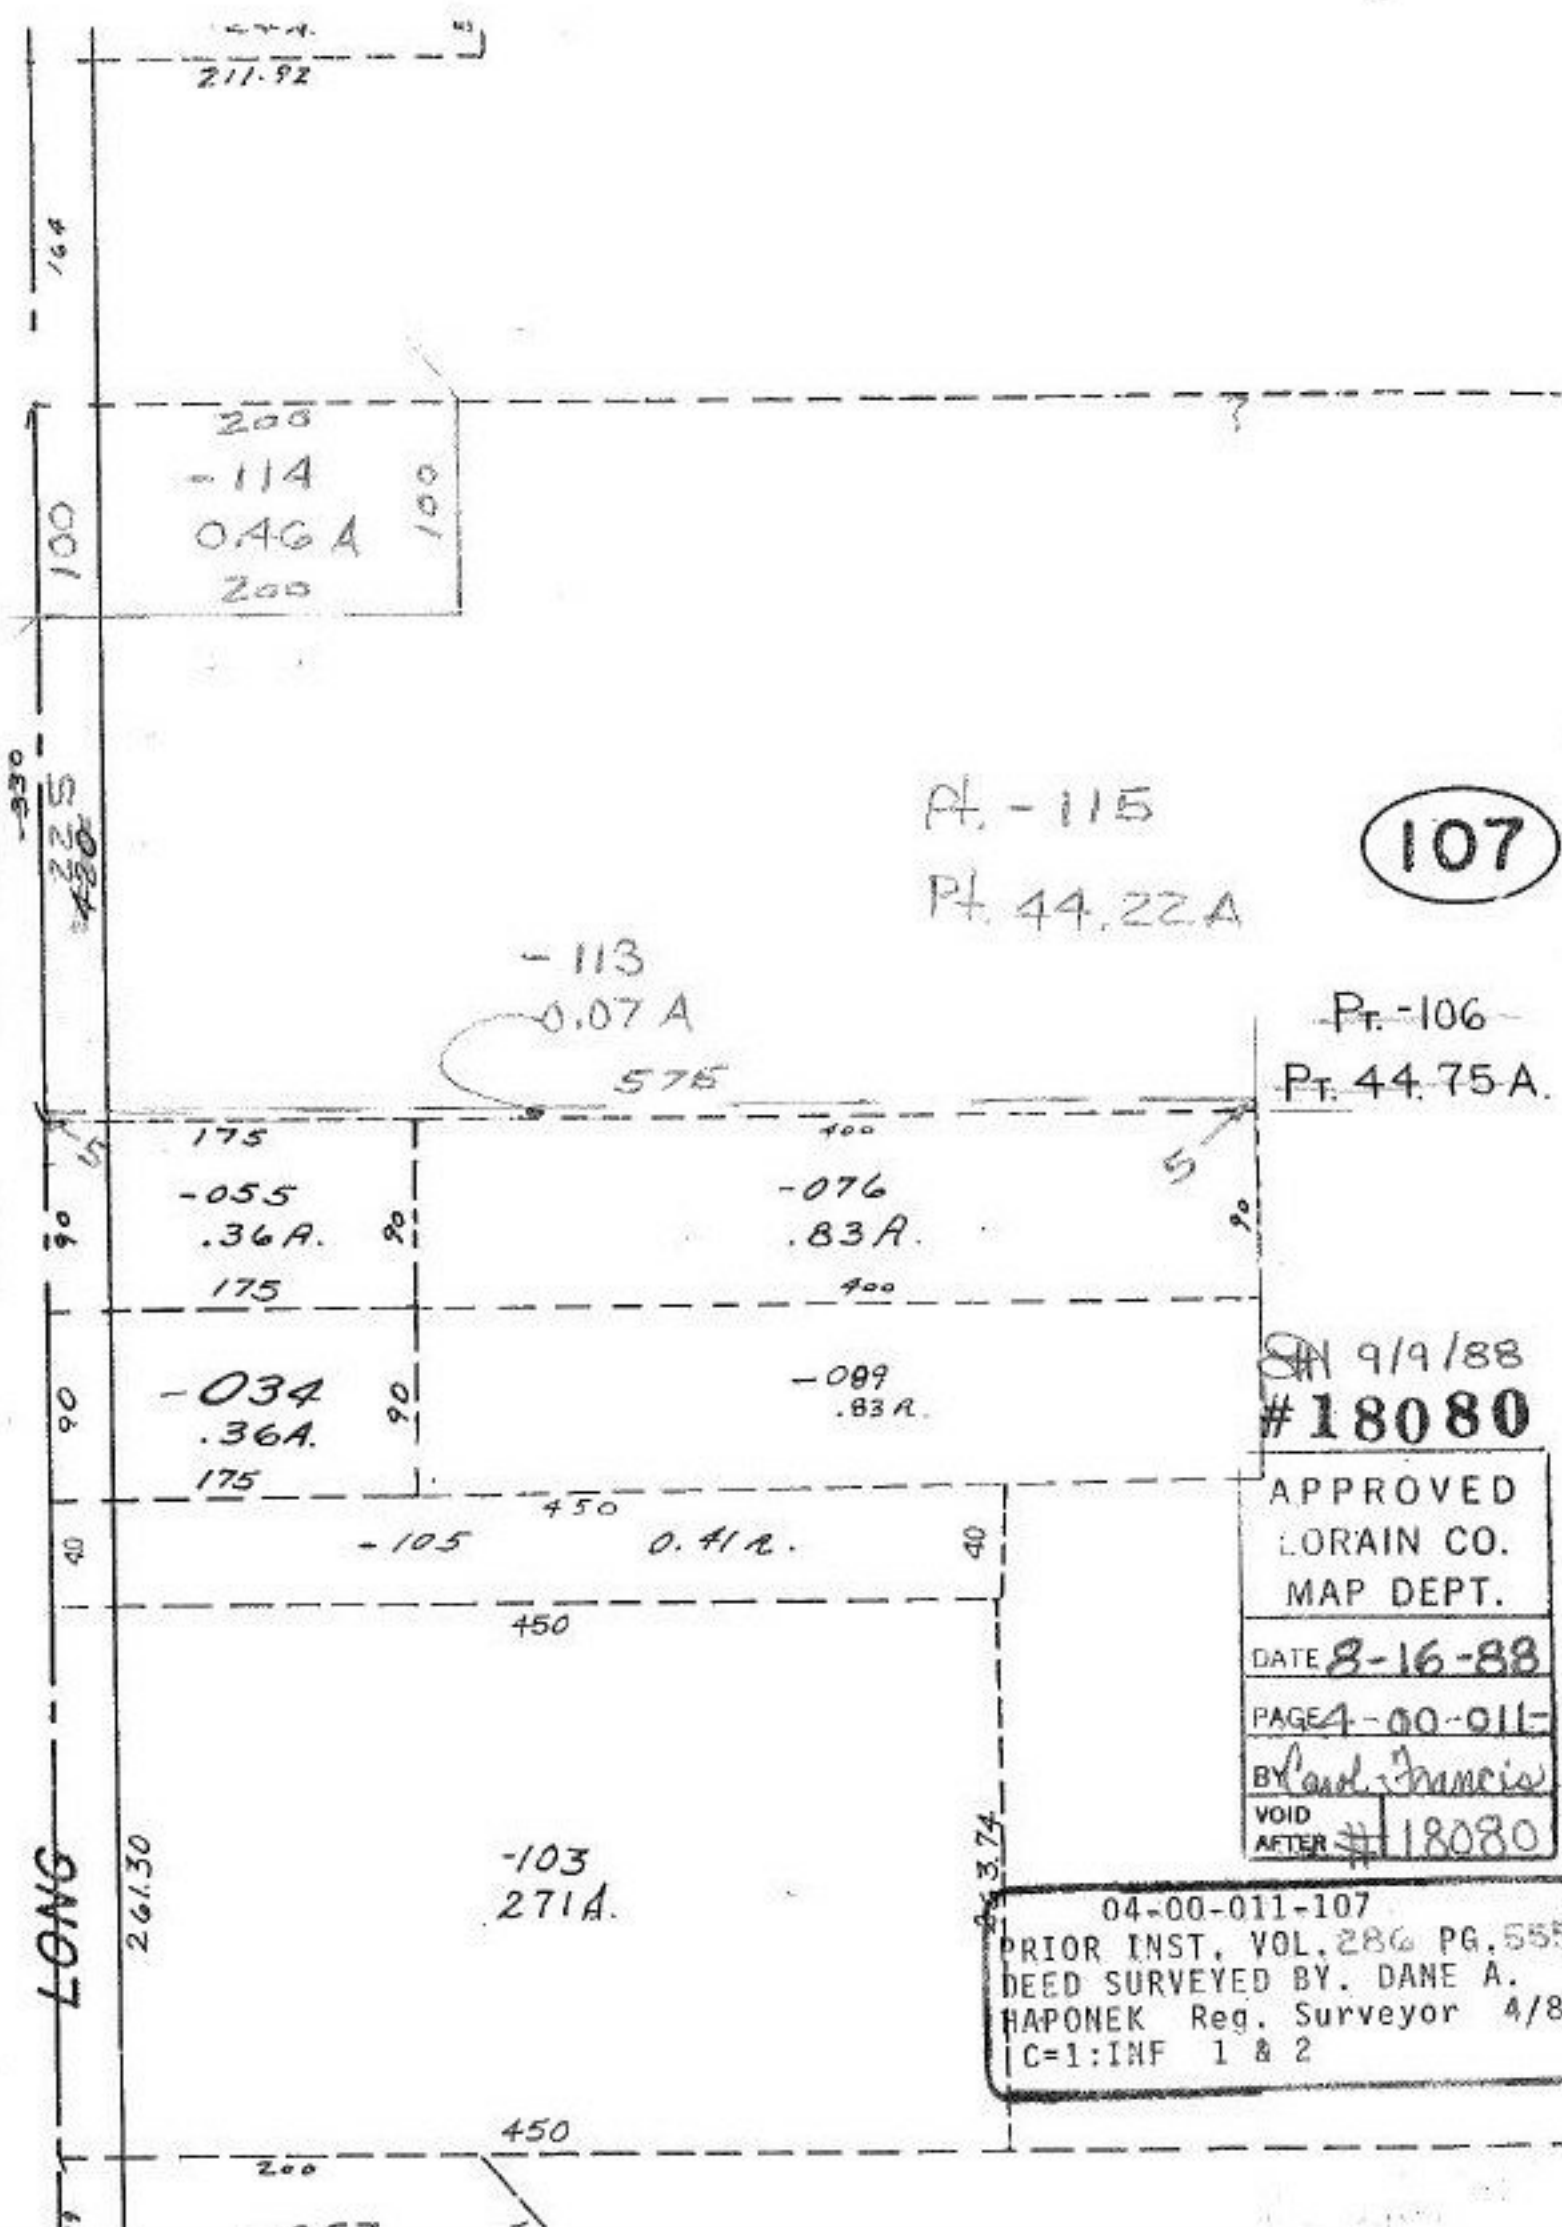

107

Pt. -115
Pt. 44.22 A

Pt. -106
Pt. 44.75 A

9/9/88
#18080

APPROVED
LORAIN CO.
MAP DEPT.

DATE 8-16-88

PAGE 4-00-011-E

BY L. Francis

VOID
AFTER #18080

04-00-011-107
PRIOR INST. VOL. 286 PG. 555
DEED SURVEYED BY. DANE A.
HAPONEK Reg. Surveyor 4/88
C=1:INF 1 & 2