


26.62

N 86° 38' W

1748.60

1061.1

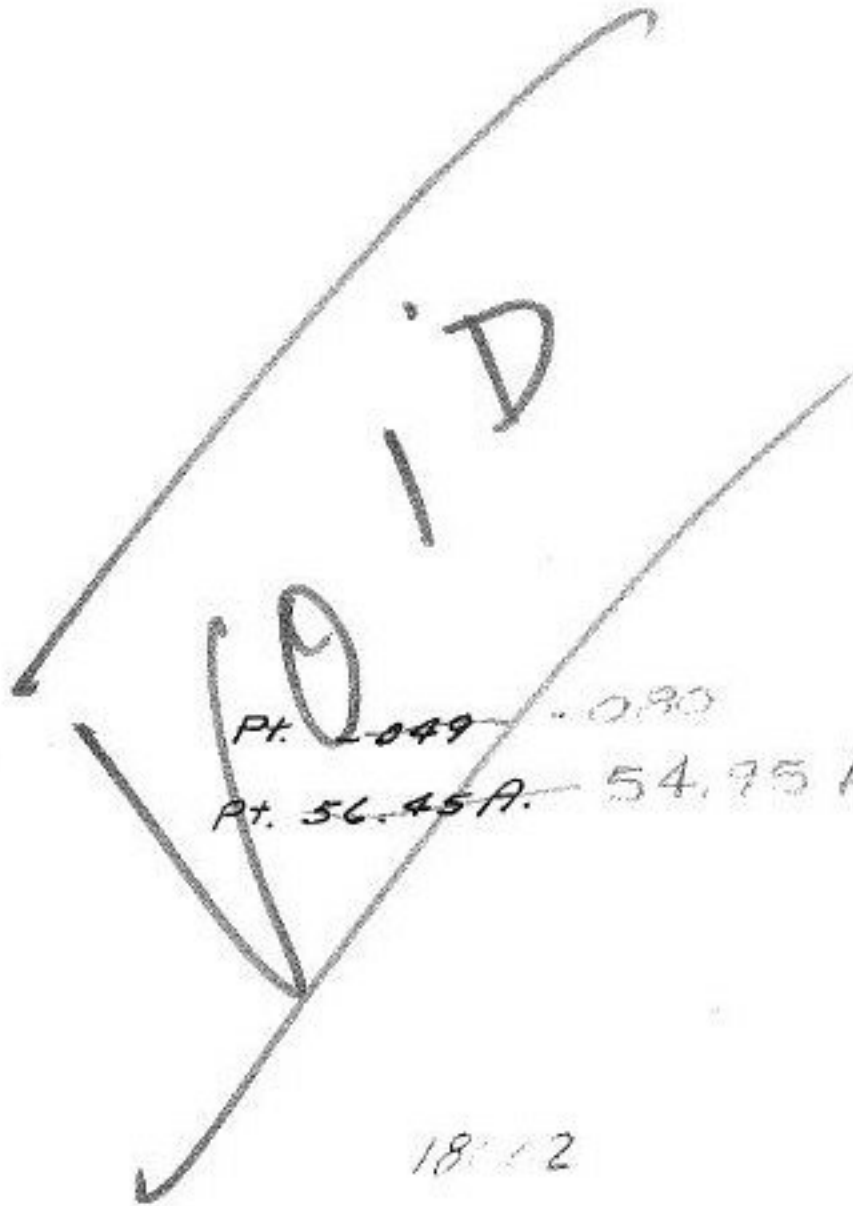

SA 2/9/89
 #18082

APPROVED
 LORAIN CO.
 MAP DEPT.

DATE 8-26-88

PAGE 5-00-009-A

BY Carolyn Francis

VOID AFTER #18082

05-00-009-000