


Pt. 66  
Pt. 66

Pt. 425 -128  
Pt. 66.83 A. 64.25 A.

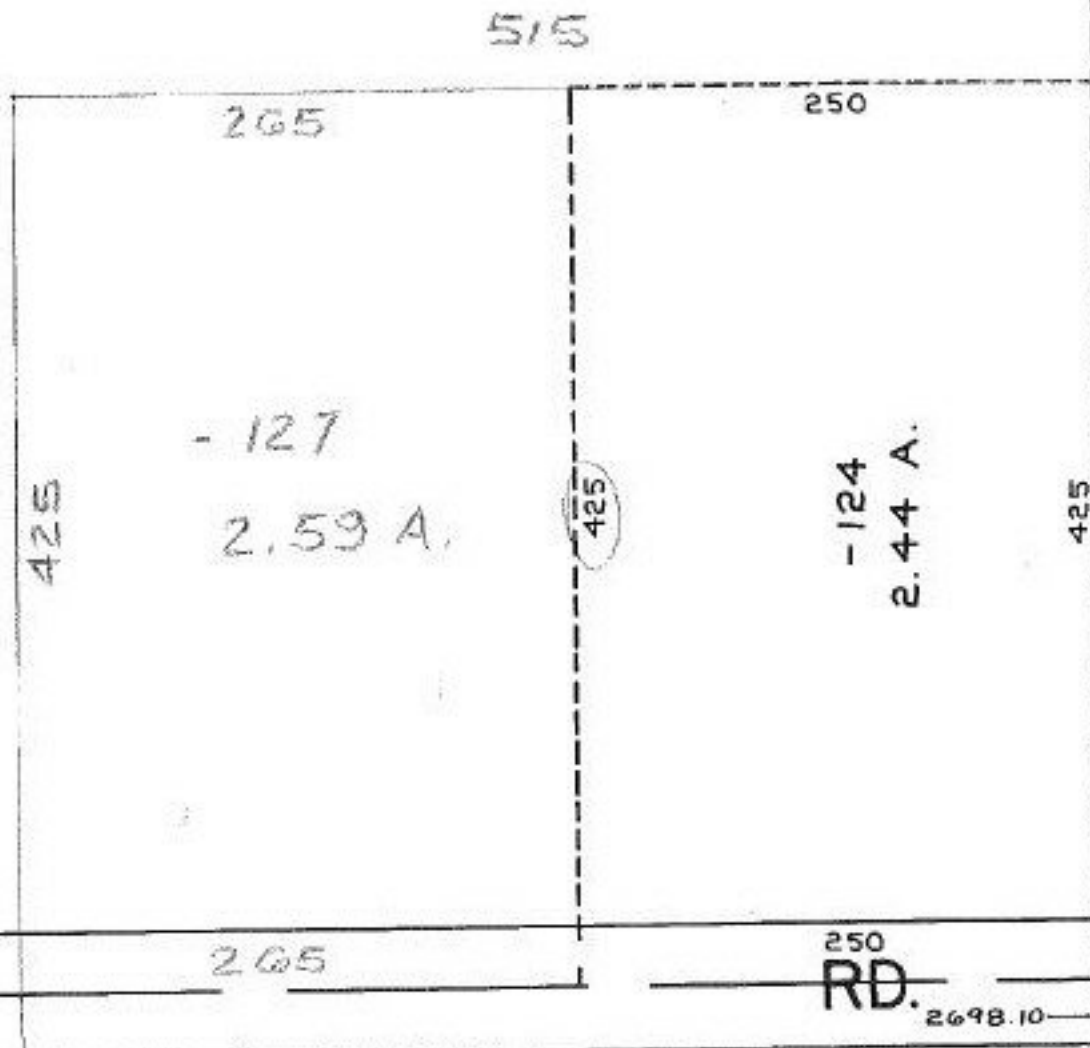

SEE 10-00-024-D

ON 9/12/88  
#18088

APPROVED  
LORAIN CO.  
MAP DEPT.

DATE 8-19-88

PAGE 10-00-024-C

BY *Carolyn Francis*

VOID AFTER #18088

310.60  
A

10-00-024-000  
PRIOR INST. V.O.R. 76 P. 66  
SURVEYED BY: JOHN POZYNAK  
Reg. Surveyor