


WHITEHEAD

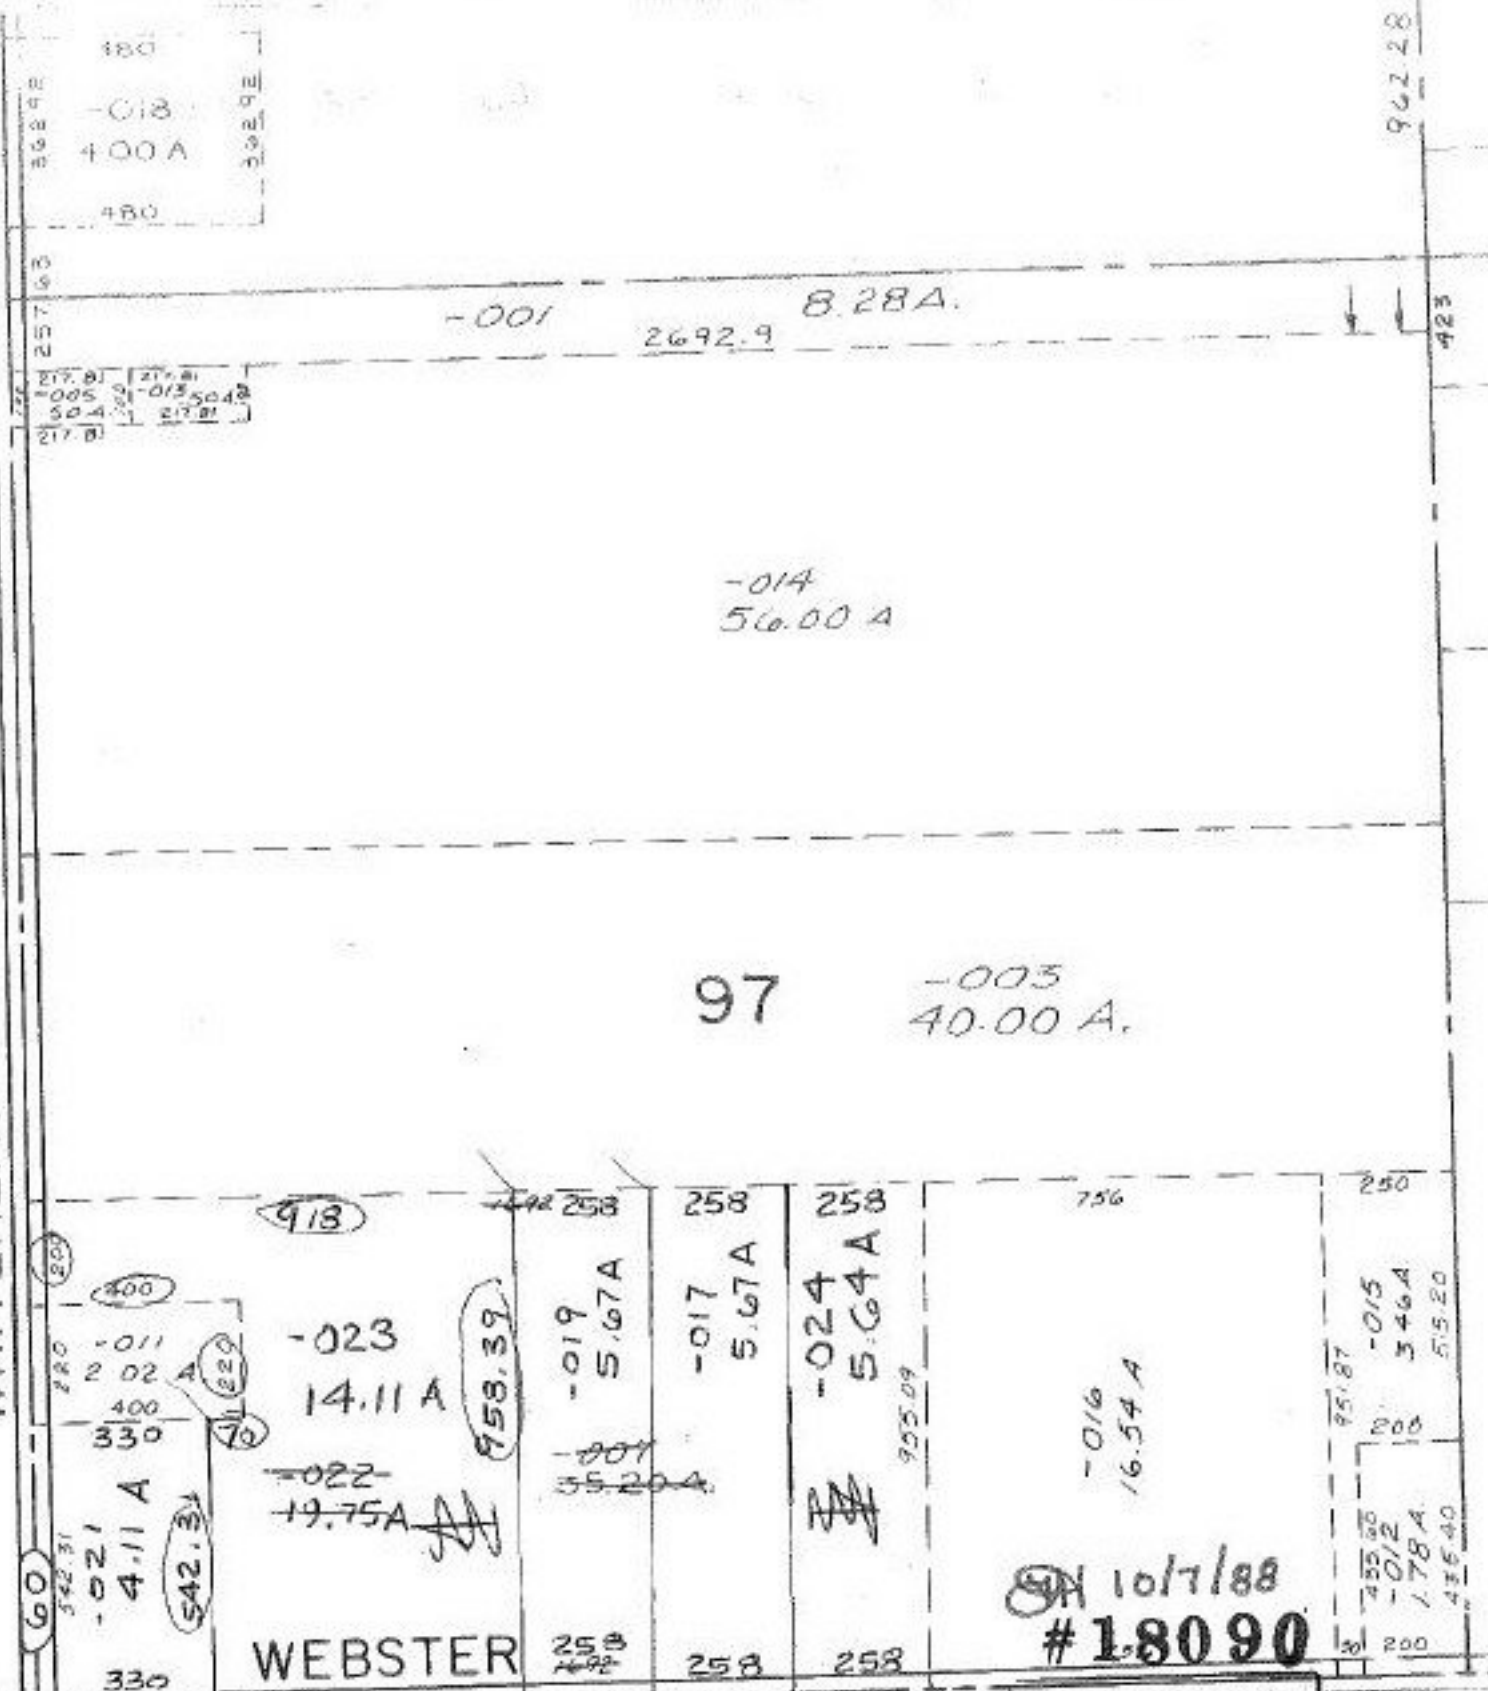

LAGRANGE

APPROVED
 LORAIN CO.
 MAP DEPT.
 DATE 9-1-83
 PAGE 15-F
 BY *Card Francis*
 VOID AFTER # 18090

TV

SCALE: 1" = 400'

15-00-097-000
 PRIOR DEED V.1297 P. 763
 SURVEYED BY CARDINAL SURVEYS
 C=1:125000.