

-052
885A.

679.70

① DV. OR 78/758

*Deed does not
Close bearing &
Distance. Missing.*

MAP CORRECTION

9/19/88
#18091-A


054
20A.

APPROVED
LORAIN CO.
MAP DEPT.
DATE 8-29-88
PAGE 4 of 4
BY <i>Cond. Starnacio</i>
VOID AFTER # 18091A

1043.11

1227.72

SEE 4-00-011-G

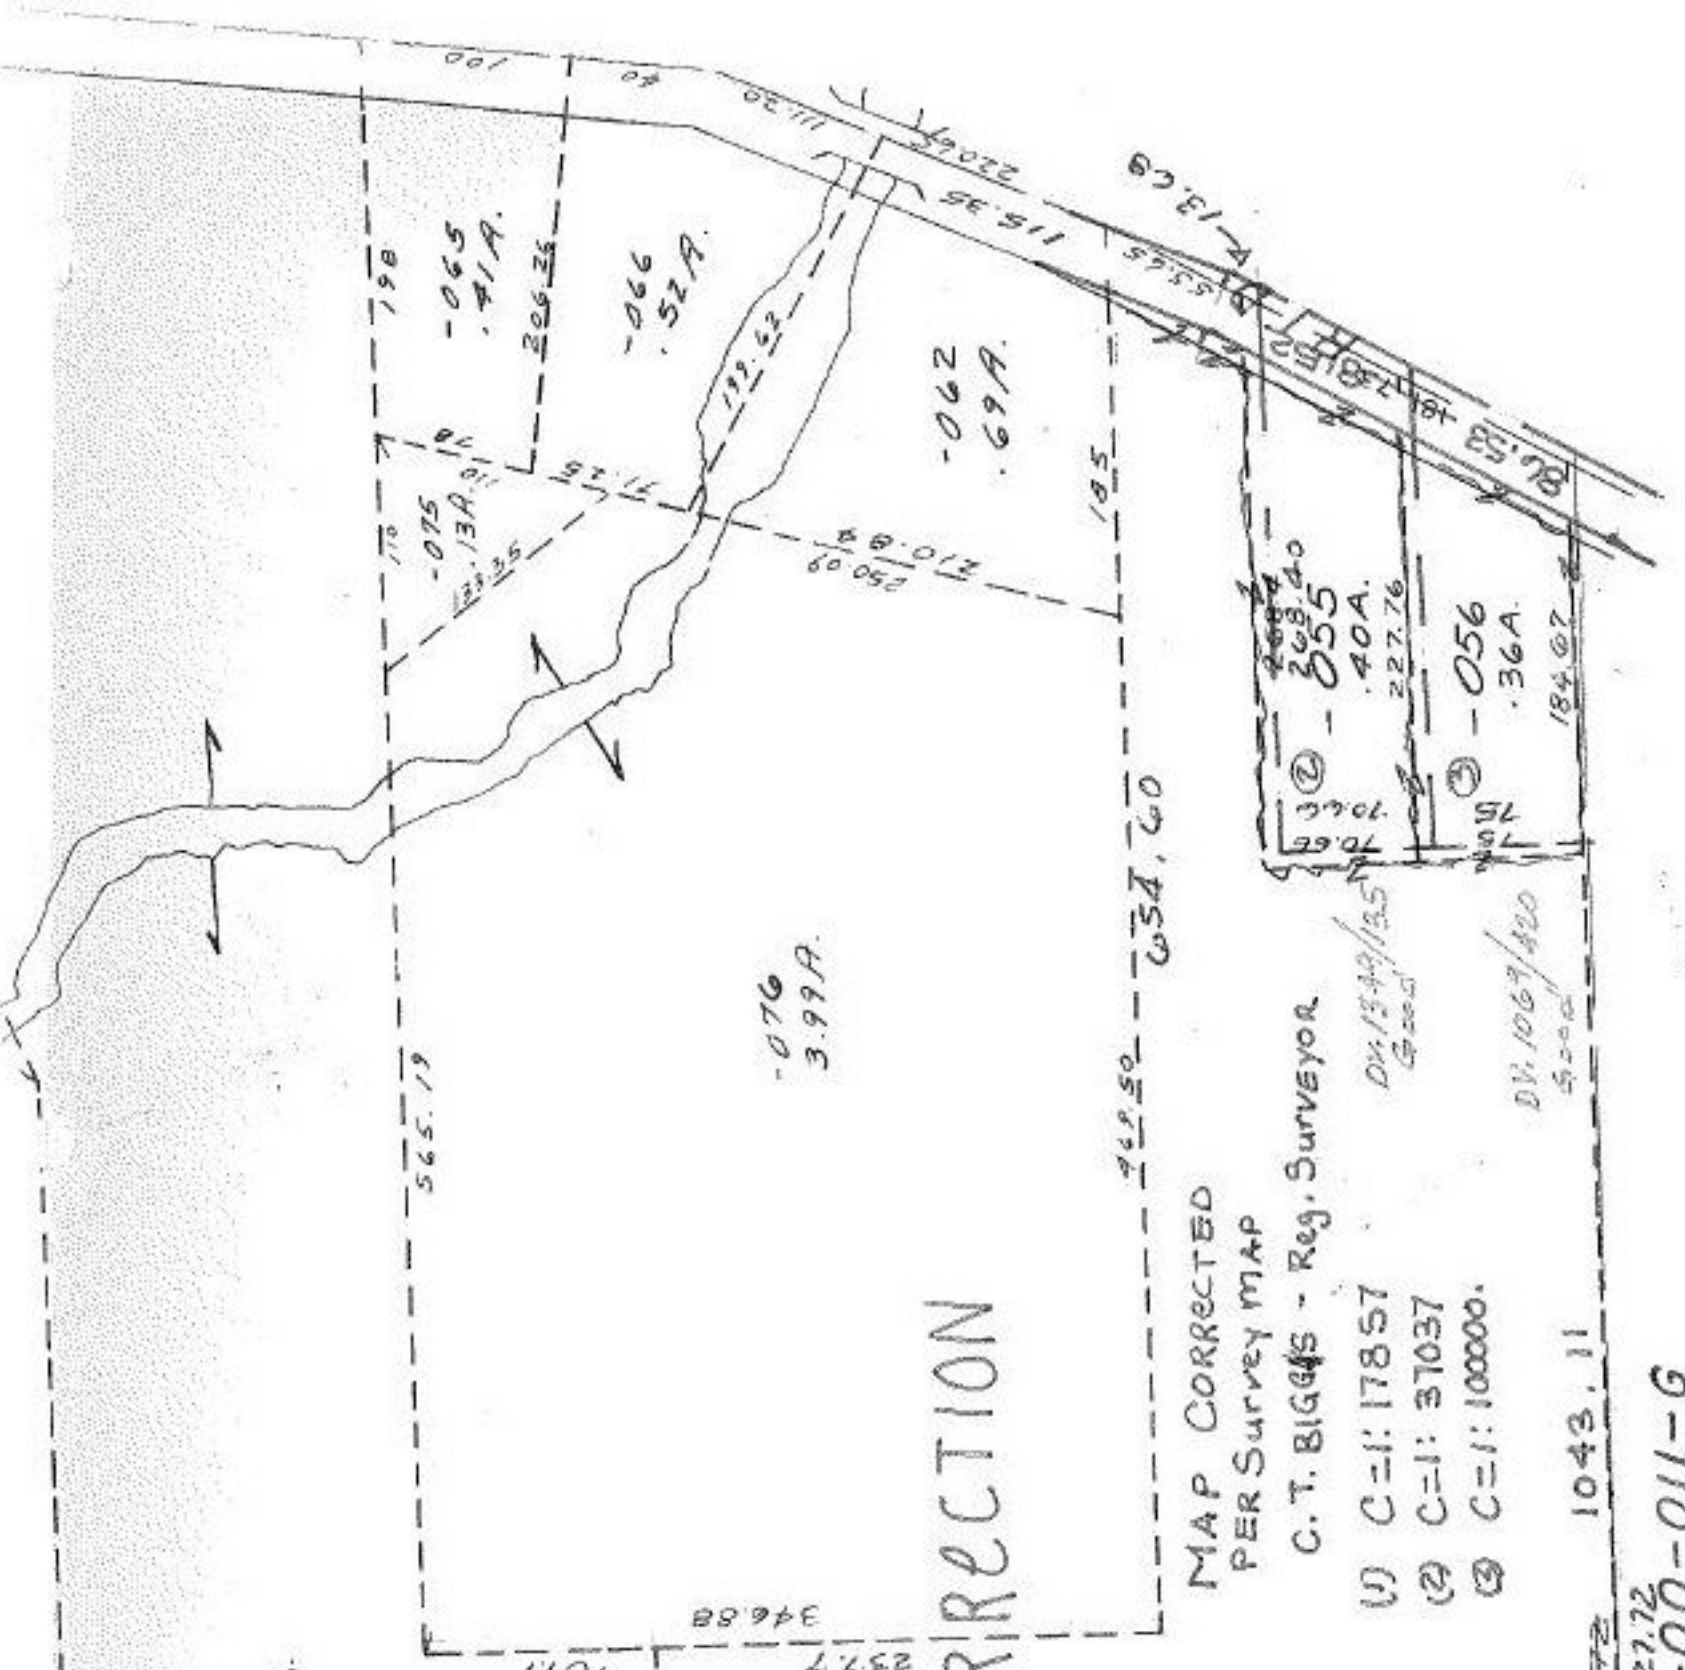

MAP CORRECTED
PER SURVEY MAP

C. T. BIGGINS - Reg. Surveyor

- (1) C=1: 17857
- (2) C=1: 37037
- (3) C=1: 100000.

DV. 1349/125
5000

DV. 1069/420
5000

1043.11

1227.72