


34

- 001
4.80F.

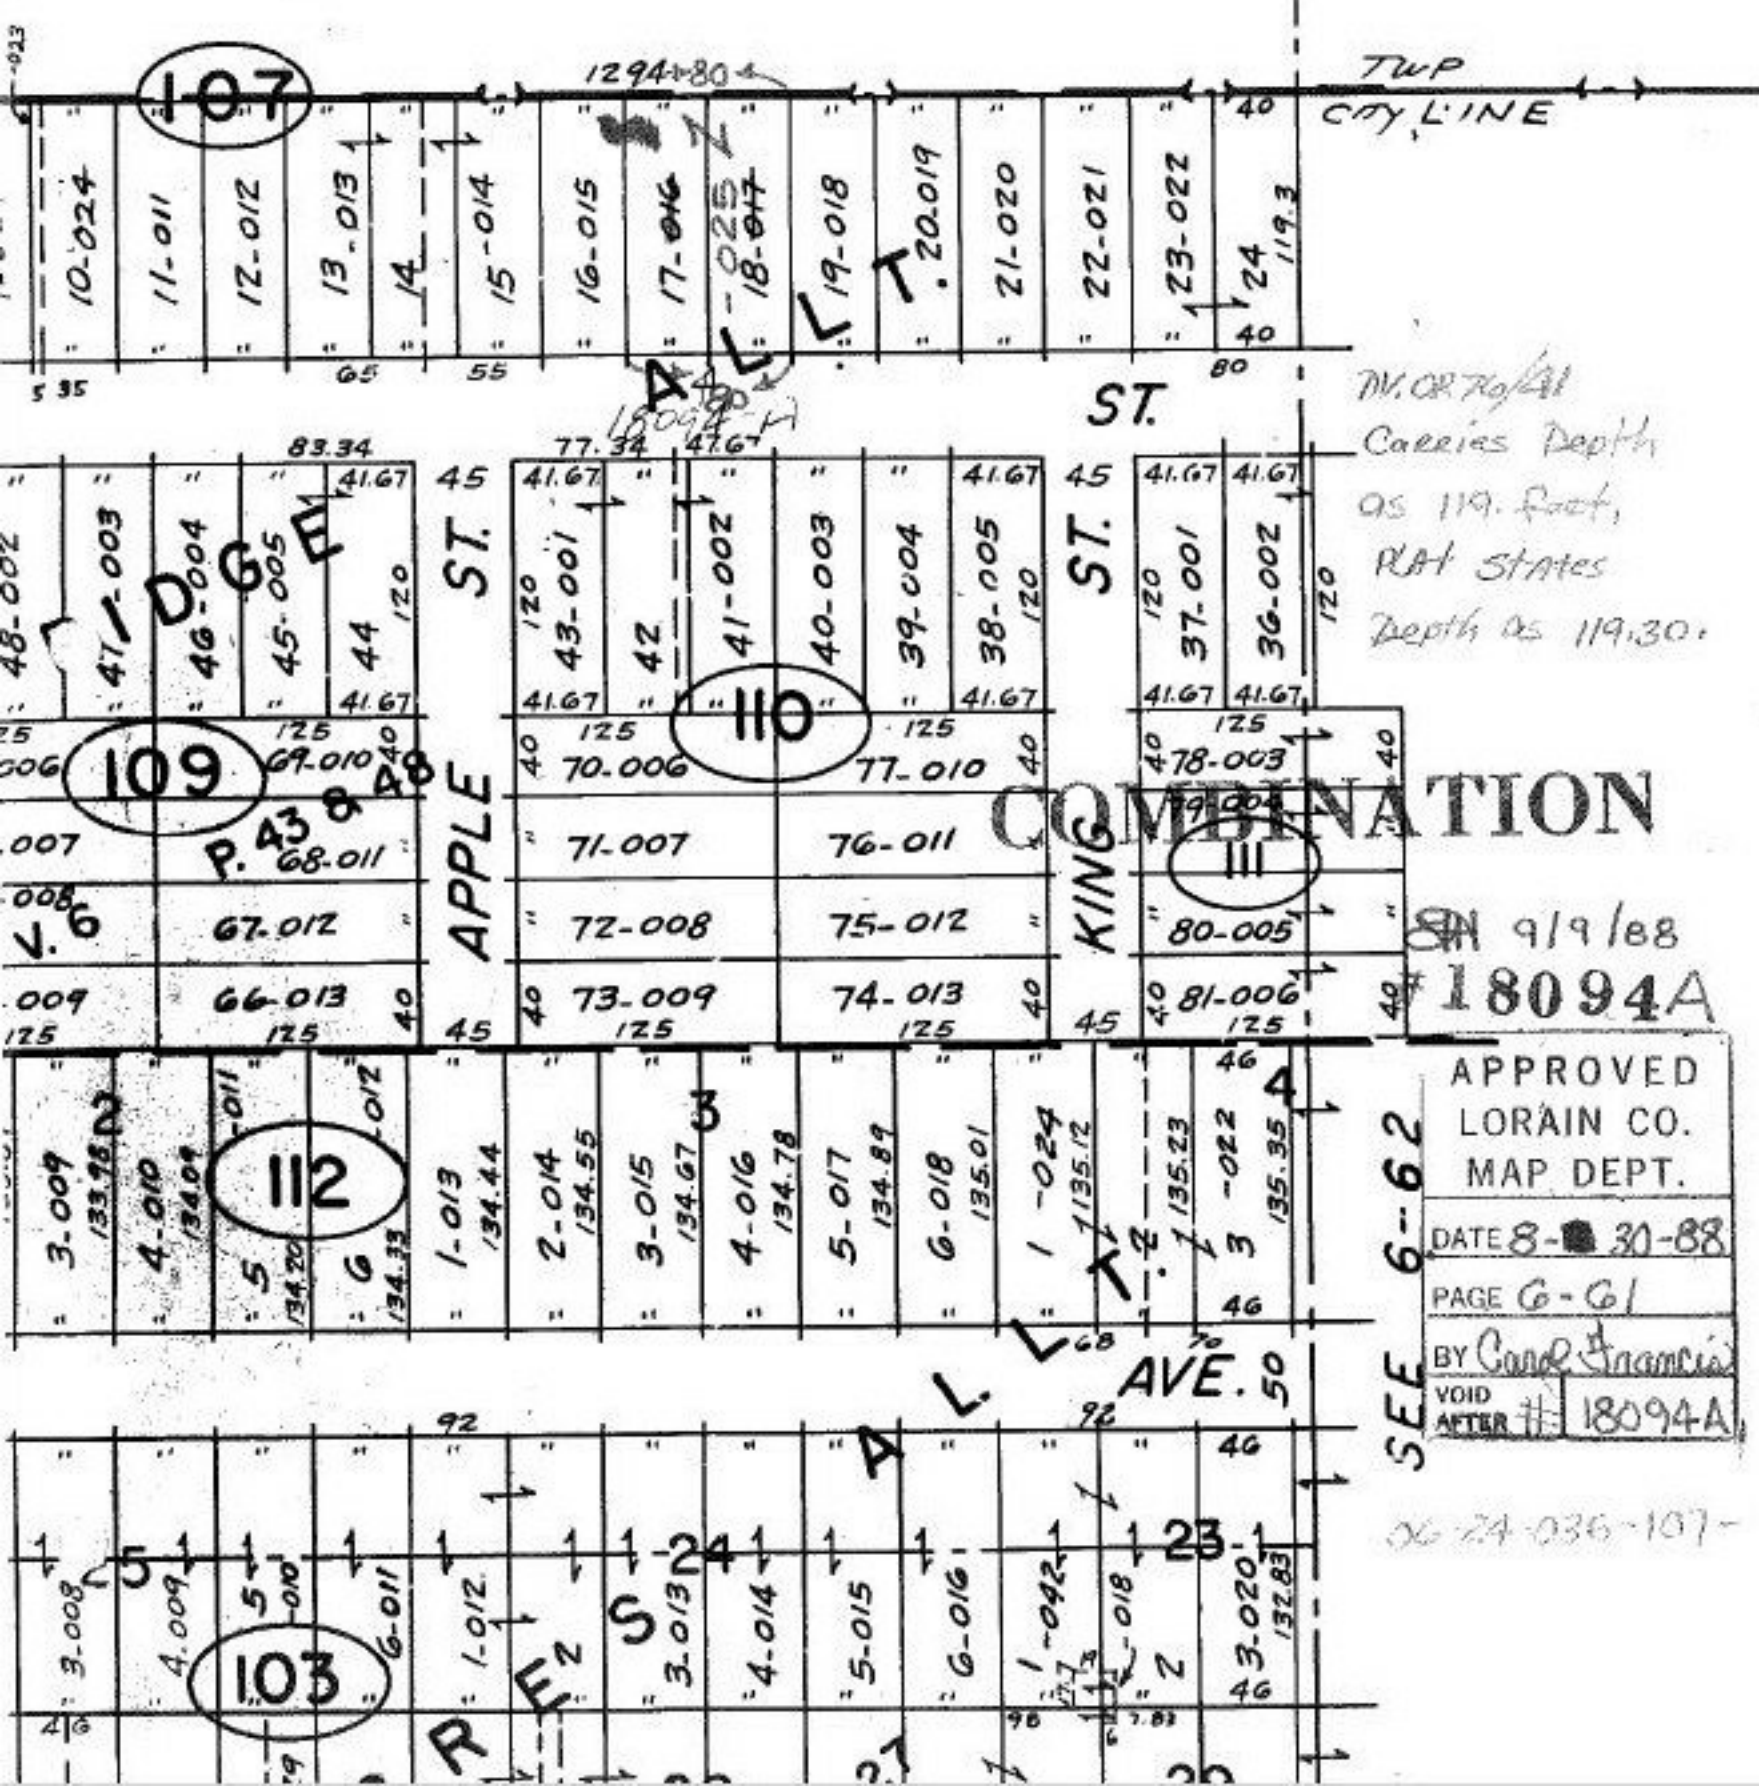

M. OR 70/41
Carries Depth
as 119. Foot,
PLAT STATES
Depth as 119.30.

COMBINATION

9/9/88
18094A

APPROVED
LORAIN CO.
MAP DEPT.
DATE 8-30-88
PAGE 6-61
BY *Cond. Francis*
VOID
AFTER # 18094A

SEE 6-62

06-24-036-107-