


= POINTS
 ▣ = SPILT DECKS

SCALE 50' = 1"

R = 25.00
 A = 24.13
 CH = 51.16
 T = 70.45
 Δ = 78° 34' 00"

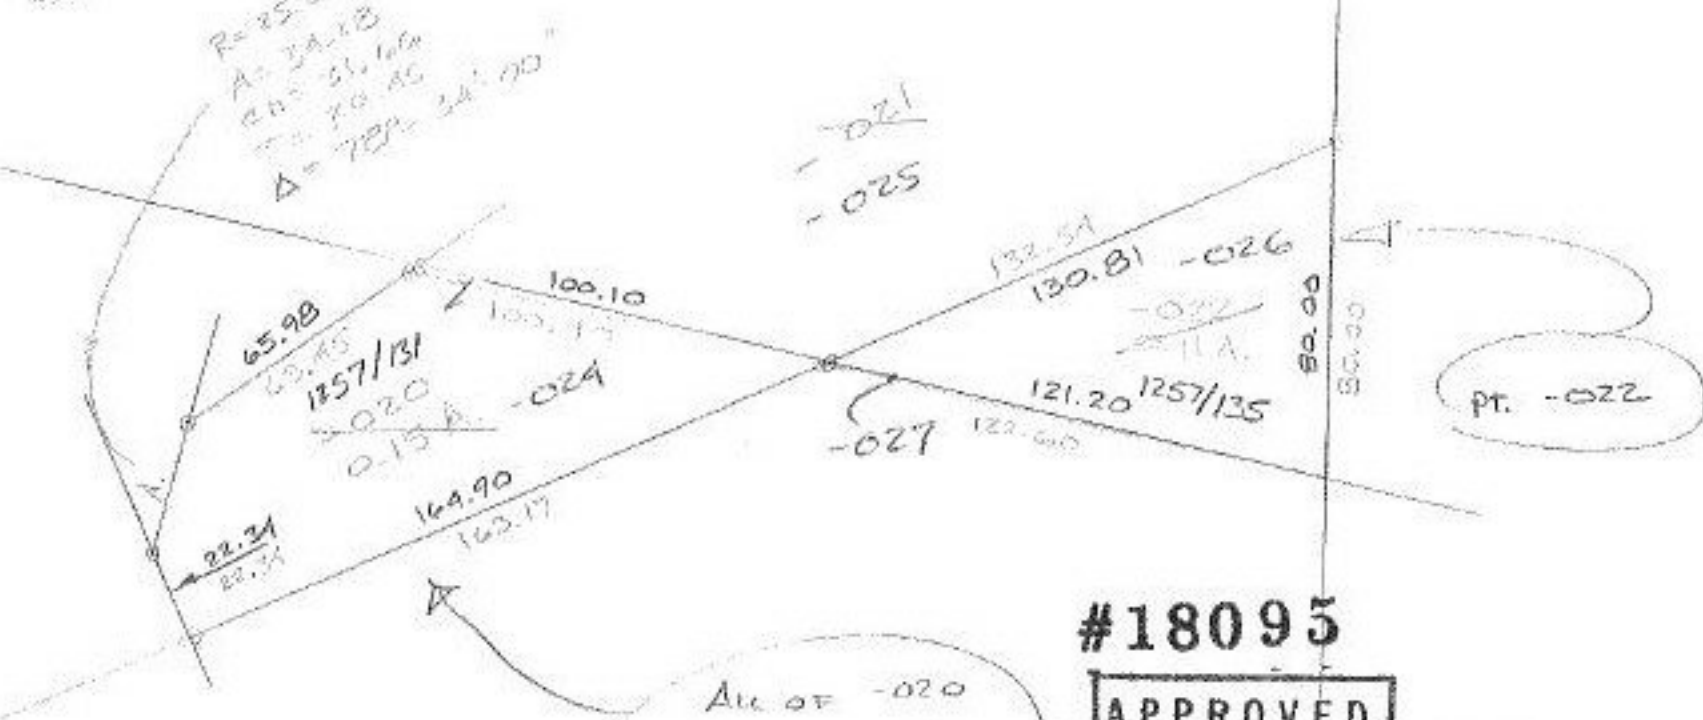

#18095

APPROVED LORAIN CO. MAP DEPT.	
DATE 10-4-88	
PAGE 1-00-017-A	
BY T. McNamee	
VOID AFTER	18095

132.54
 163.17
 295.71
 164.90
 130.81
 295.71