


E r i e

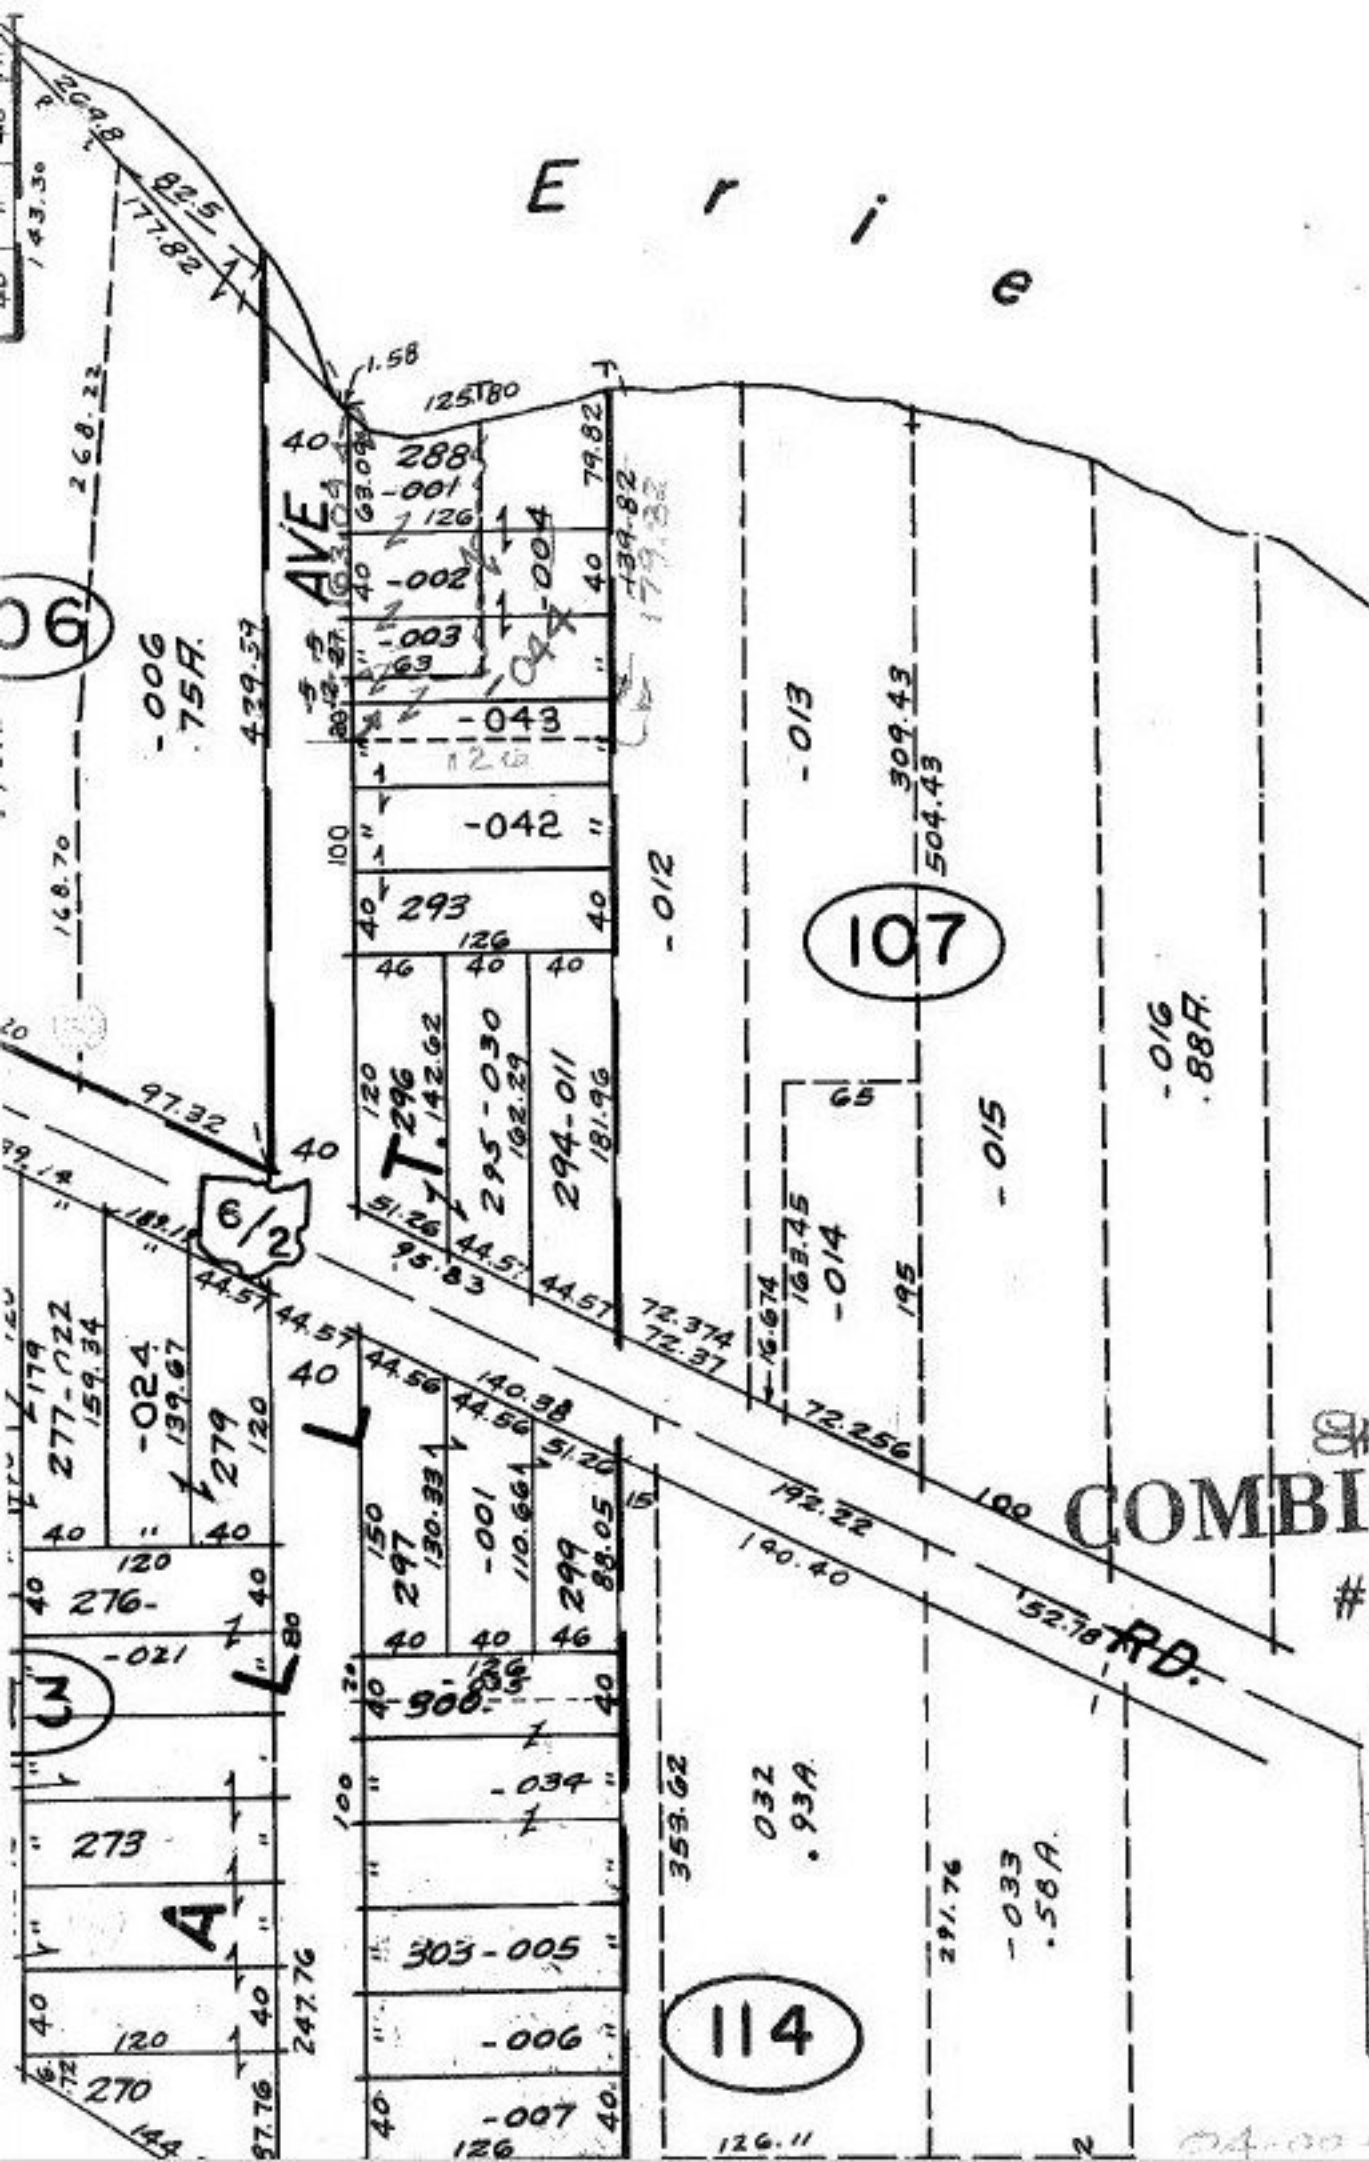

107

114

9/9/88  
COMBINATION

#18095 A

APPROVED  
LORAIN CO.  
MAP DEPT.

DATE 8-25-88

PAGE 4-00-030-C

BY CAROL FRANCIS

VOID AFTER #18095 A

04-00-030-109-