


SEE 18-0C

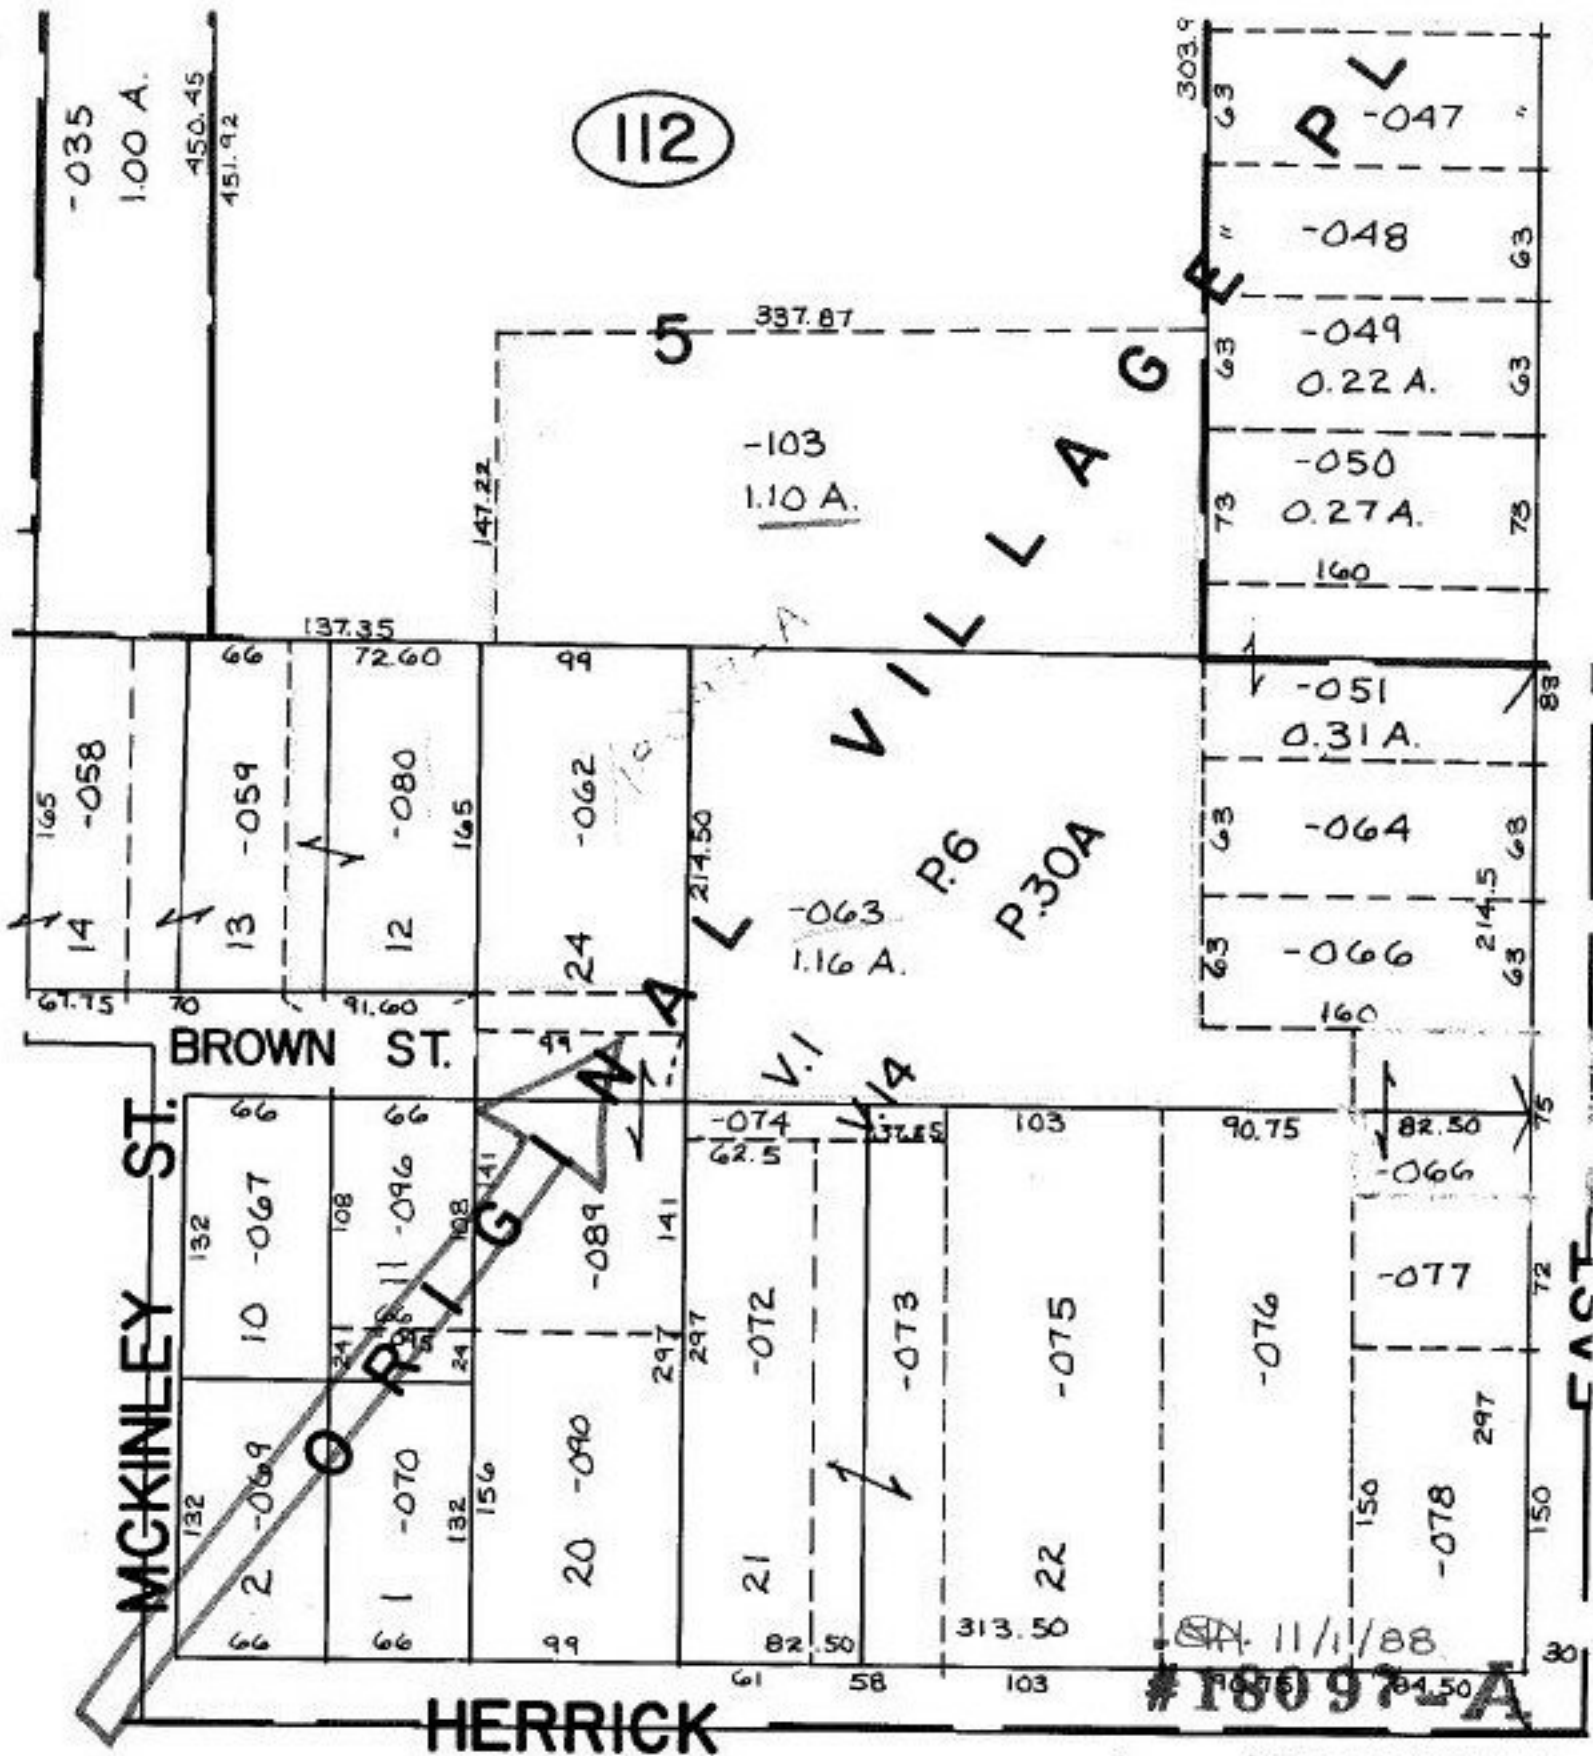

COMBINATION DENIED  
 CANNOT COMBINE SUBLOTS  
 (FRONTAGE & DEPTH) WITH ACREAGE  
 PARCELS - 063 (1.10 A.)

COMBINATION

APPROVED <b>SE</b>	
LORAIN CO. MAP DEPT.	
DATE 9-2-88	
PAGE 18-00-021-D	
BY T.M. Main	
VOID AFTER	18097-A