


1088 10  
**CROCKER**

**RD.**

**RD.**

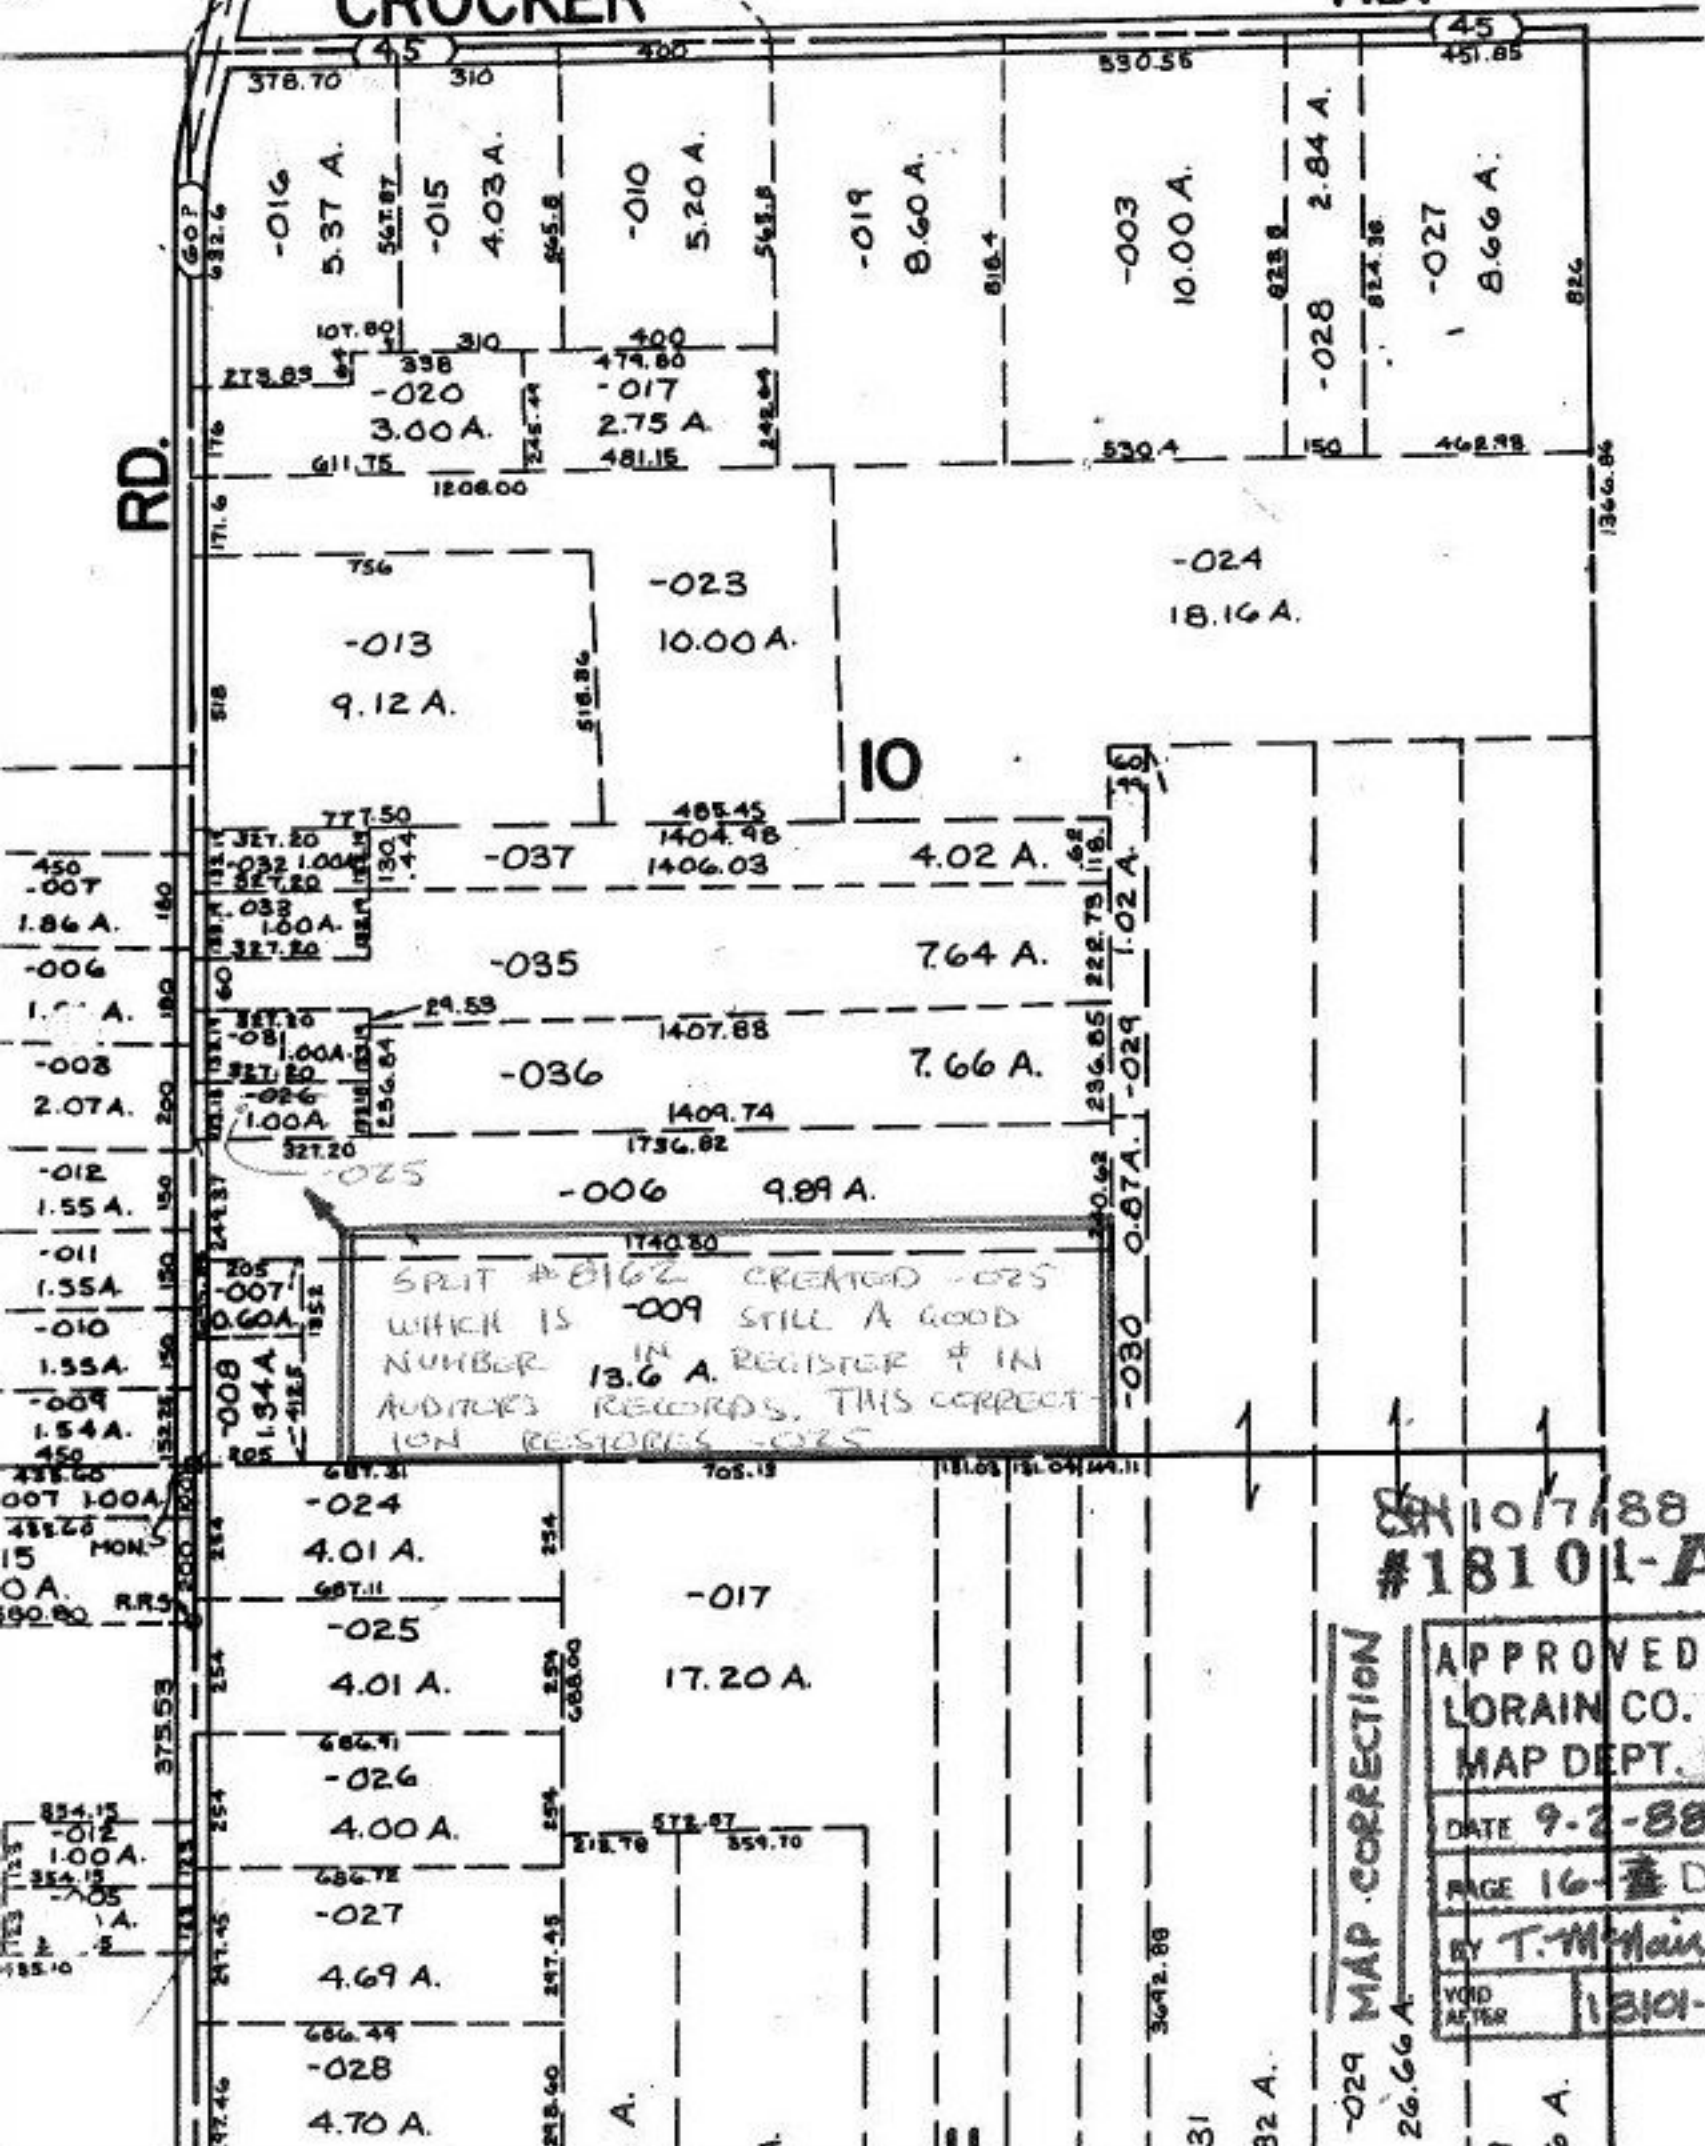

10/17/88  
#18101-A

MAP CORRECTION

APPROVED	
LORAIN CO.	
MAP DEPT.	
DATE	9-2-88
PAGE	16-D
BY	T. M. Main
VOID AFTER	18101-A

-029  
26.66 A.

82 A.

131