


K.S. ASSOC.
 SEE PLAT
 LOPERWOOD ESTS
 S03 No 4
 C-1: INF.

#18103
 Pt. -077 - 079
 Pt. 20.58 A. 18.41 A

*FOR DIM.
 ON FILE*

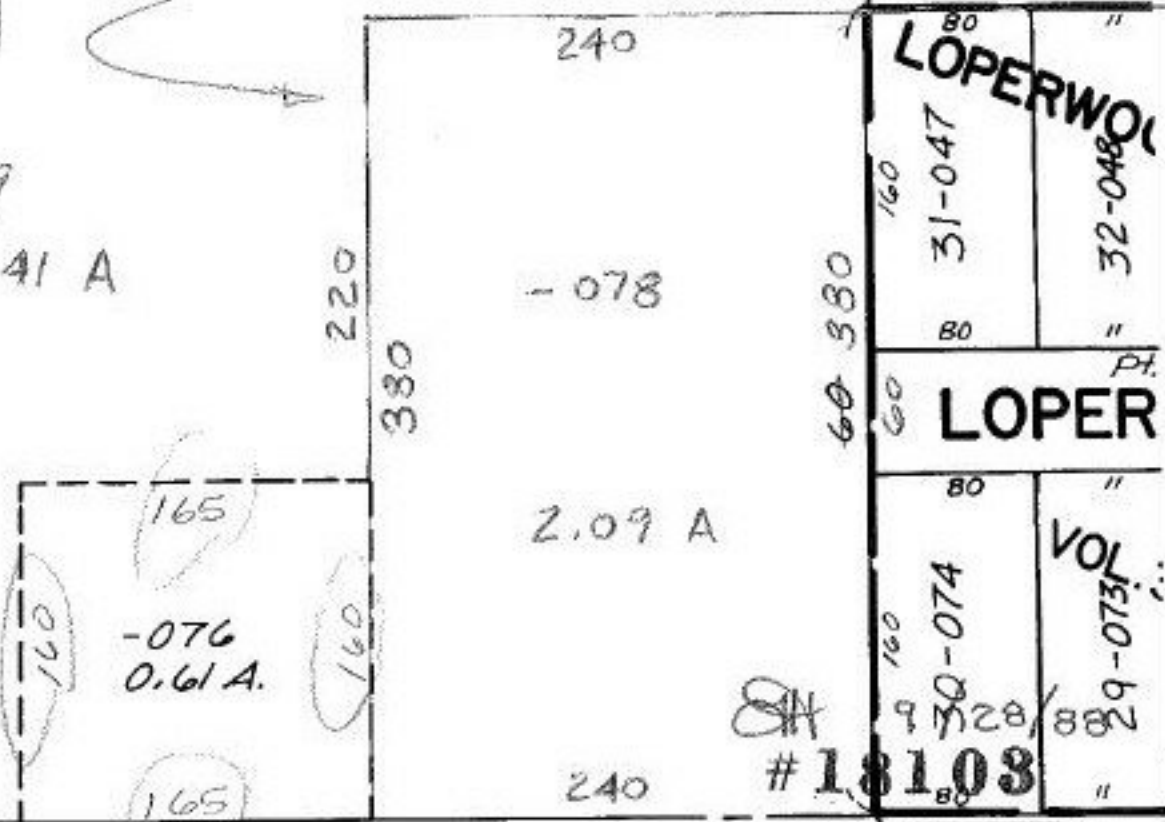

SEE 15-00-045-A

APPROVED
 LORAIN CO.
 MAP DEPT.
 DATE 9-1-88
 PAGE 15-00-036A
 BY *Cam Francis*
 VOID AFTER #18103

15-00-036-000-
 PRIOR DEED V.1177 P. 742
 SURVEYED BY: K.S. ASSOC.
 C-1: INF.