


SEE SURVEY MAP - G. PENNINGTON
 EL. 1: 500,000
 PRIOR DEED 1121/912

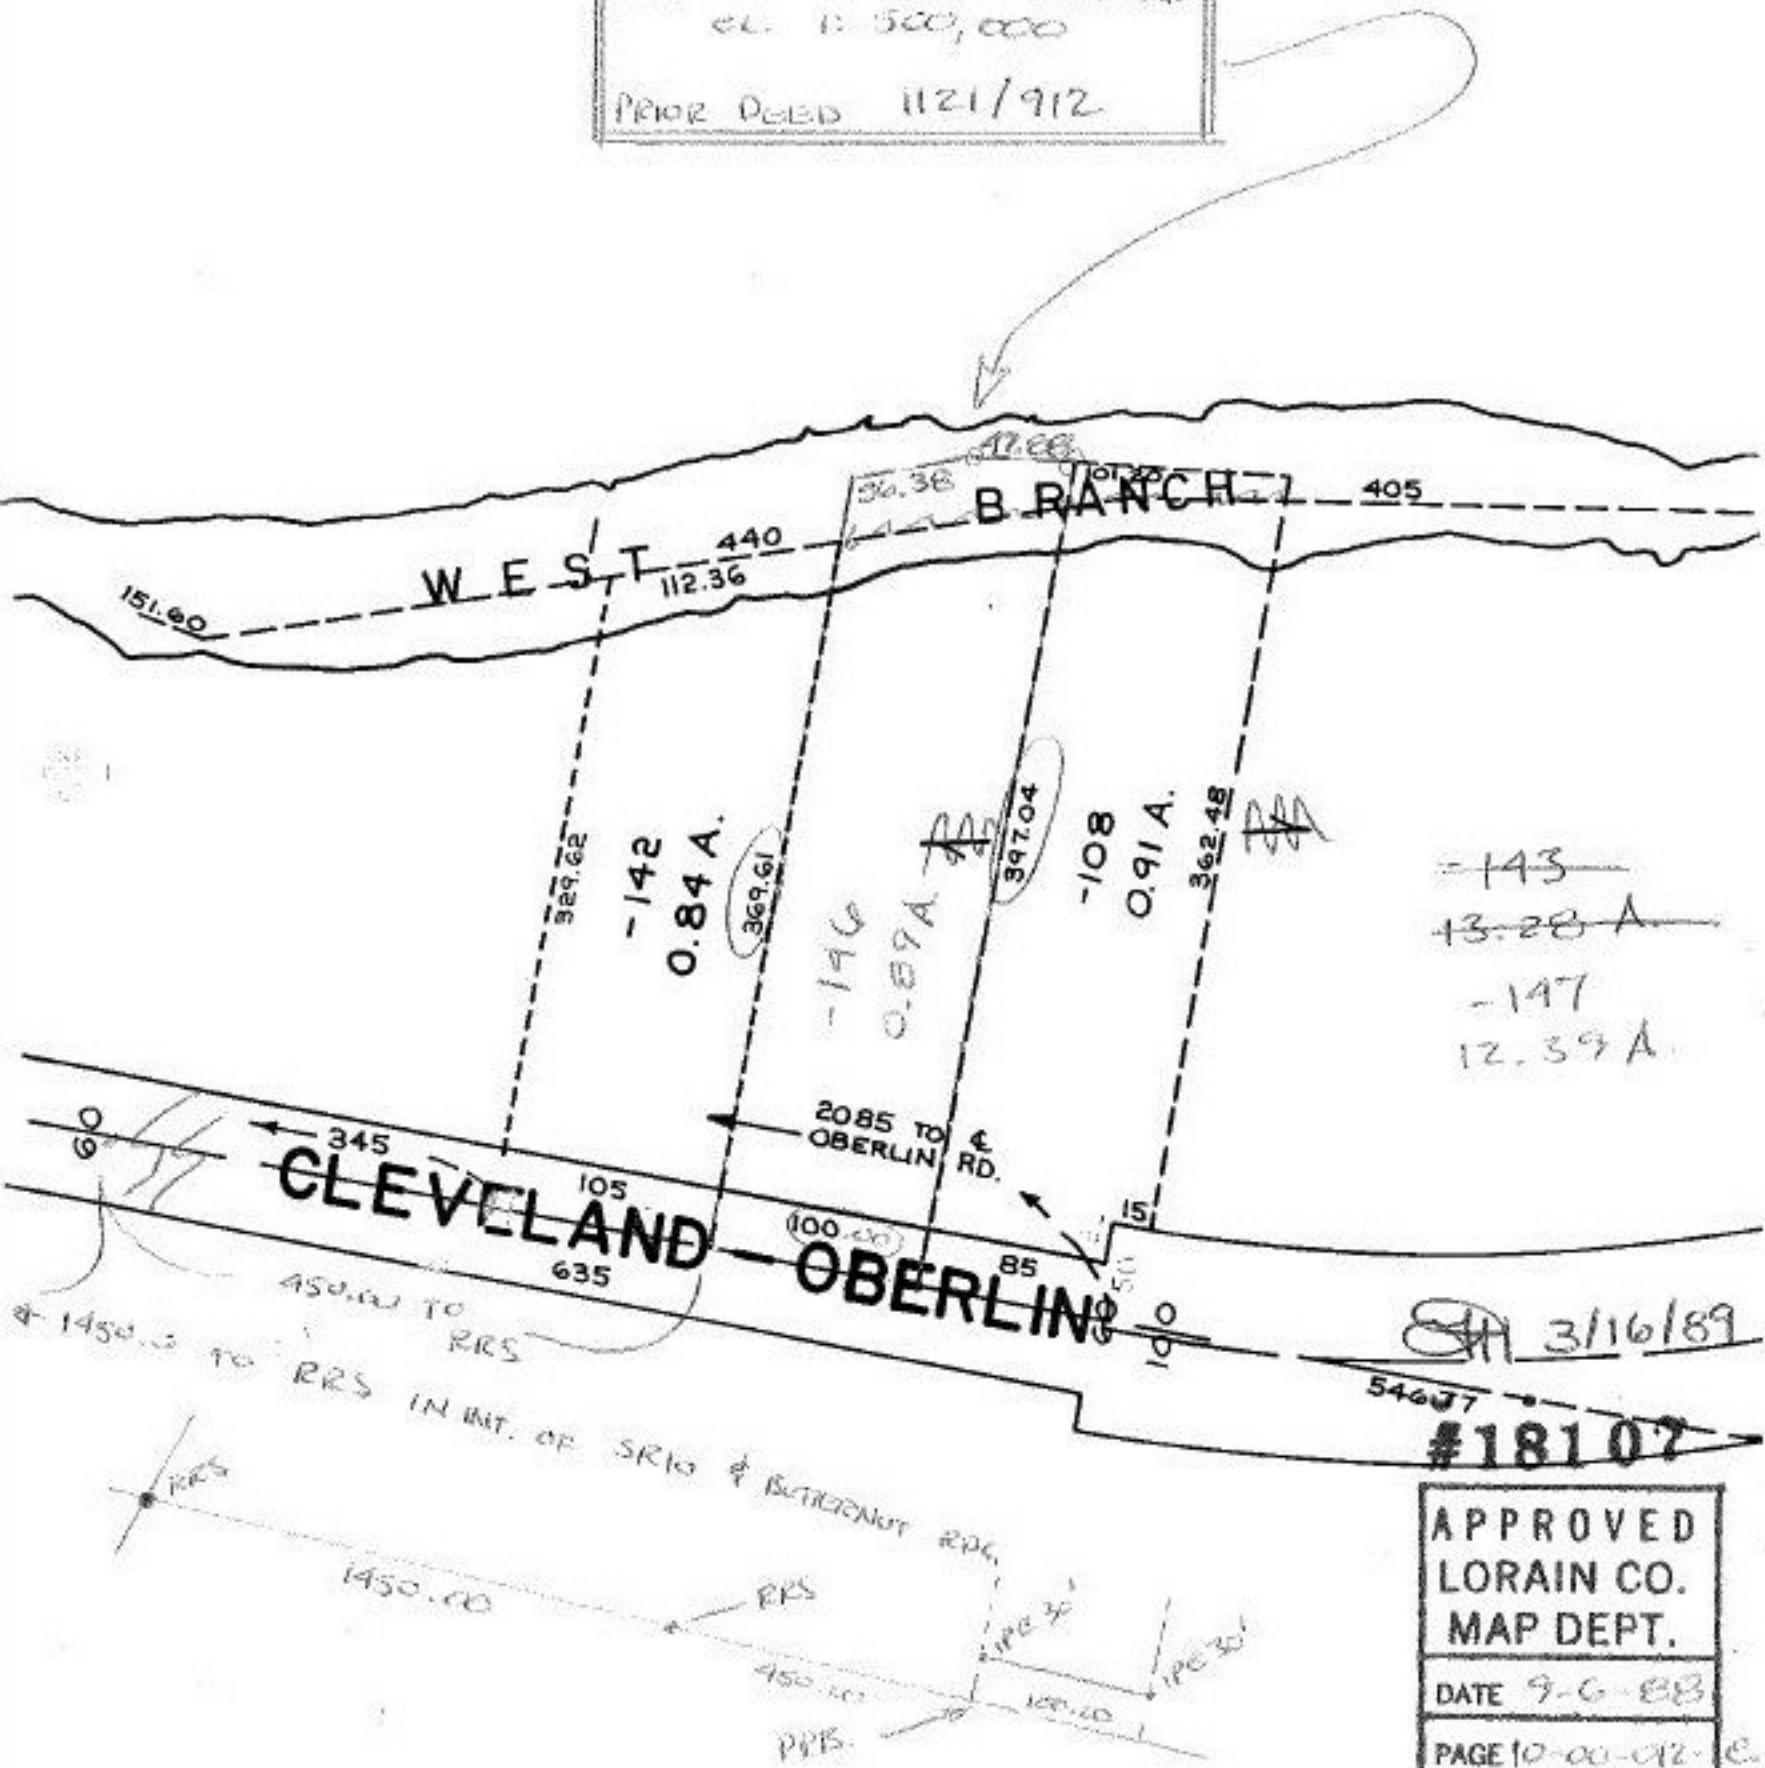

APPROVED
 LORAIN CO.
 MAP DEPT.
 DATE 9-6-88
 PAGE 10-00-012-C
 BY T. McMan
 VOID AFTER 18107