




34

-001  
4.80A.

-026

TWP  
CITY LINE

107

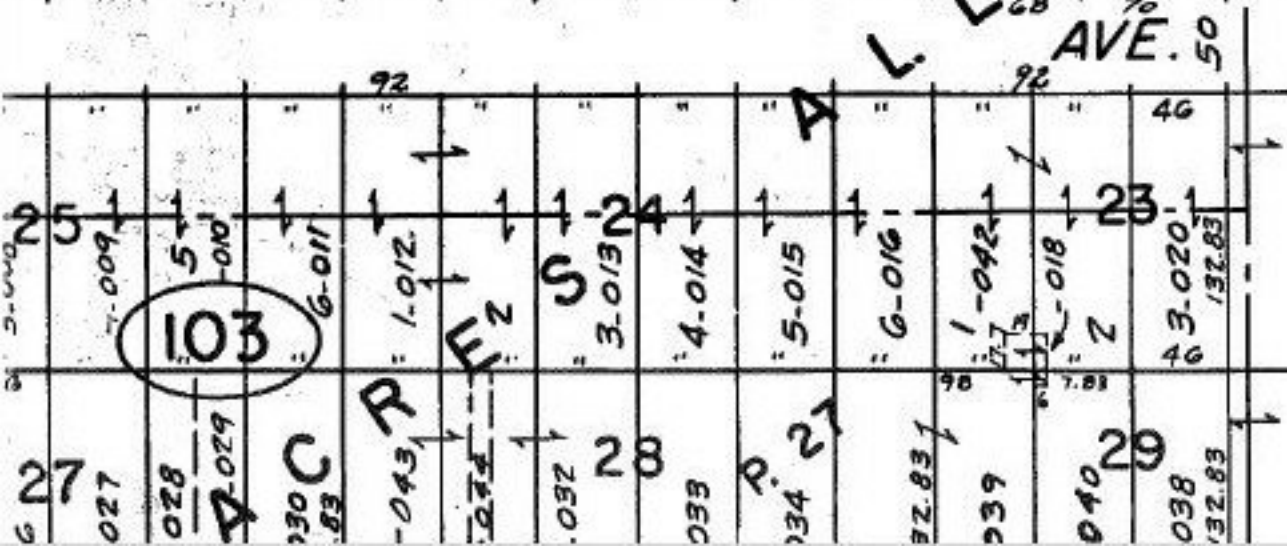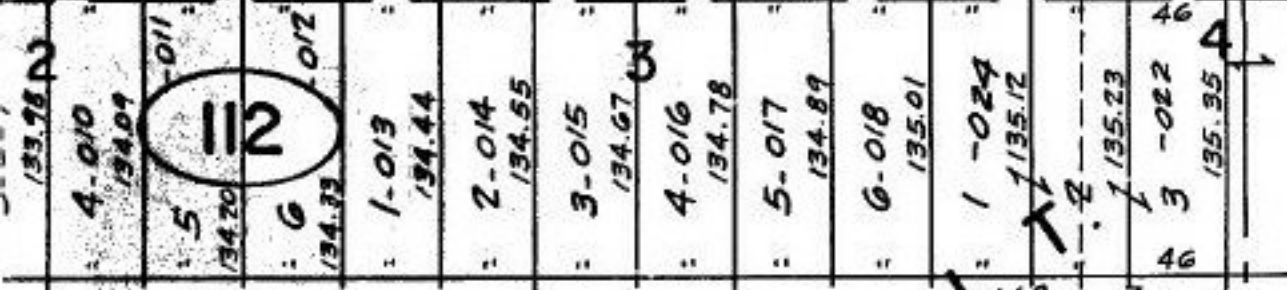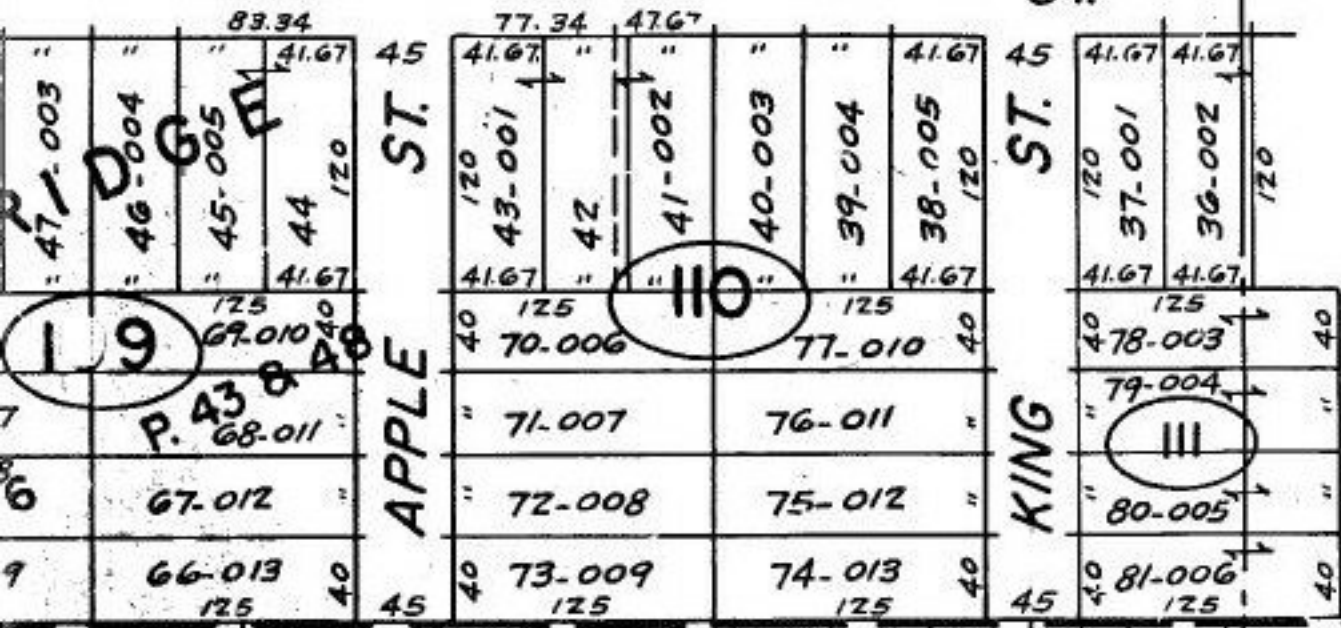

SEE 6-62

9/9/88  
#18108

APPROVED LORAIN CO. MAP DEPT.
DATE 9-7-88
PAGE 6-61
BY Carol Farris
VOID AFTER # 18108

06-24-036-107