


008  
2.98 A.

-017 4.83 A.

81

914.58  
3.65 A.

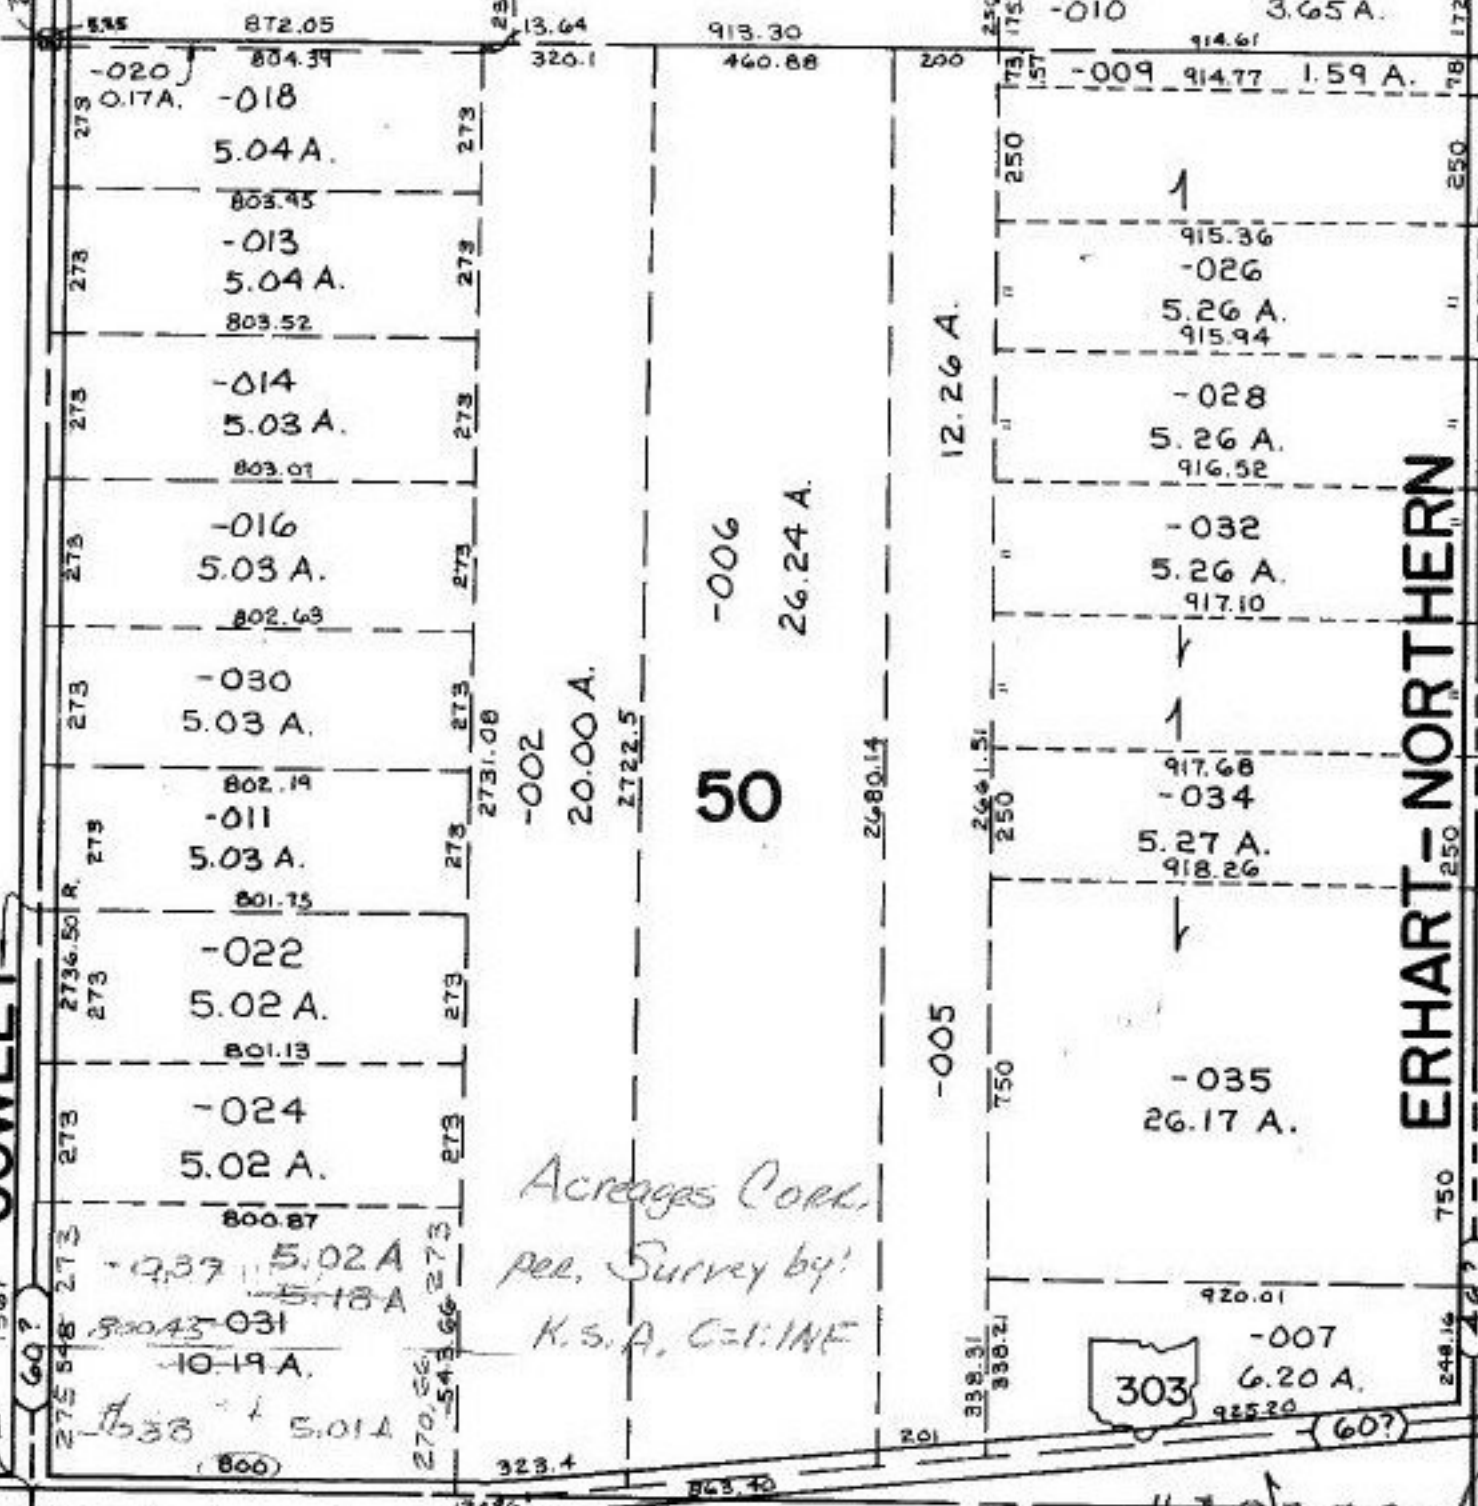

COWLEY

ERHART-NORTHERN

50

Acreages Corr.  
per Survey by:  
K.S.A. C.E.I.N.F.

303

13  
33  
50

57

RD.

# ACREAGE CORRECTION

16-00-050-000

#18110-A  
5/3/88

REVISED

APPROVED	<b>16-C</b>
LORAIN MAP DEPT.	
DATE 9-13-88	
PAGE 16-D	
BY Carolyn Jones	
VOID AFTER #18110-A	