


PT. 03-00-033-109.030
PT. 1.84A

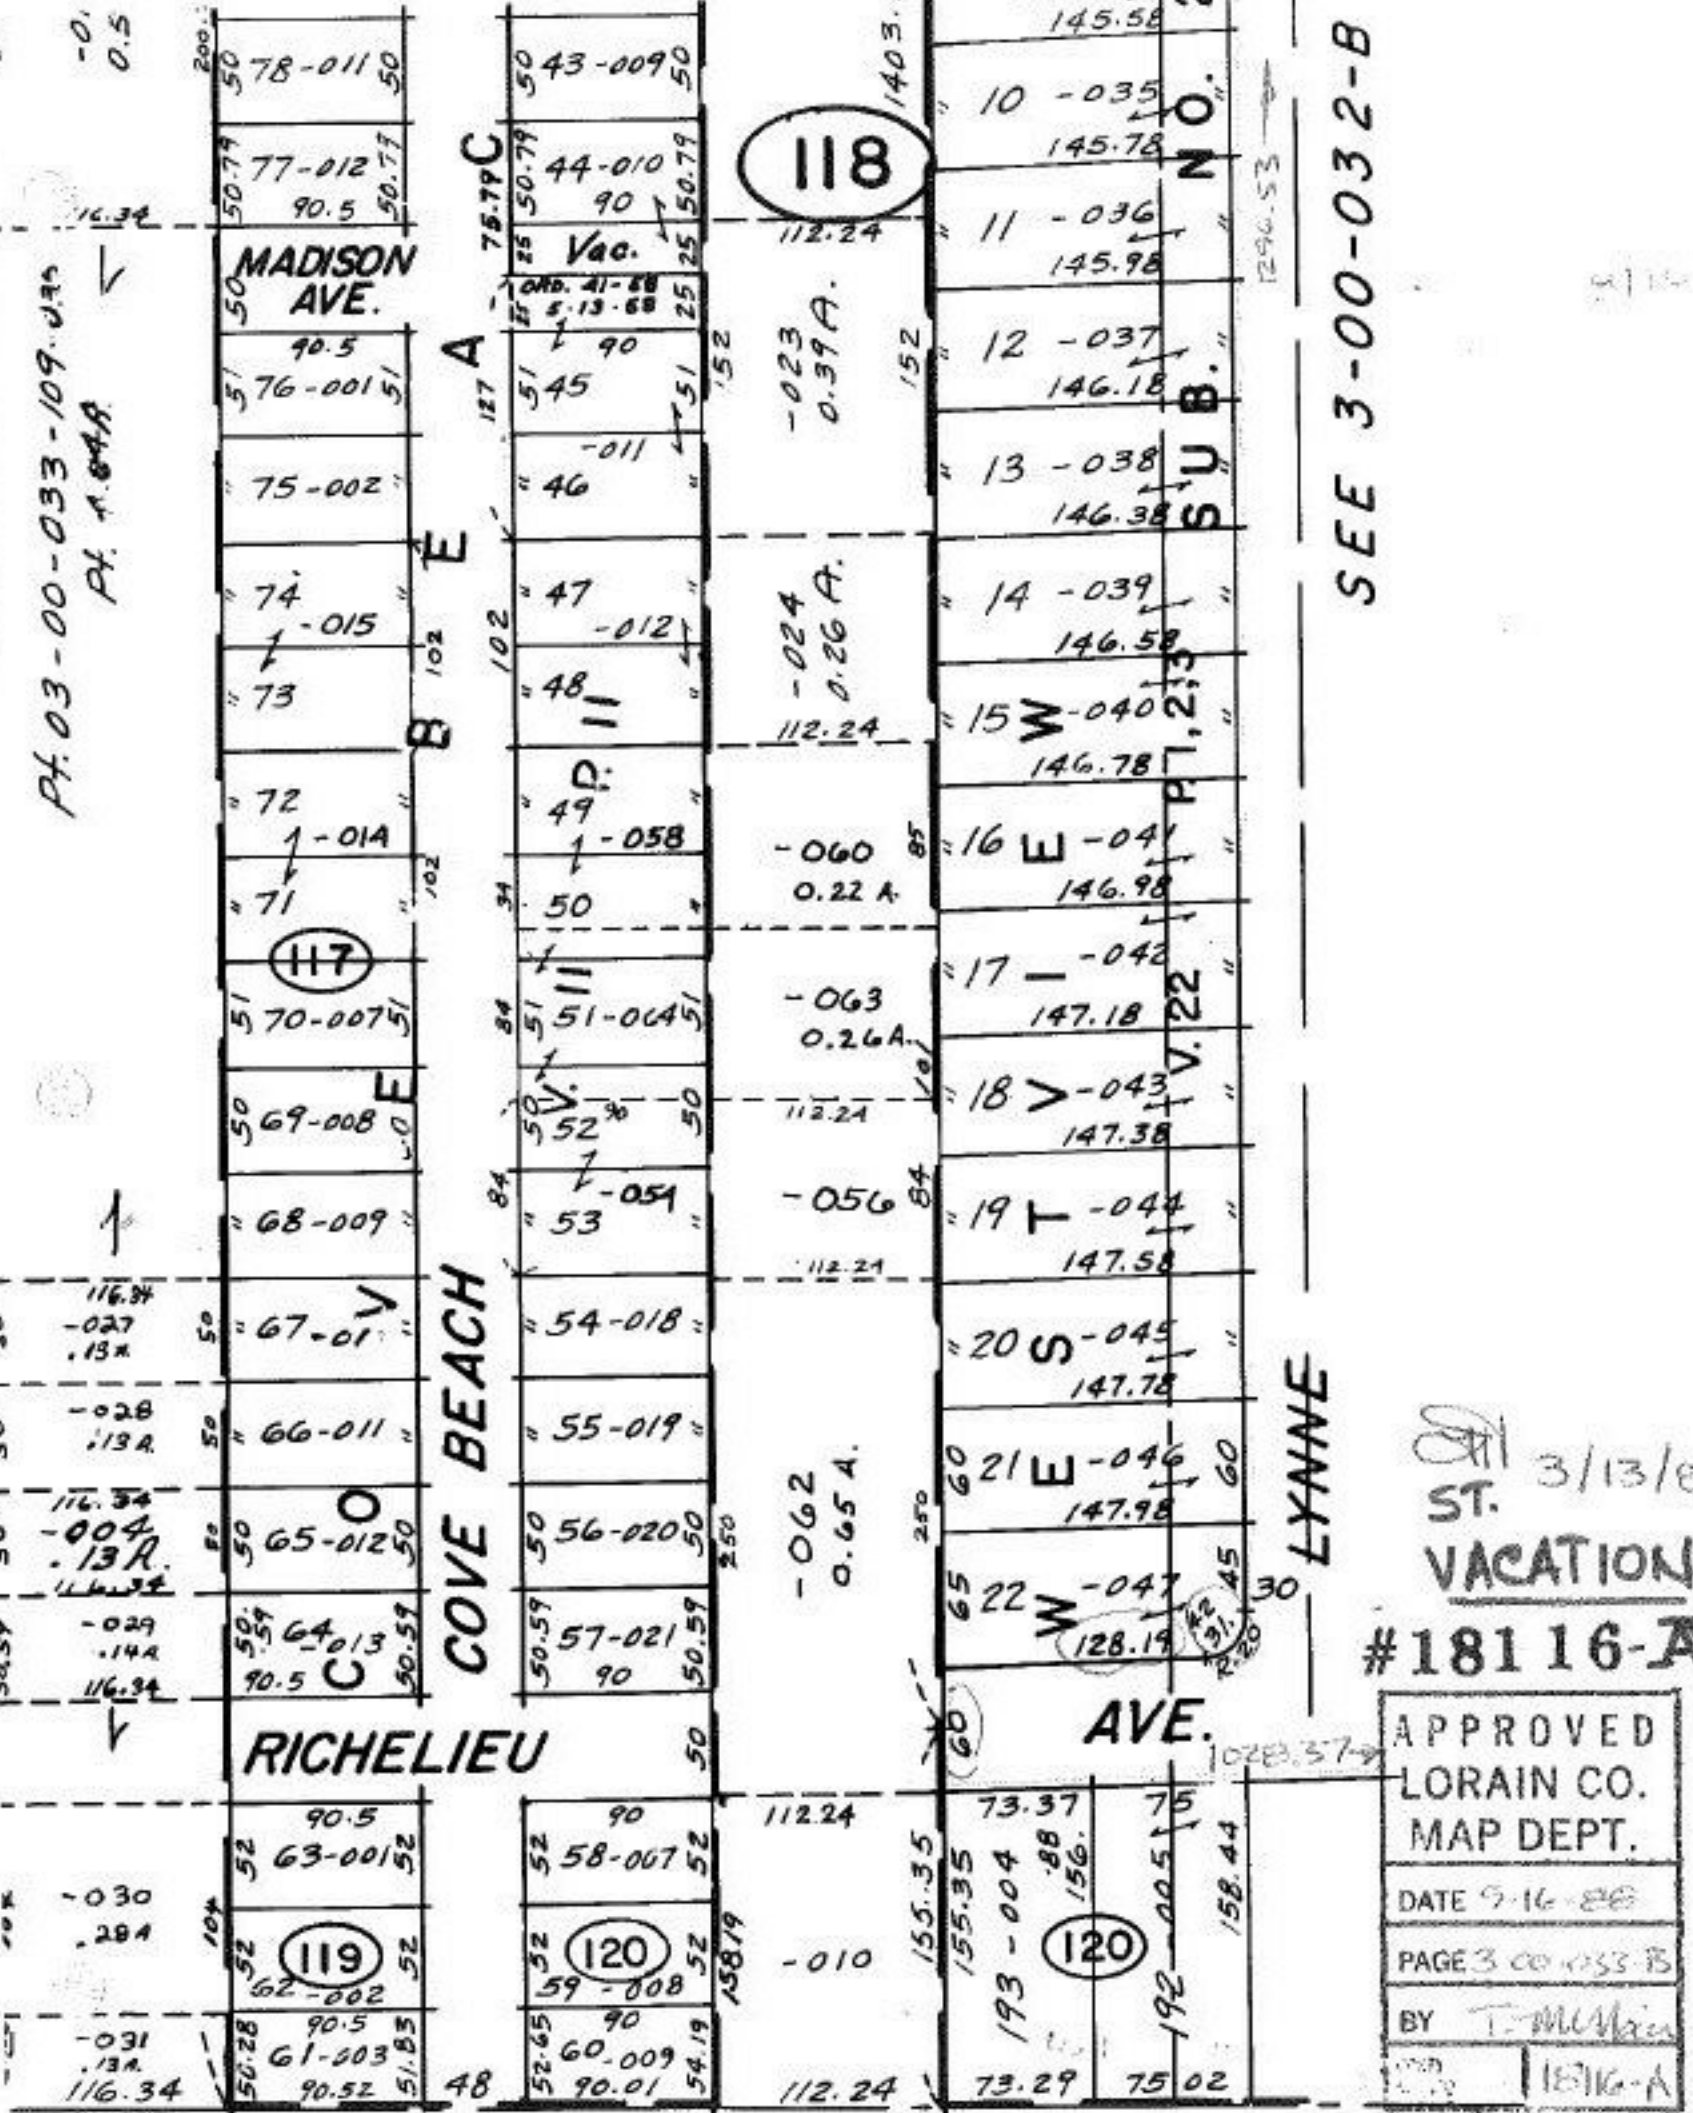

SEE 3-00-032-B

LYNNE

ST. 3/13/89
VACATION
#18116-A

APPROVED
LORAIN CO.
MAP DEPT.
DATE 9-16-88
PAGE 3 of 033-B
BY T. McVicker
18116-A