


SE 12-C

SEE 12-00

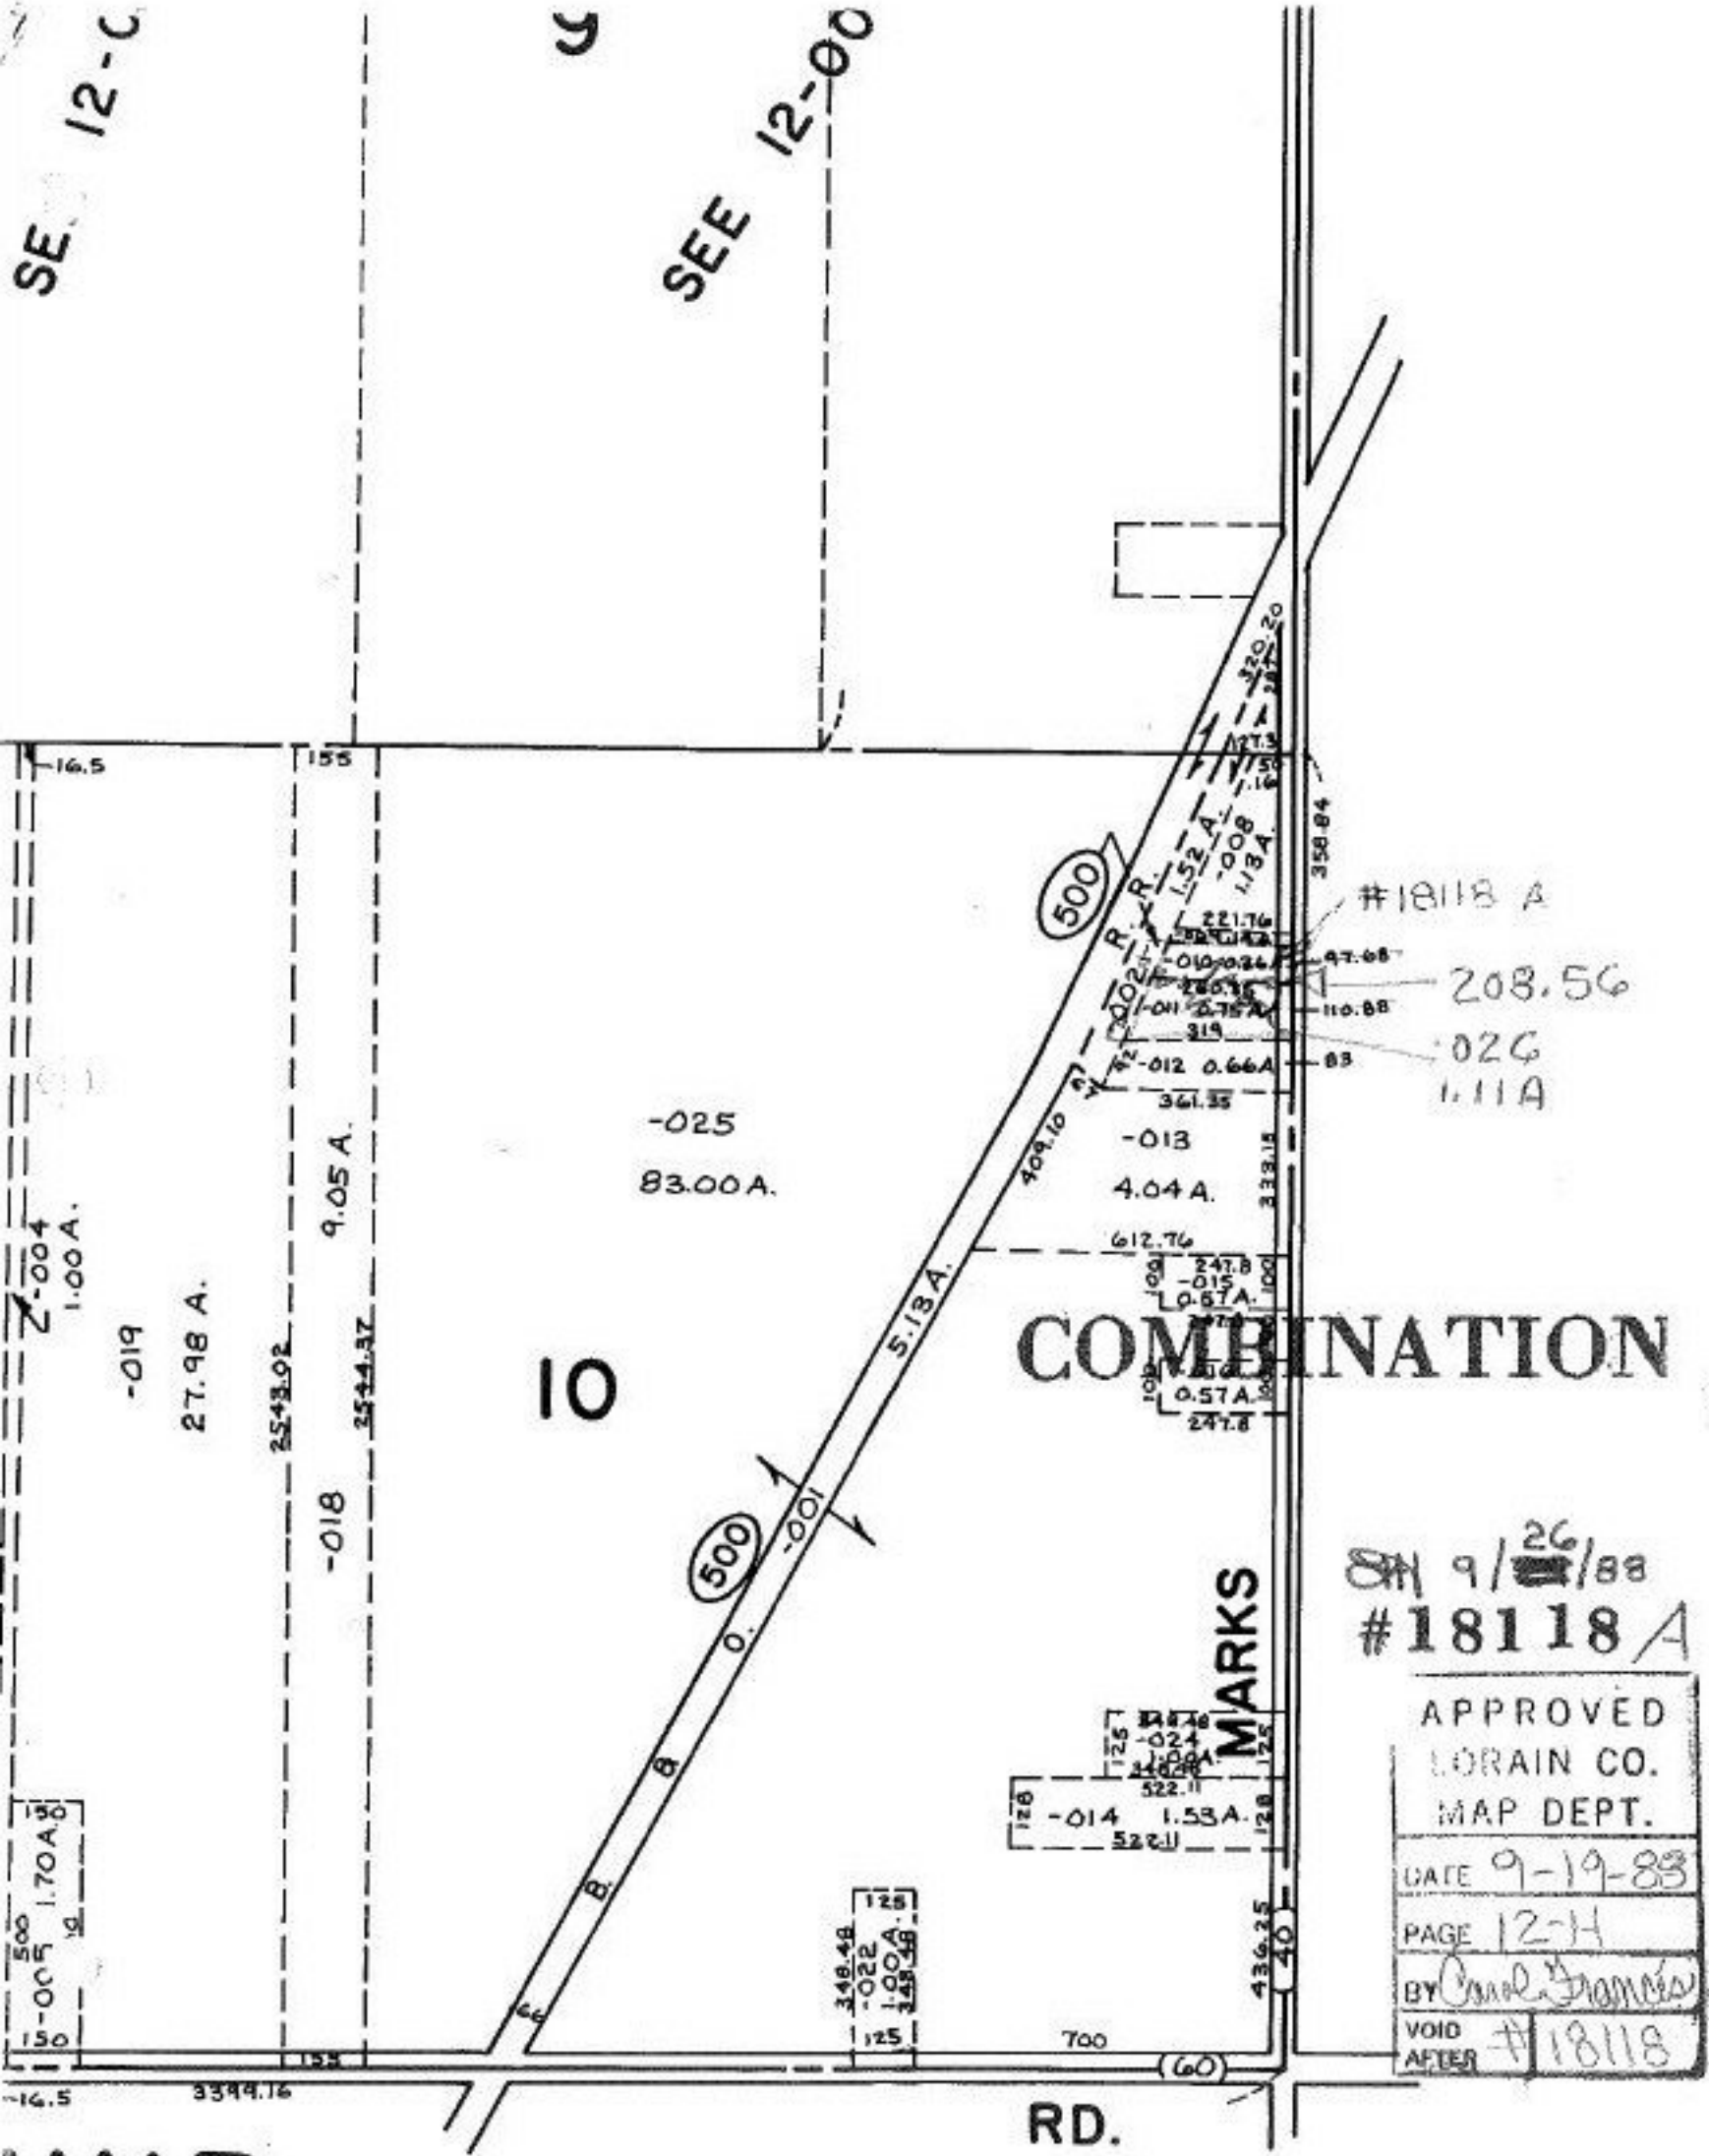

COMBINATION

MARKS

SH 9/26/88
 #18118 A

APPROVED
LORAIN CO.
MAP DEPT.
DATE 9-19-88
PAGE 12-H
BY <i>Charles Francis</i>
VOID AFTER #18118

W D

RD.