


1.75 A.

Pt. -057
Pt. 9.12A.

#18122 084
Pt. -069
Pt. 9.18A:
8.74 A

2-109-113
43 A.

55
5A.

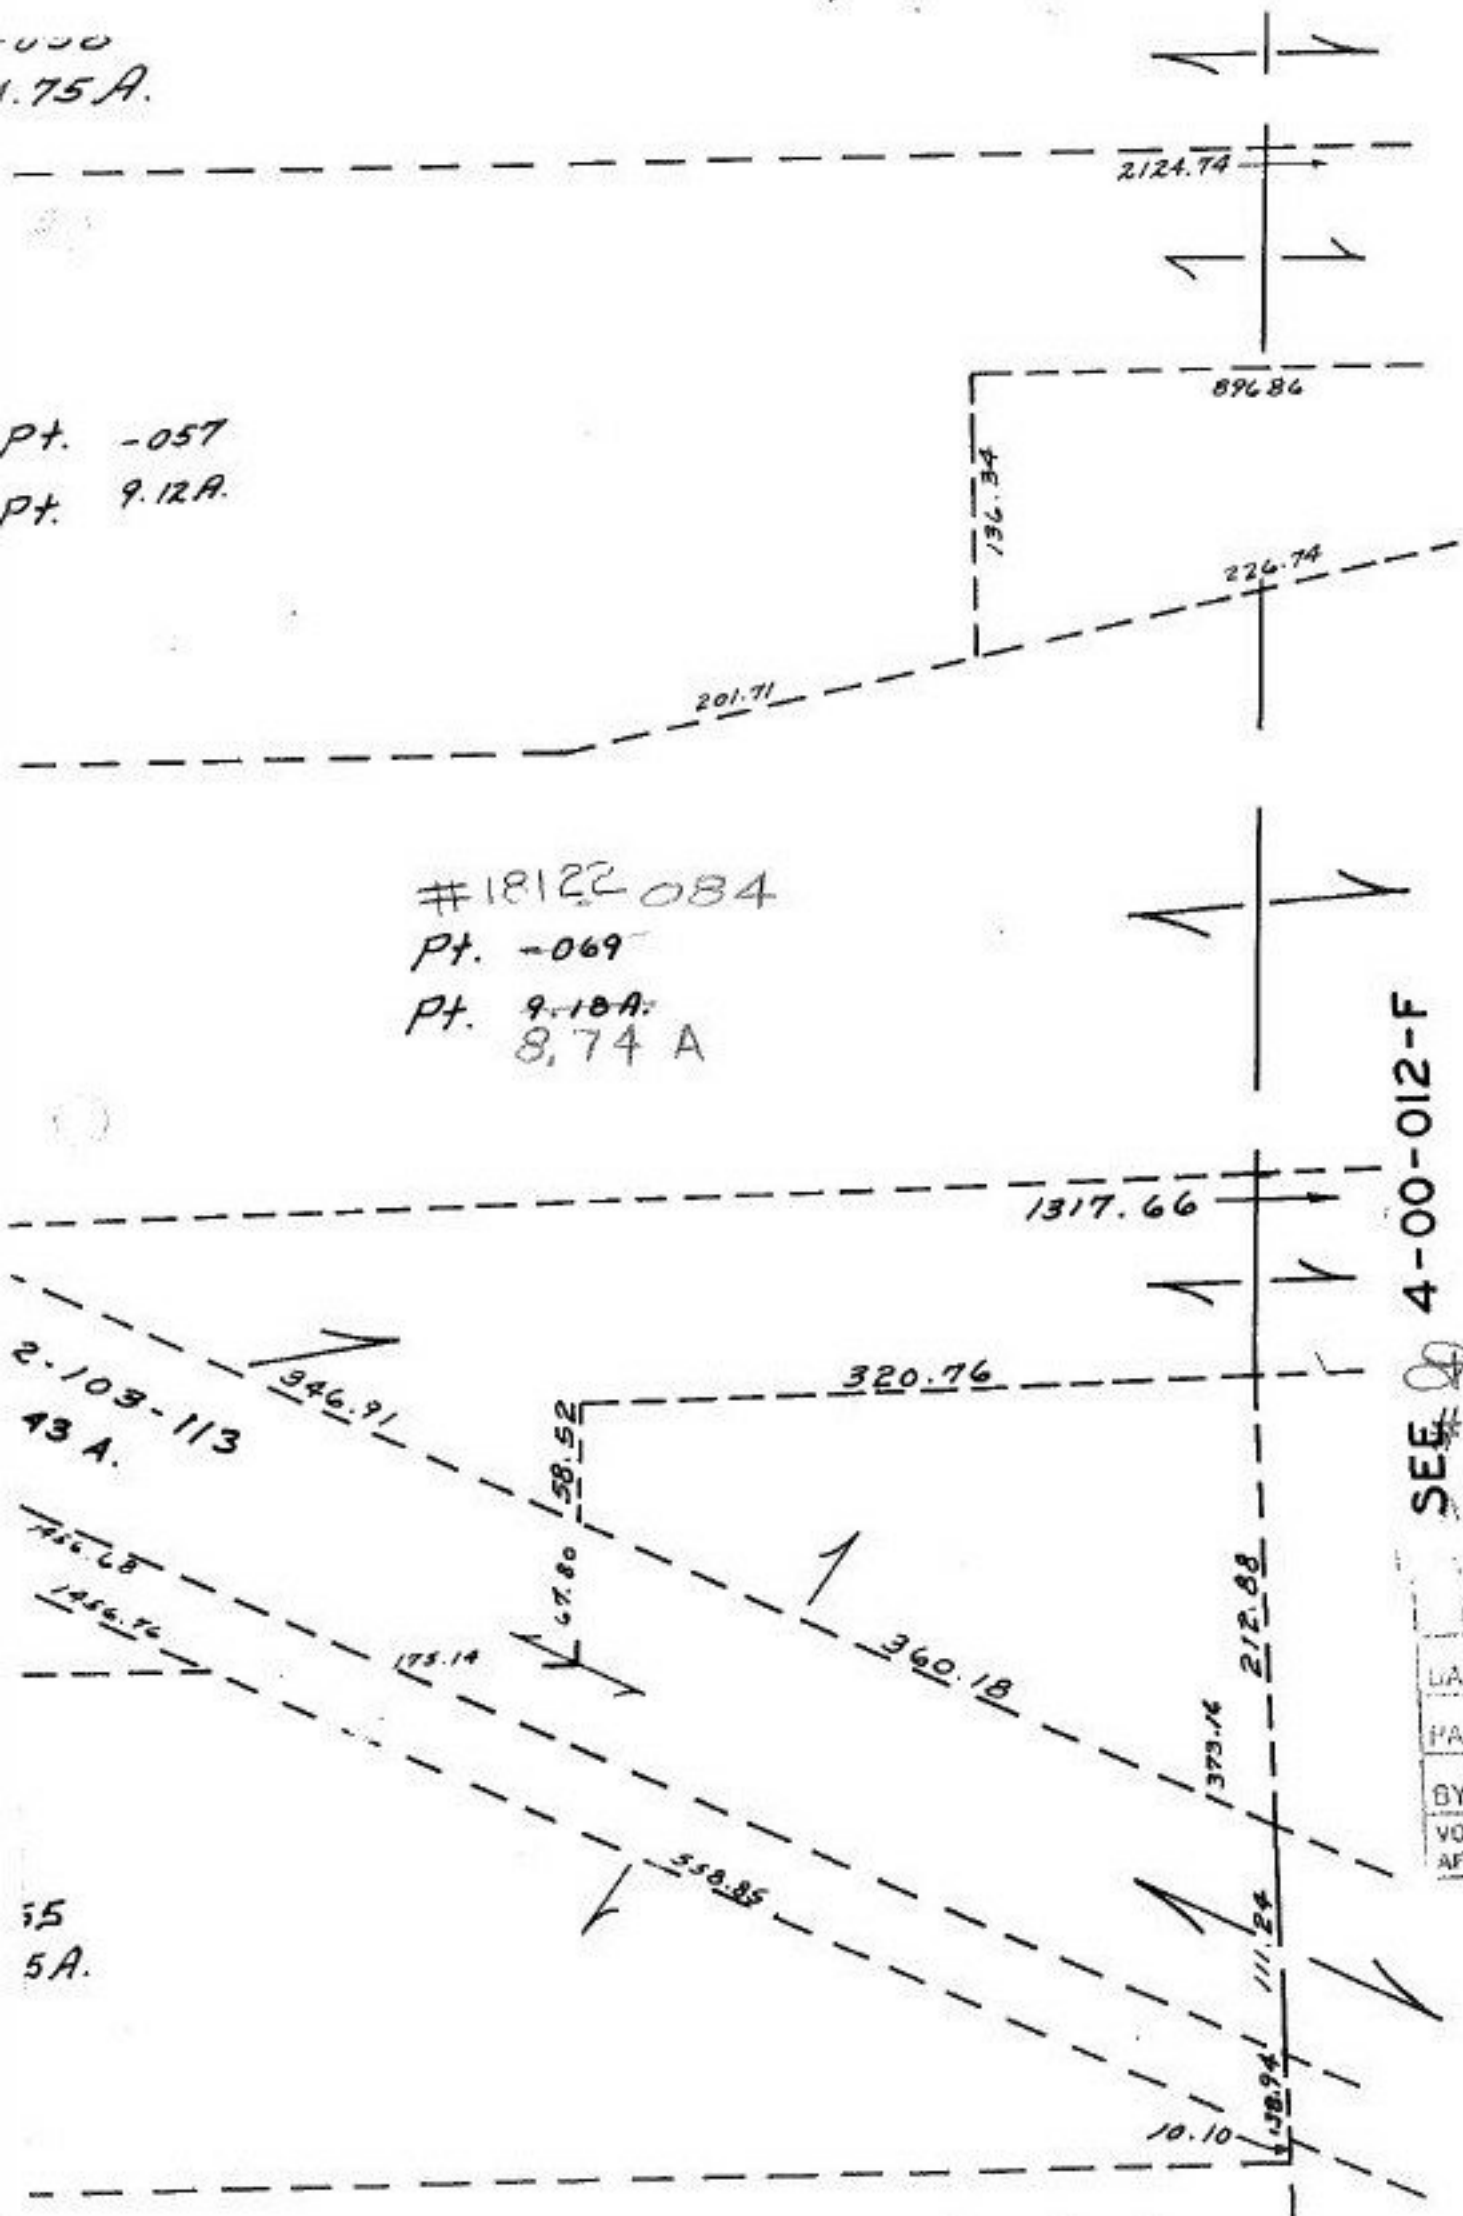

4-00-012-F

1/24/89
 SEE # 18122
 APPROVED
 DRAIN CO.
 MAP DEPT.
 DATE 9-15-88
 PAGE 4-00-012-E
 BY Carol Francis
 VOID AFTER # 18122