


8/13

DONE 7/8/68  
N. Rocks

SEE

89°09'  
89°10'

Pt. 7.07 F  
Pt. 7.00 F

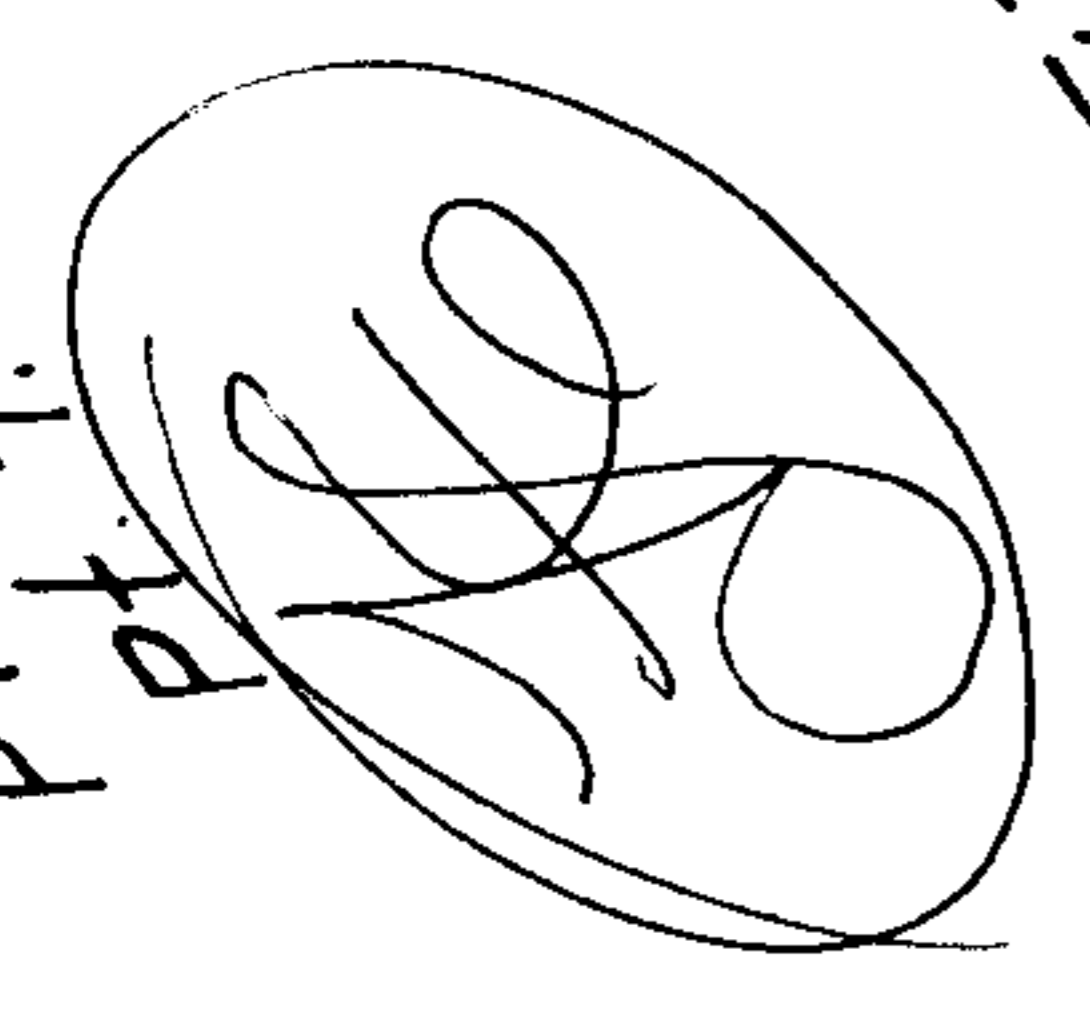

1182.42  
095.11 F  
1.95  
1150.82  
090.12 F  
1.15

695.34  
067 A  
2.00  
695.34

~~012 F~~  
~~015 F~~

125.29

42  
42  
063 A  
013  
1.1

1120.21  
1140.05

1813

7-11-66

APPROVED  
LORAIN CO.  
MAP DEPT.  
DATE 5-28-68

BY *[Signature]*

52761  
LORAIN  
RD.

T W B  
E T L  
V E  
R I D G E  
R I D G E

