


SEE 3-00-103.

ELYRIA COMBINATION

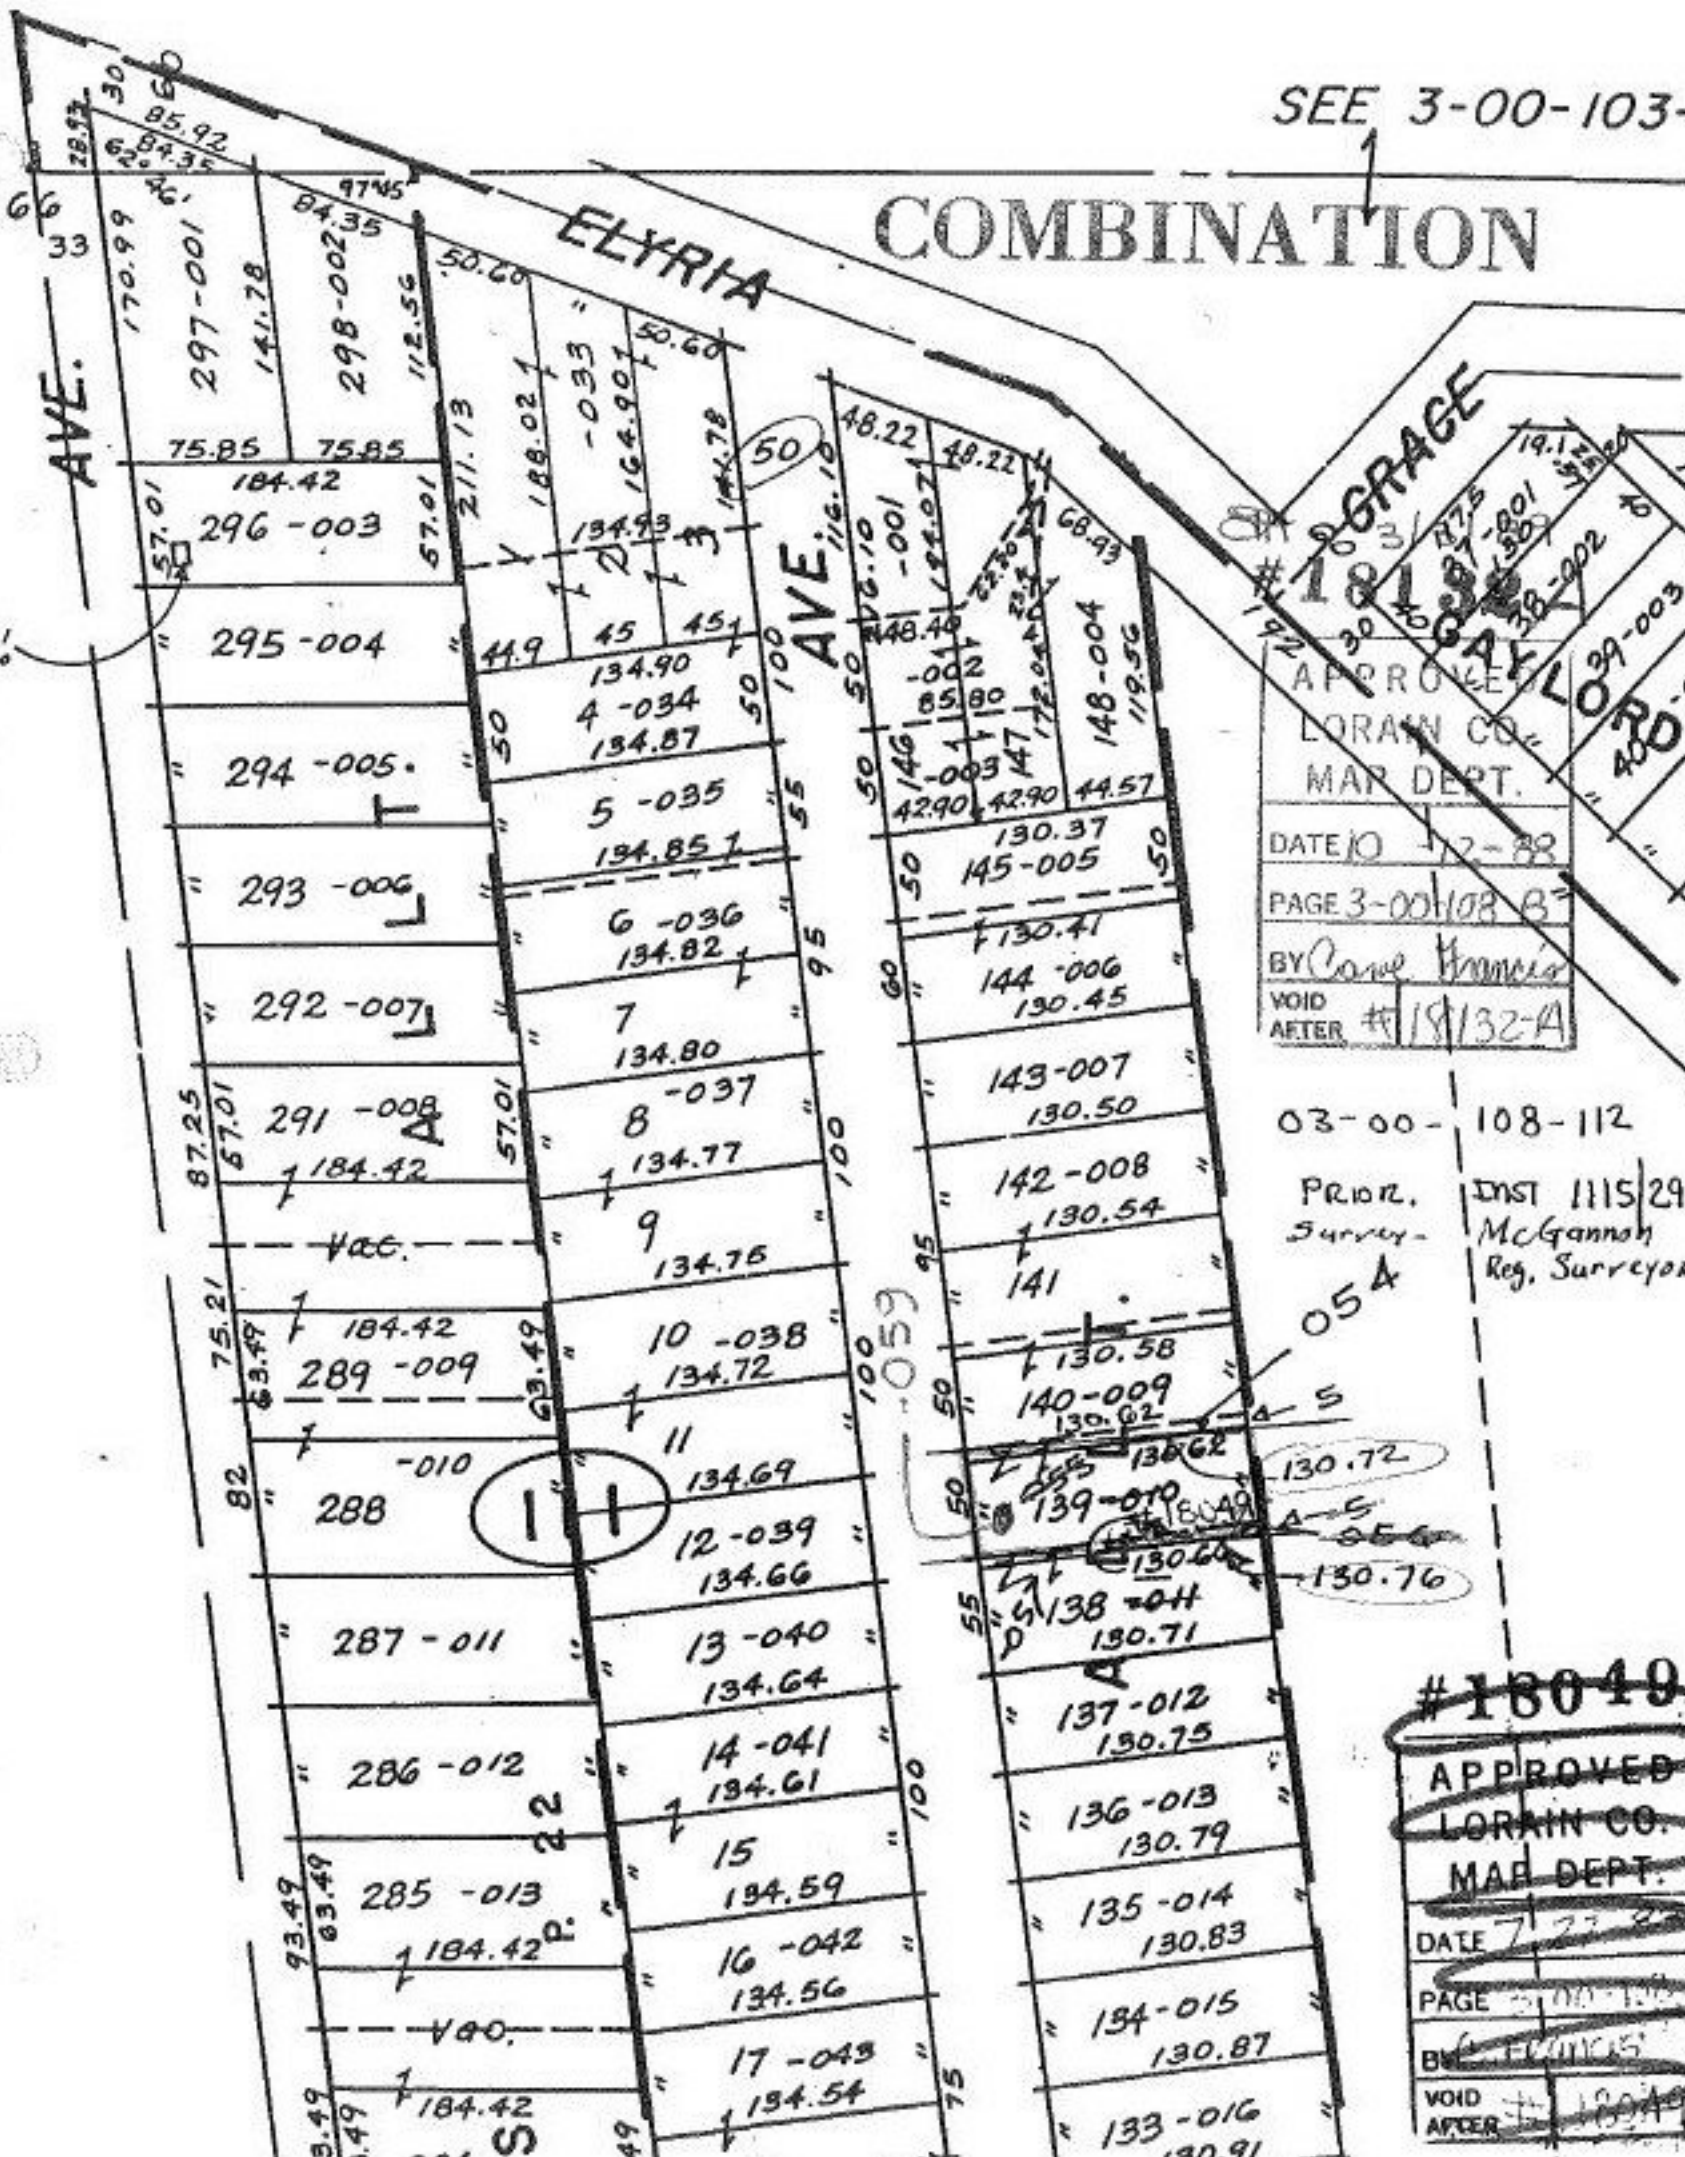

APPROVED
 LORAIN CO.
 MAP DEPT.
 DATE 10/12/88
 PAGE 3-00-108 B
 BY *Cornel Francis*
 VOID AFTER #18132-A

03-00-108-112
 PRIOR. INST 1115/290
 Survey- McGannoh
 05A Reg. Surveyor

#18049
 APPROVED
 LORAIN CO.
 MAP DEPT.
 DATE 7/27/88
 PAGE 3-00-108 B
 BY *Cornel Francis*
 VOID AFTER #18049