

SHOW LINES ONLY.
KEEP DIMENSIONS ON
-043-B PAGE

519


SEE 12-00-043-B

~~Pt. -033~~
~~Pt. 44.59 A.~~

~~#18060~~
VOID

~~#15063~~
VOID

Pt. -035
Pt. 43.50 A.

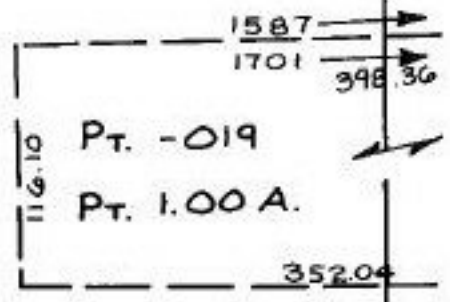

3/24/89
#18132

APPROVED	
LORAIN CO.	
MAP DEPT.	
DATE 7-21-88	
PAGE 12-00-043-A	
BY T. McHain	
VOID AFTER	18132

250.01