


0-003-B

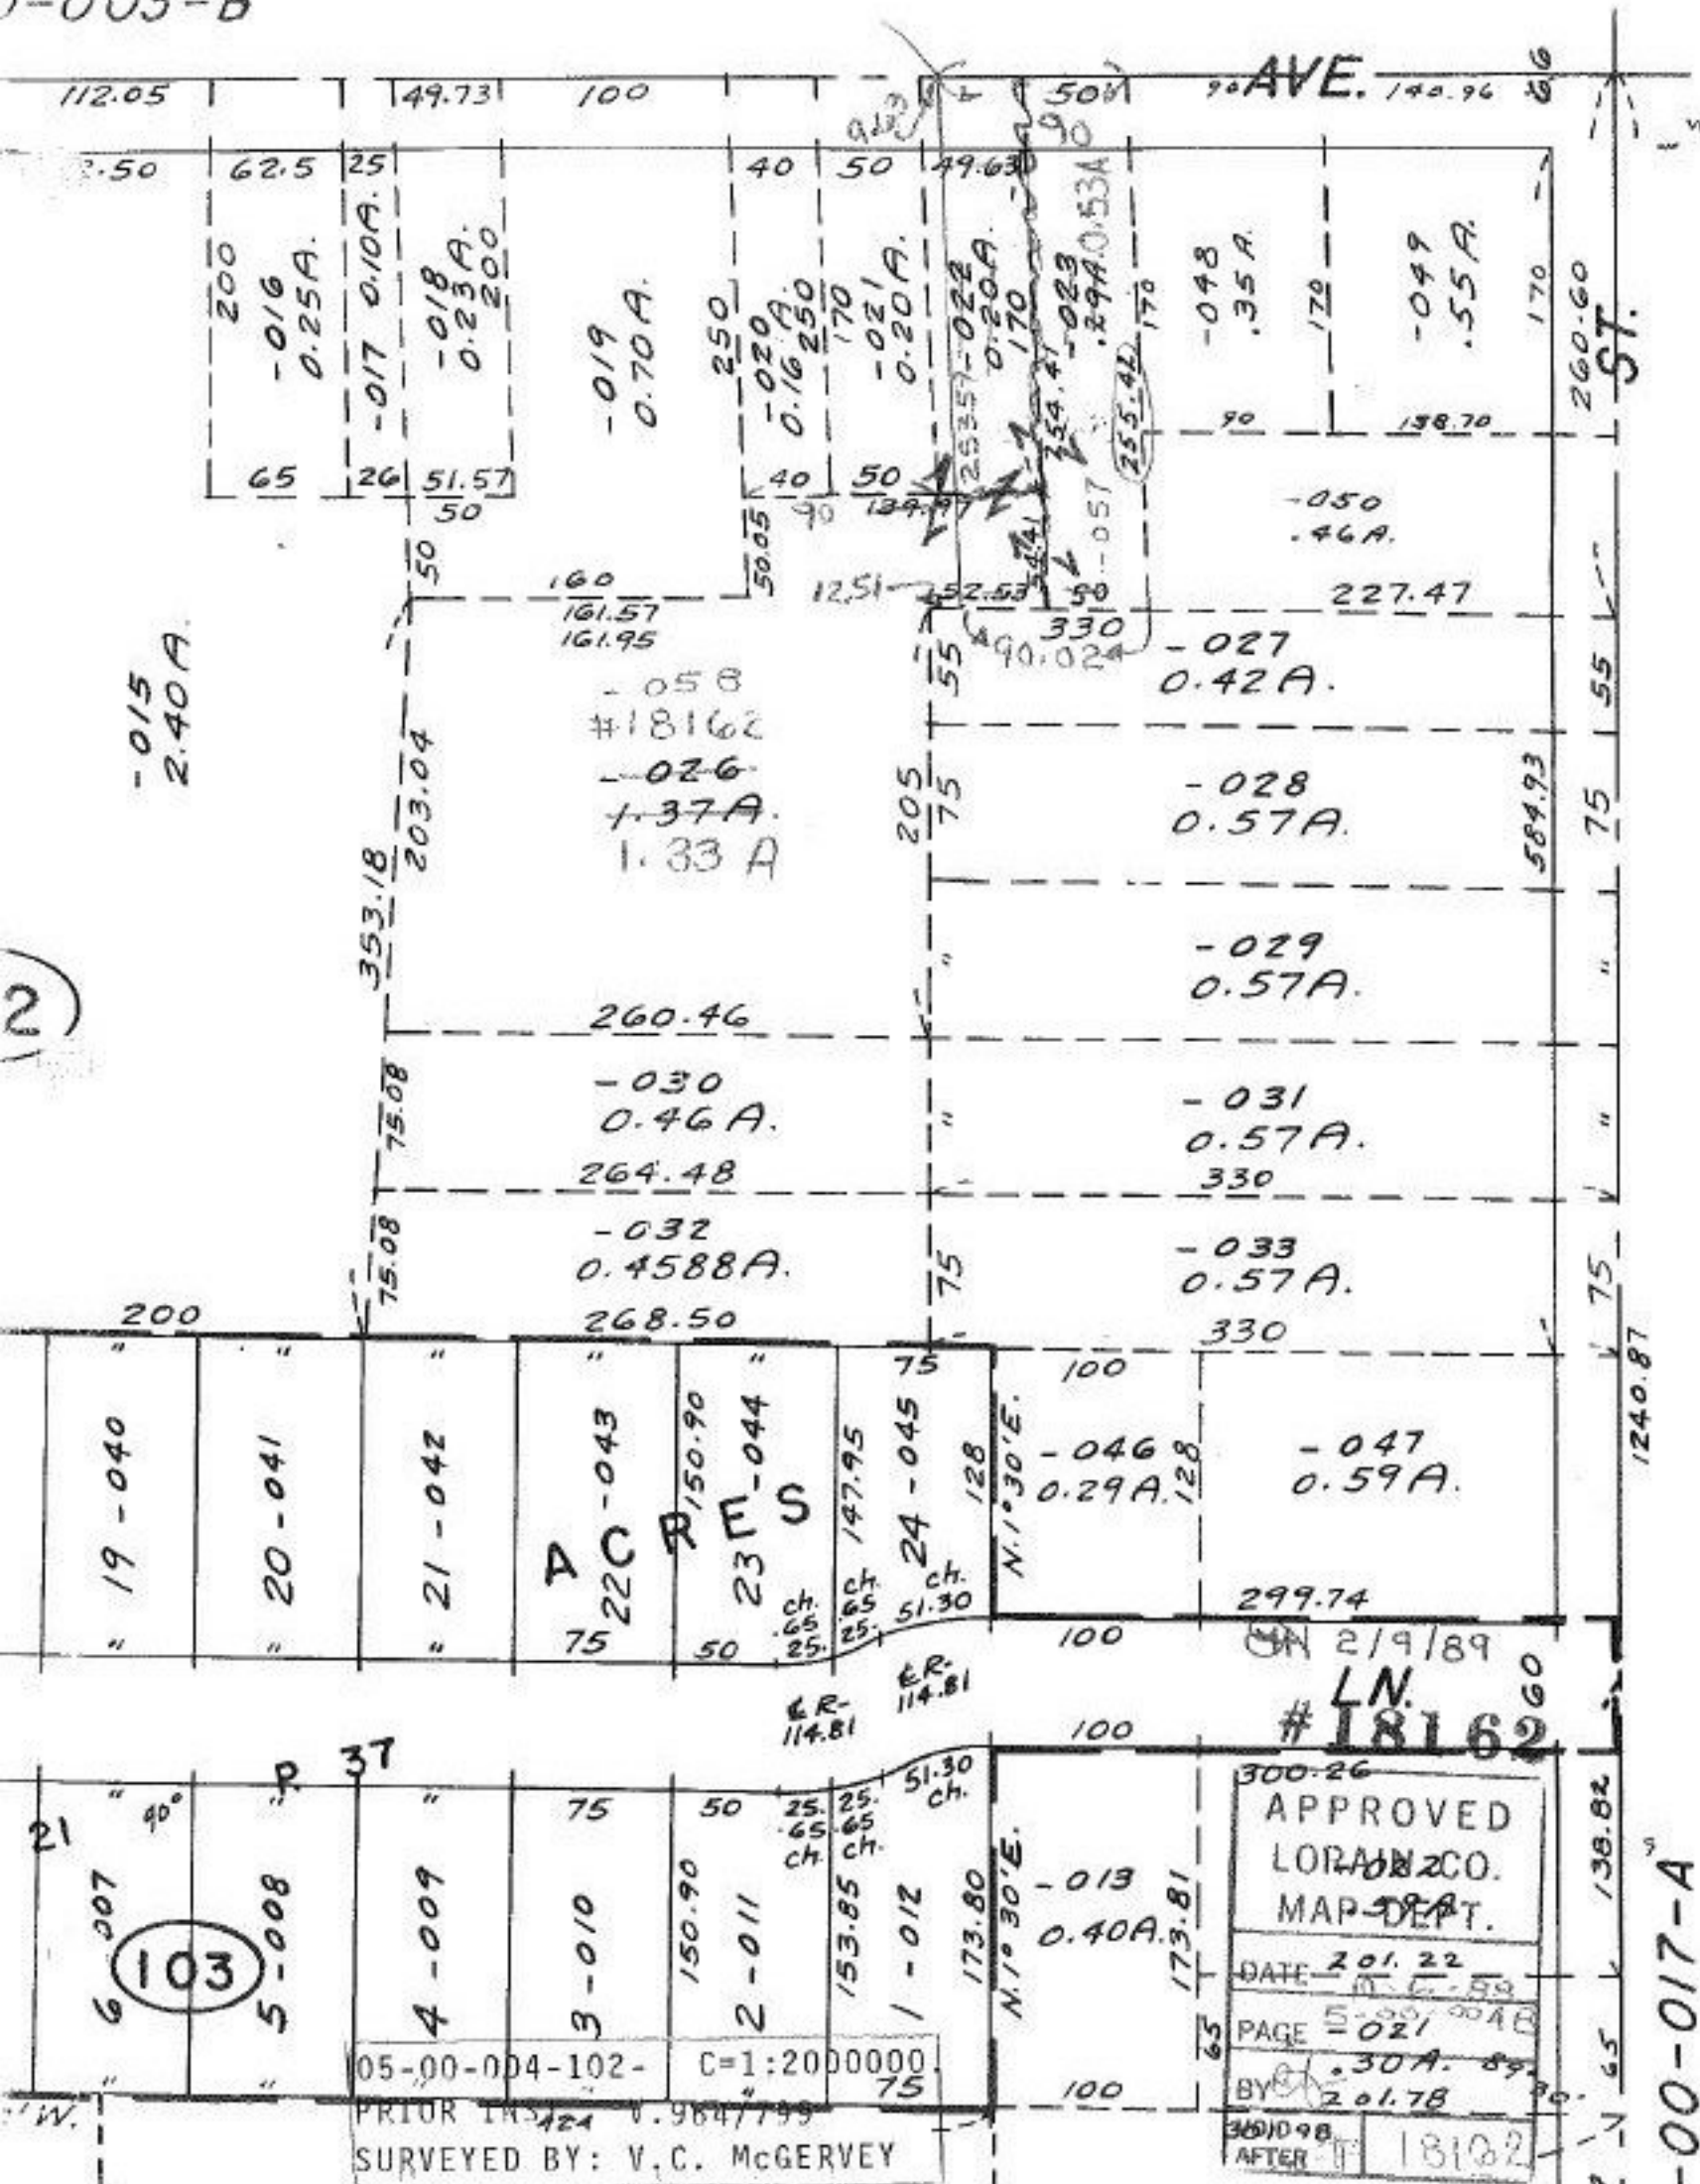

-015  
2.40 A.

2

90 AVE.

260-60 ST.

300-26  
 APPROVED  
 LORANZO CO.  
 MAP DEPT.  
 DATE 2-01-22  
 PAGE 5-00-0048  
 BY 2-01-78  
 AFTER 18162

05-00-004-102- C=1:2000000  
 PRIOR INS. 424 V. 984/799  
 SURVEYED BY: V.C. McGERVEY

00-017-A