


A = 81.62
 R = 300
 Δ = 15-35-16
 C = 81.37

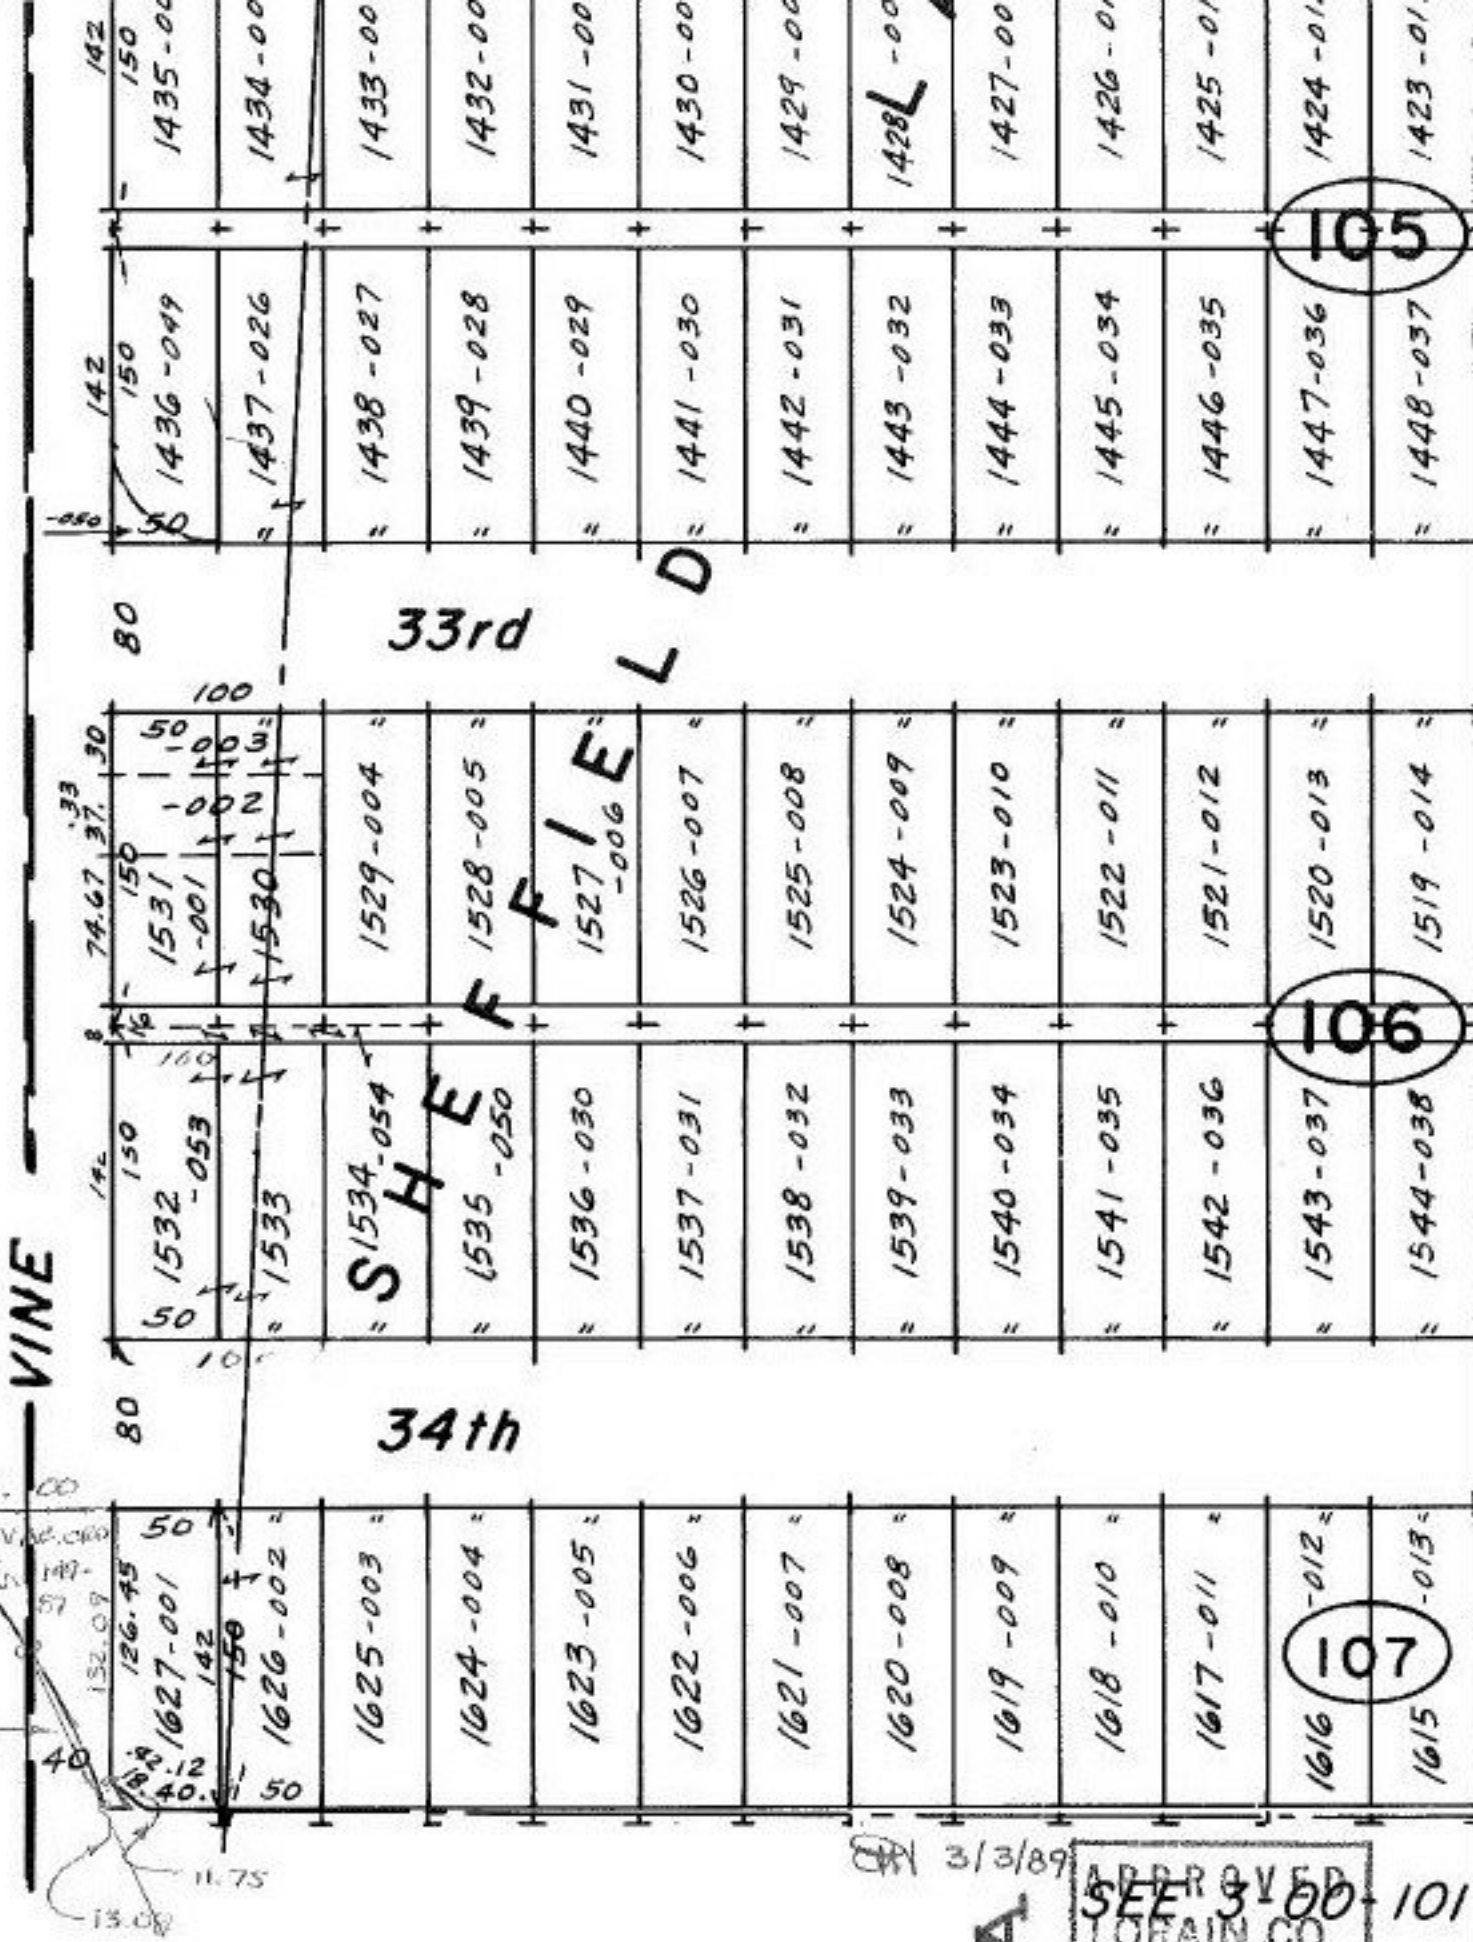

3/3/89

STREET
 VACATION
 #18164-A

APPROVED SEE 3-00-101 LORAIN CO. MAP DEPT.	
DATE 10-21-88	
PAGE 3-00-096 A	
BY T. M. Hain	
VOID AFTER	18164-A