


SEE
 VAC. ORD. 171-87
 PASSED 12/7/87

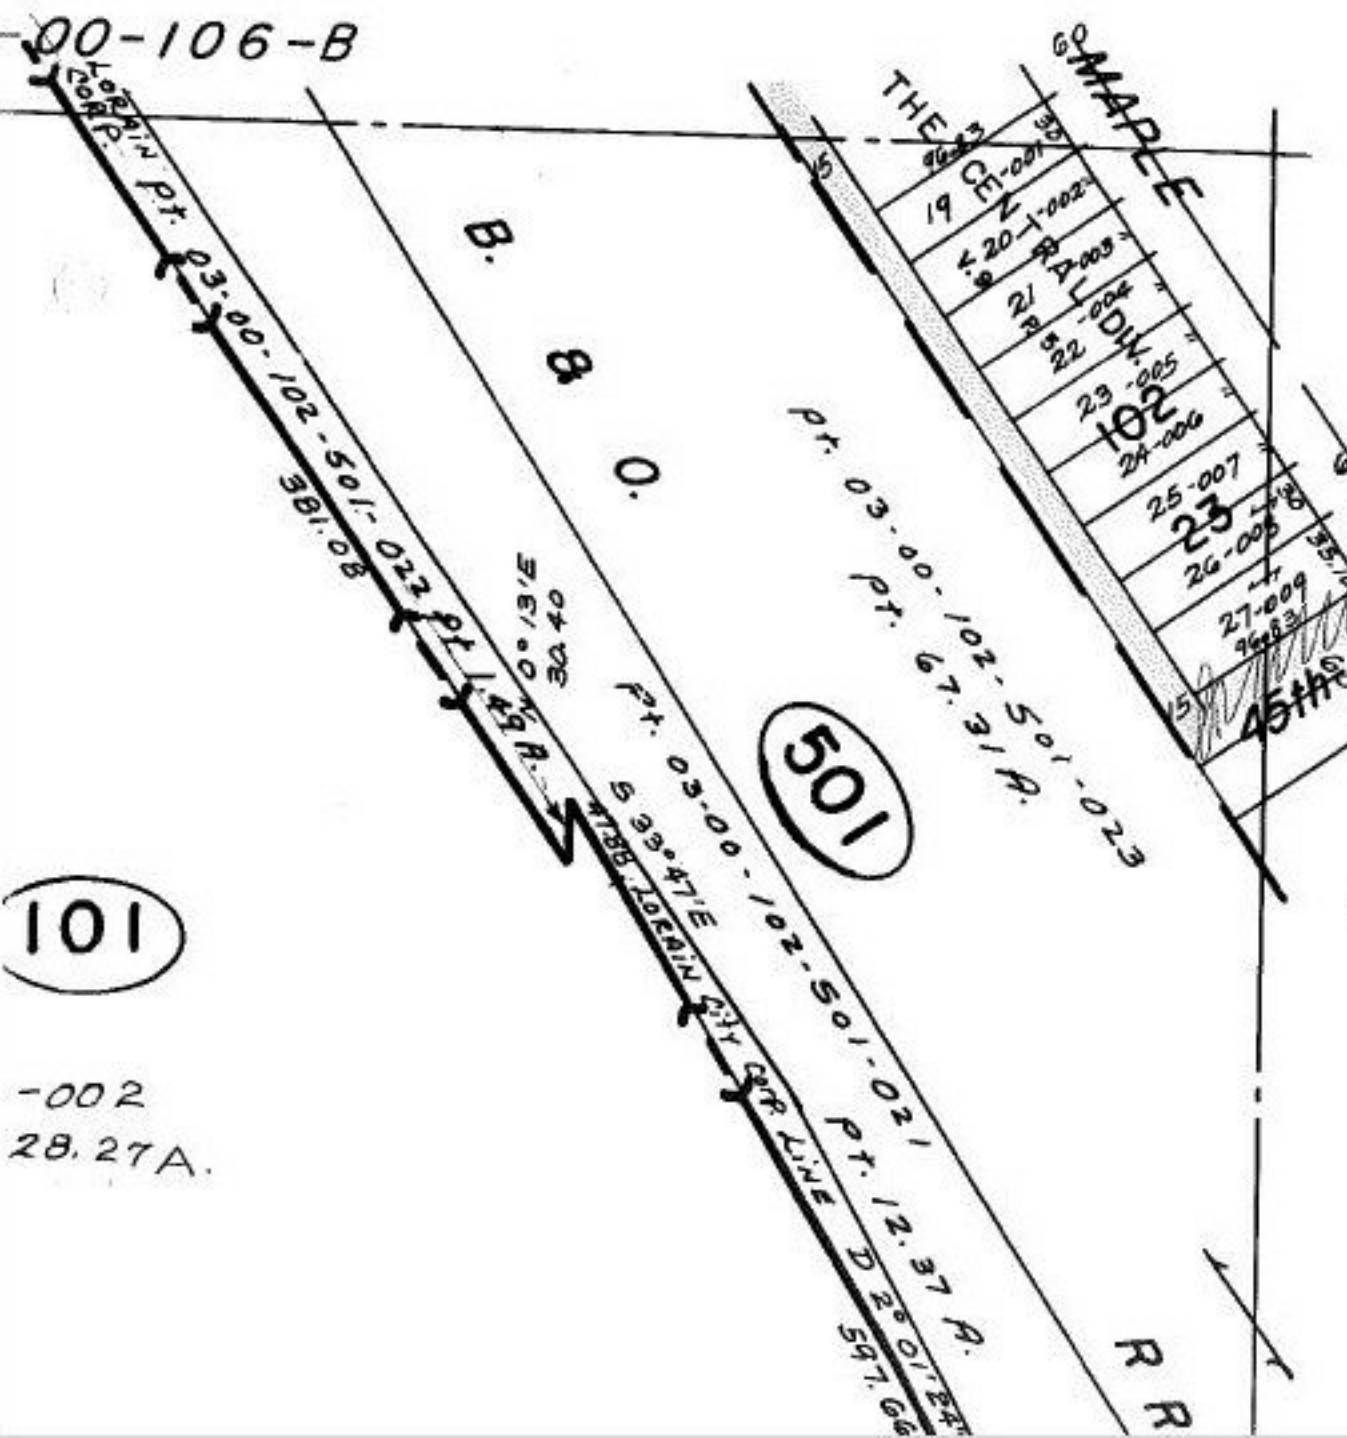

SH 3/3/89
 ALEY
 VACATION
 #18166-A

APPROVED
 LORAIN CO.
 MAP DEPT.
 DATE 10-20-88
 PAGE 3-00-111-B
 BY T. McMan
 VOID AFTER 18166-A

101

-002
 28.27A.