


**SQUIRE**

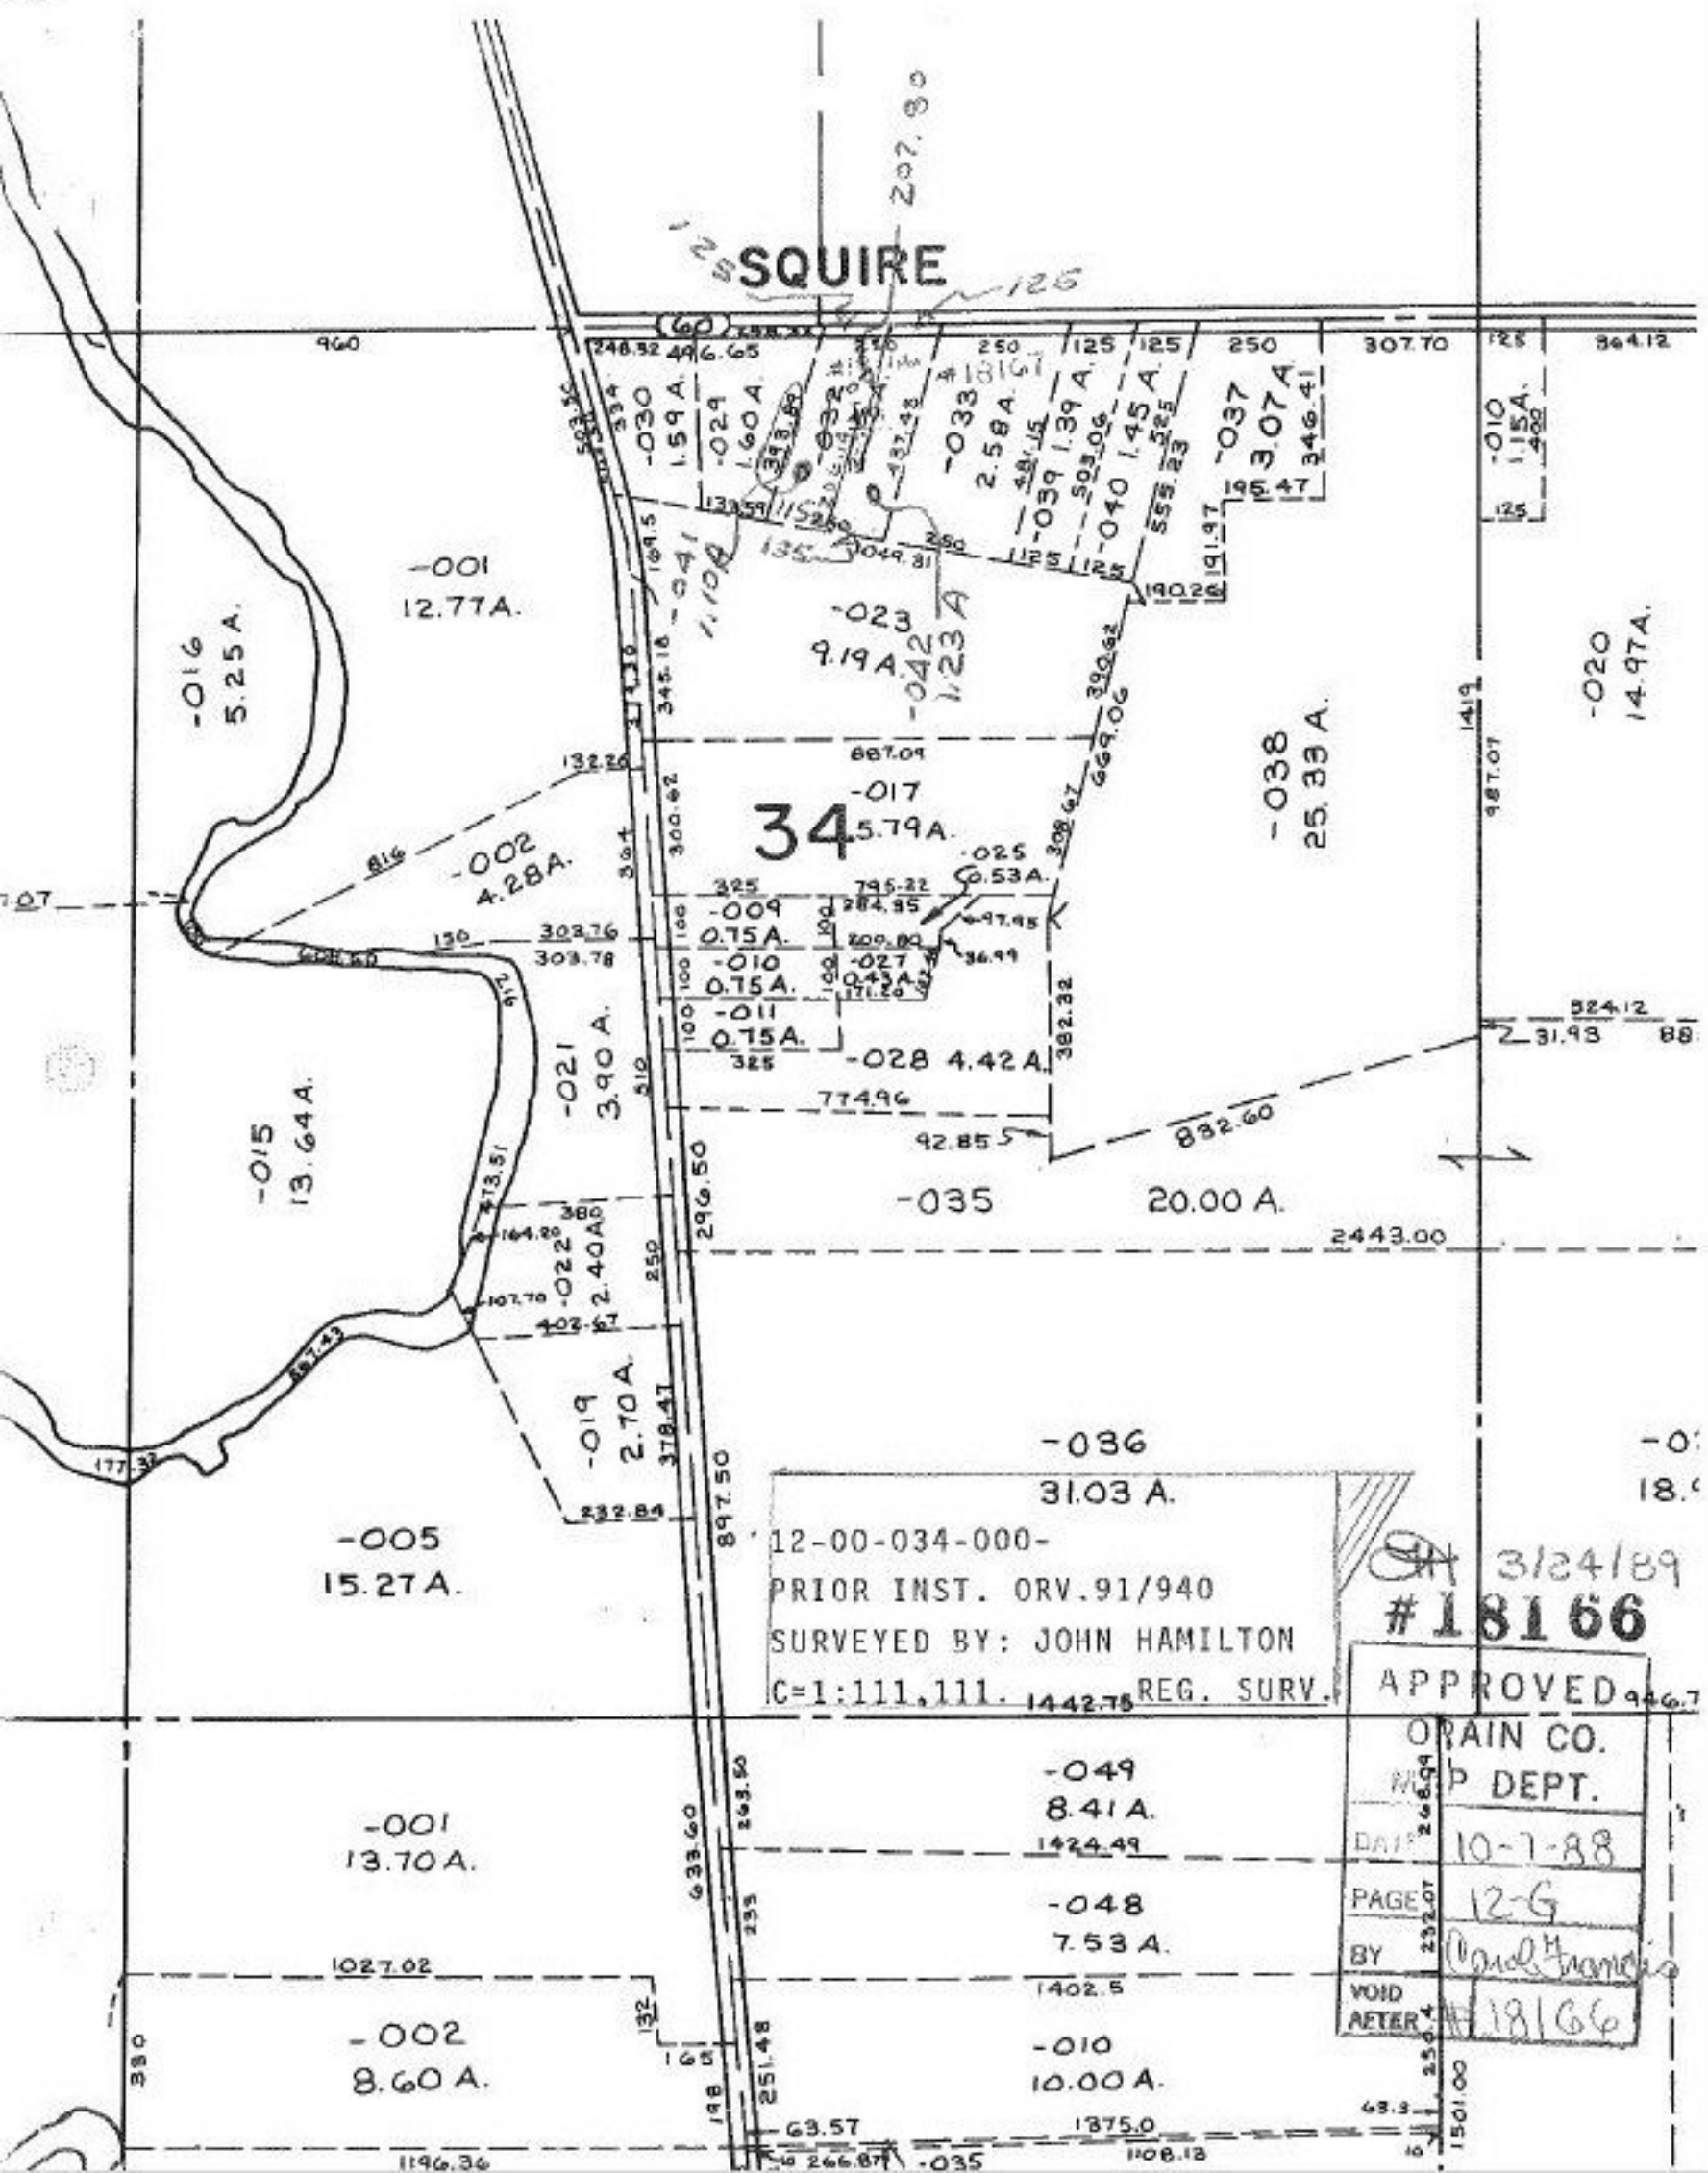

12-00-034-000-  
 PRIOR INST. ORV. 91/940  
 SURVEYED BY: JOHN HAMILTON  
 C=1:111,111. 1442.75 REG. SURV.

3124189  
**#18166**

APPROVED

RAIN CO.  
 P DEPT.

DATE 10-7-88

PAGE 12-G

BY [Signature]

VOID AFTER #18166