

SEE 4-C

1105.37 D.
1106

SEE SURVEY MAP - HIG REITZ Co.
JOHN G. SAILOR
NO. 2
CLOSURE 1-95255
PRIOR INST. OK 12/809

1388.51
1388.54

Pt. 1.28 A.


-143
36.50 A.

#18170
~~-042~~
~~18.50 A.~~

PAPER No. 2

1104

503.00 N. of CL
WALKER RD.

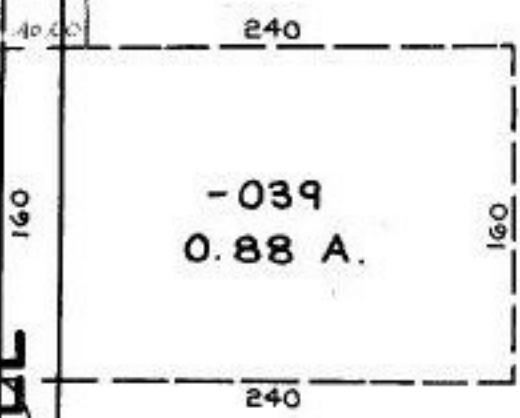

LEAR NAGLE
343

481.50

ON 1/24/89
#18170

APPROVED LORAIN CO. MAP DEPT.
DATE 10-11-88
PAGE 1-00-030-E
BY T. McMain
VOID AFTER 18170

7.0