


MAKE THIS A PROPERTY
 LINE ONLY - MOVE
 CORP. LINE

PT.-015
 61.70 A.

S.H. 3/15/89
 #18174-A DONE

ANNEXATION

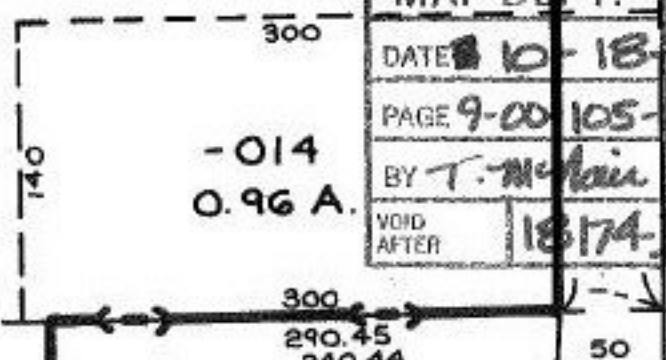

APPROVED LORAIN CO. MAP DEPT.	
DATE	10-18-88
PAGE	9-00-105-B
BY	T. McMain
VOID AFTER	18174-A

O-106-A