


SEE 9-F

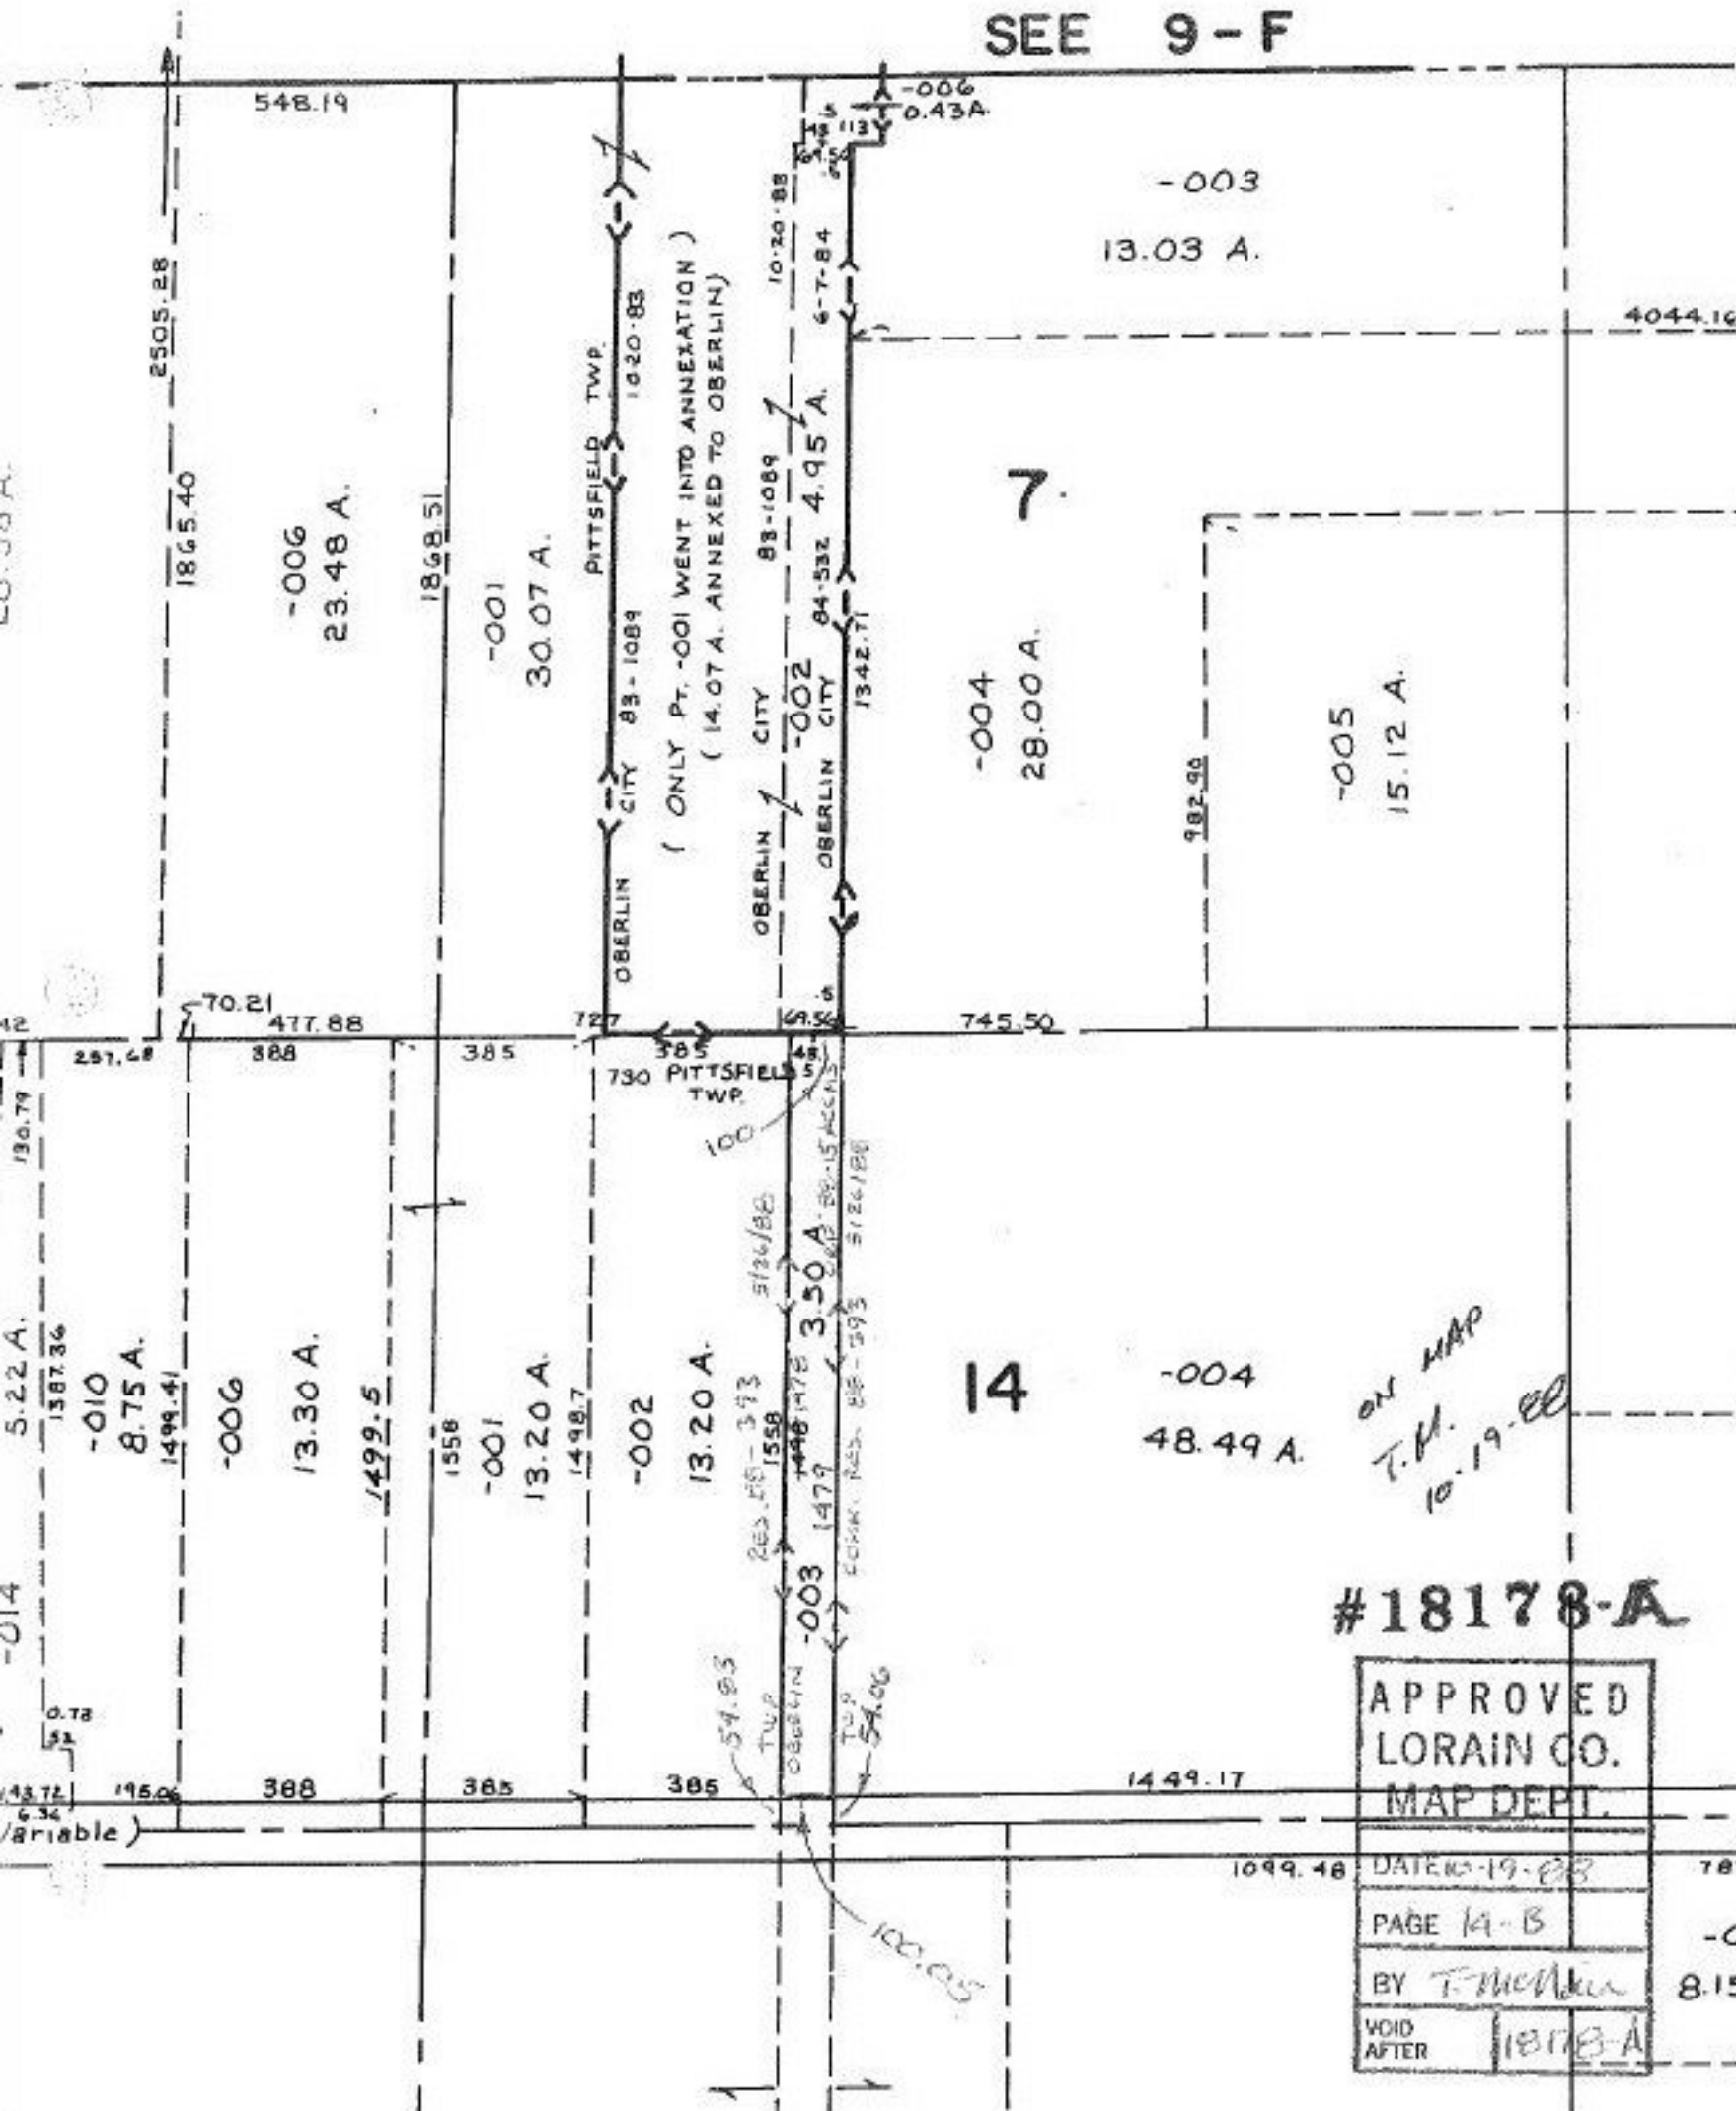

#18178-A

APPROVED LORAIN CO. MAP DEPT.	
DATE 10-19-08	782
PAGE 14-B	-0
BY T. McNamee	8.15
VOID AFTER	18178-A