

Pt. - 012  
Pt. 53.54 A

ST.

MON.

GREEN


5th WARD

08-20-024-000-  
PRIOR INST. 1234 / 892  
SURVEYED BY LAUNDON SIMON CAHL  
C=1:125 T & ASSOC. R

FLOOR IN 0.02 AC. THAT IS IN  
TR 13 ON 1

3/15/89  
#18186

-004  
APPROVED  
LORAIN CO.  
MAP DEPT.  
DATE 10-26-83  
PAGE 8-E  
BY CAROL FRANCIS  
VOID  
AFTER # 18186

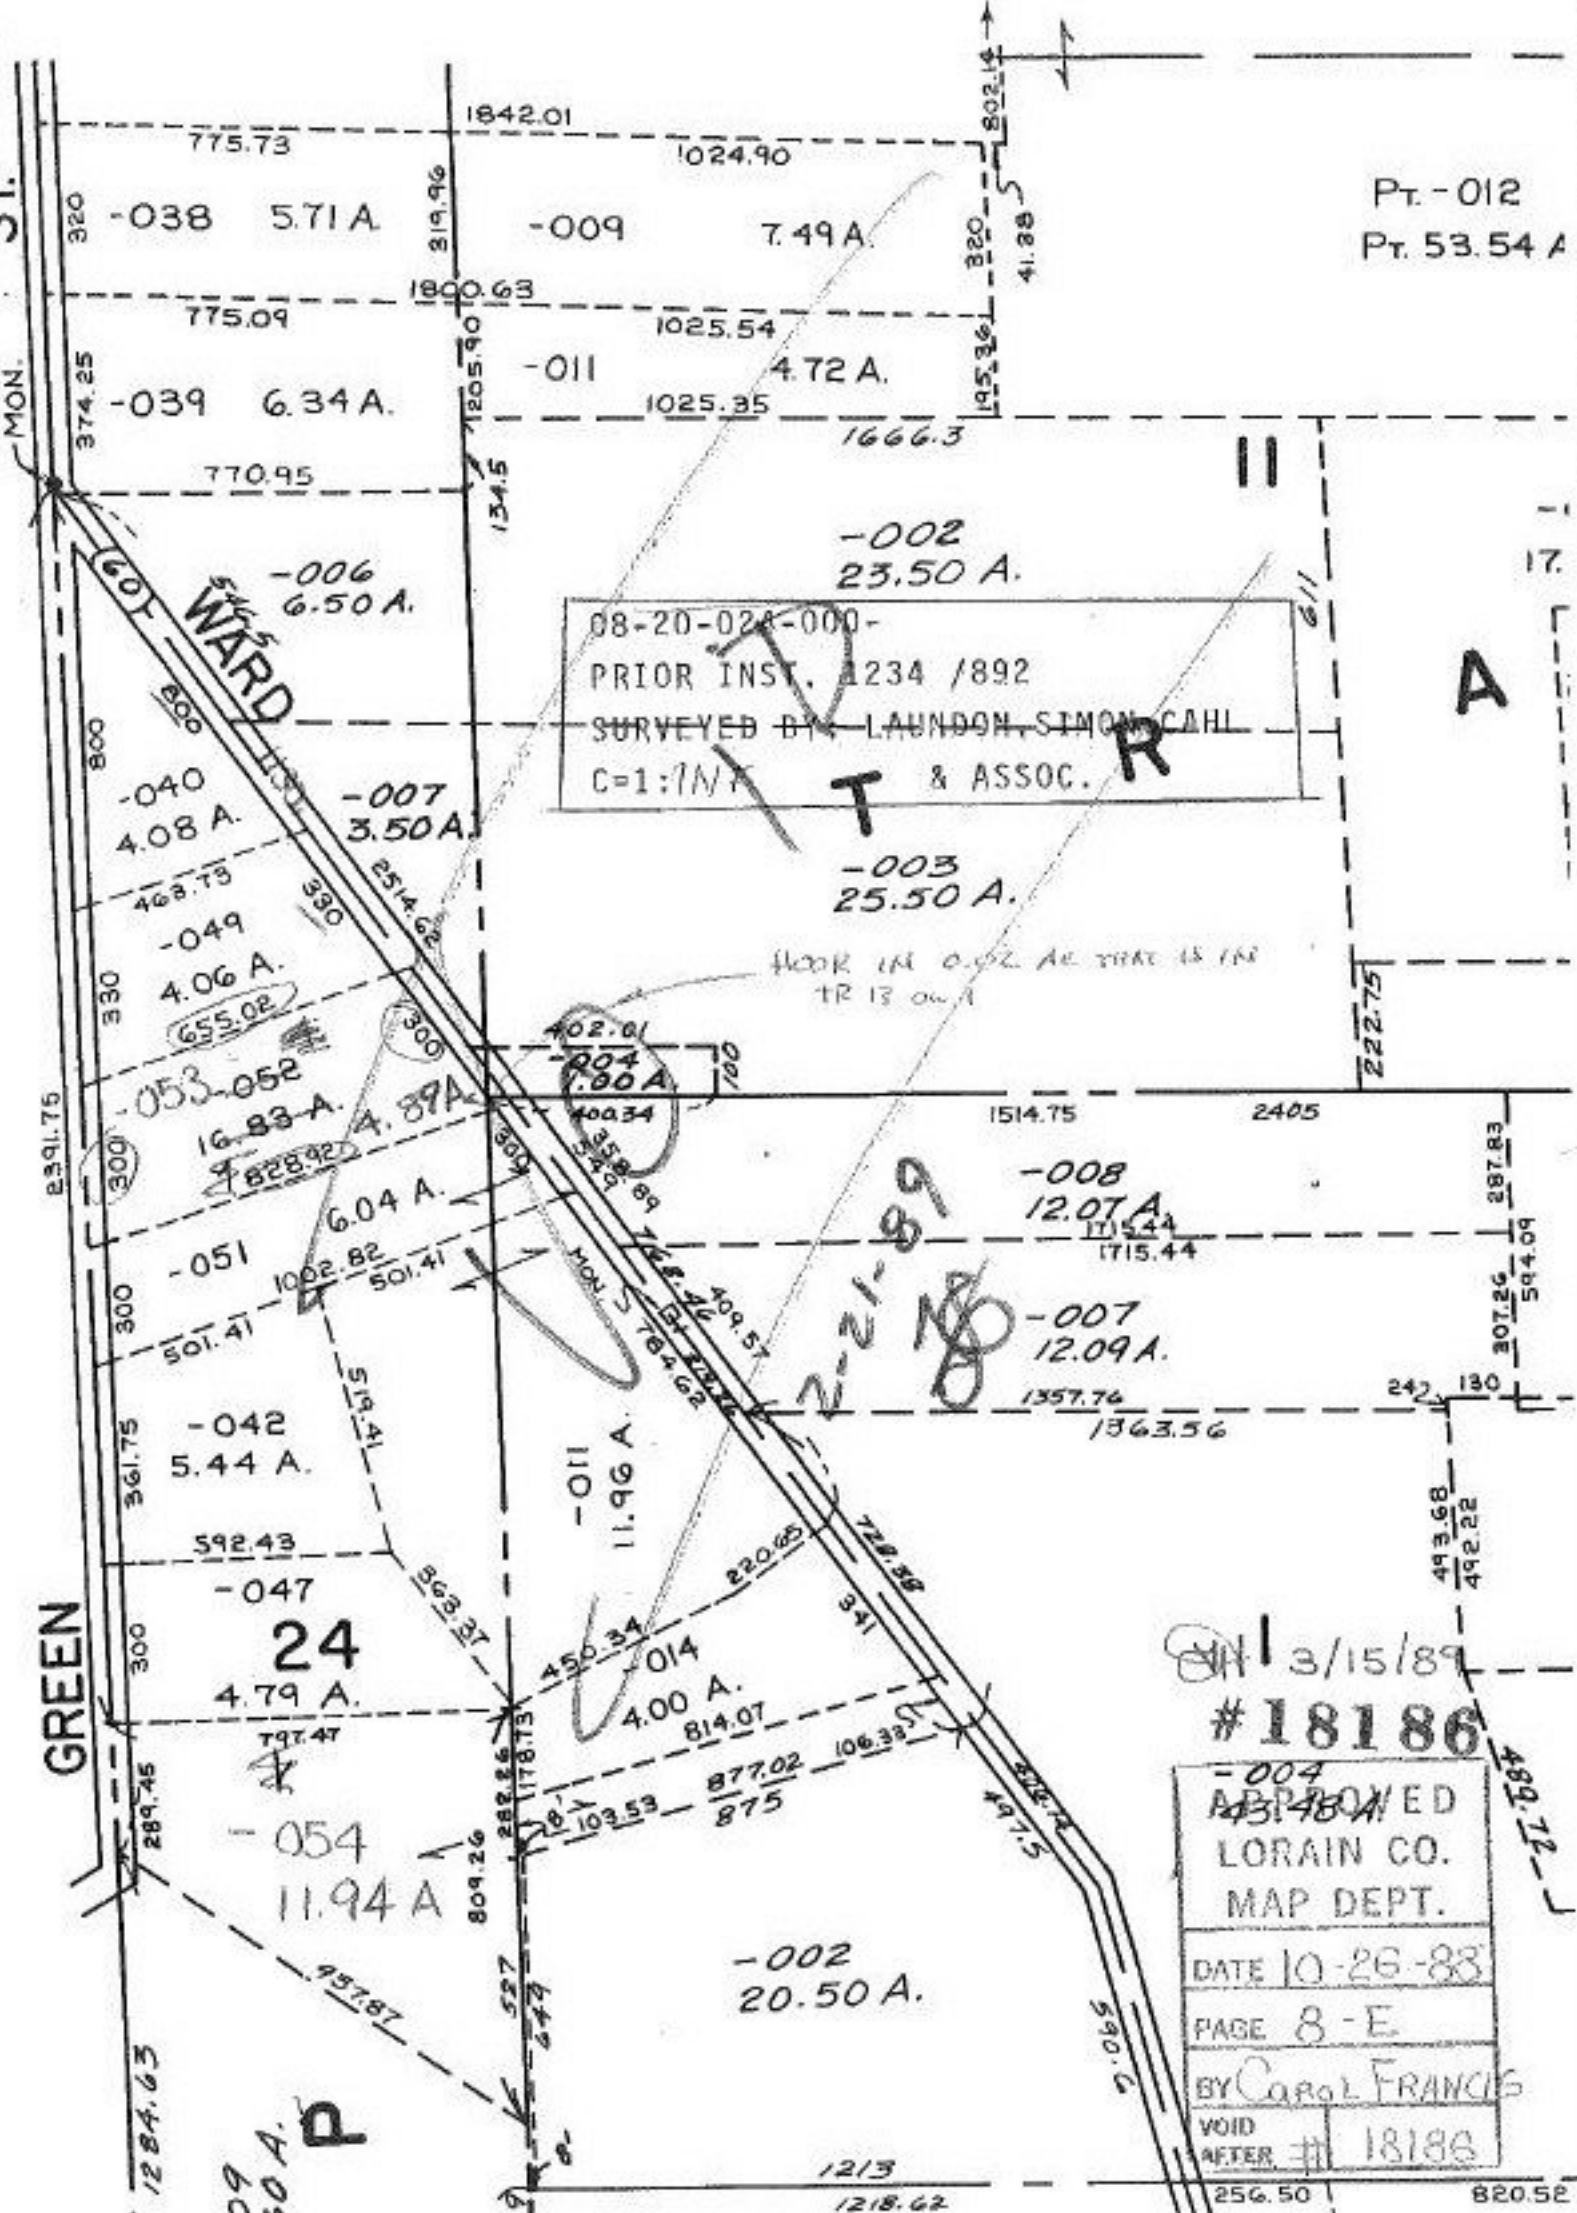

09  
60 A. P

1213  
1218.62

256.50 820.5E