


103	78-013	40	43.97
	-014		
	-015		
	-016	130	40
	74-017	130.06	40

58-016	69-006	40	43.97
	-007		
4-017	A-008		
11-018	0-009	130	40
54-019	73-010	130.06	40

38-016	49-006	40	43.97
	-007		
	-008		
	-009	130	40
34-022	53-010	130.06	40

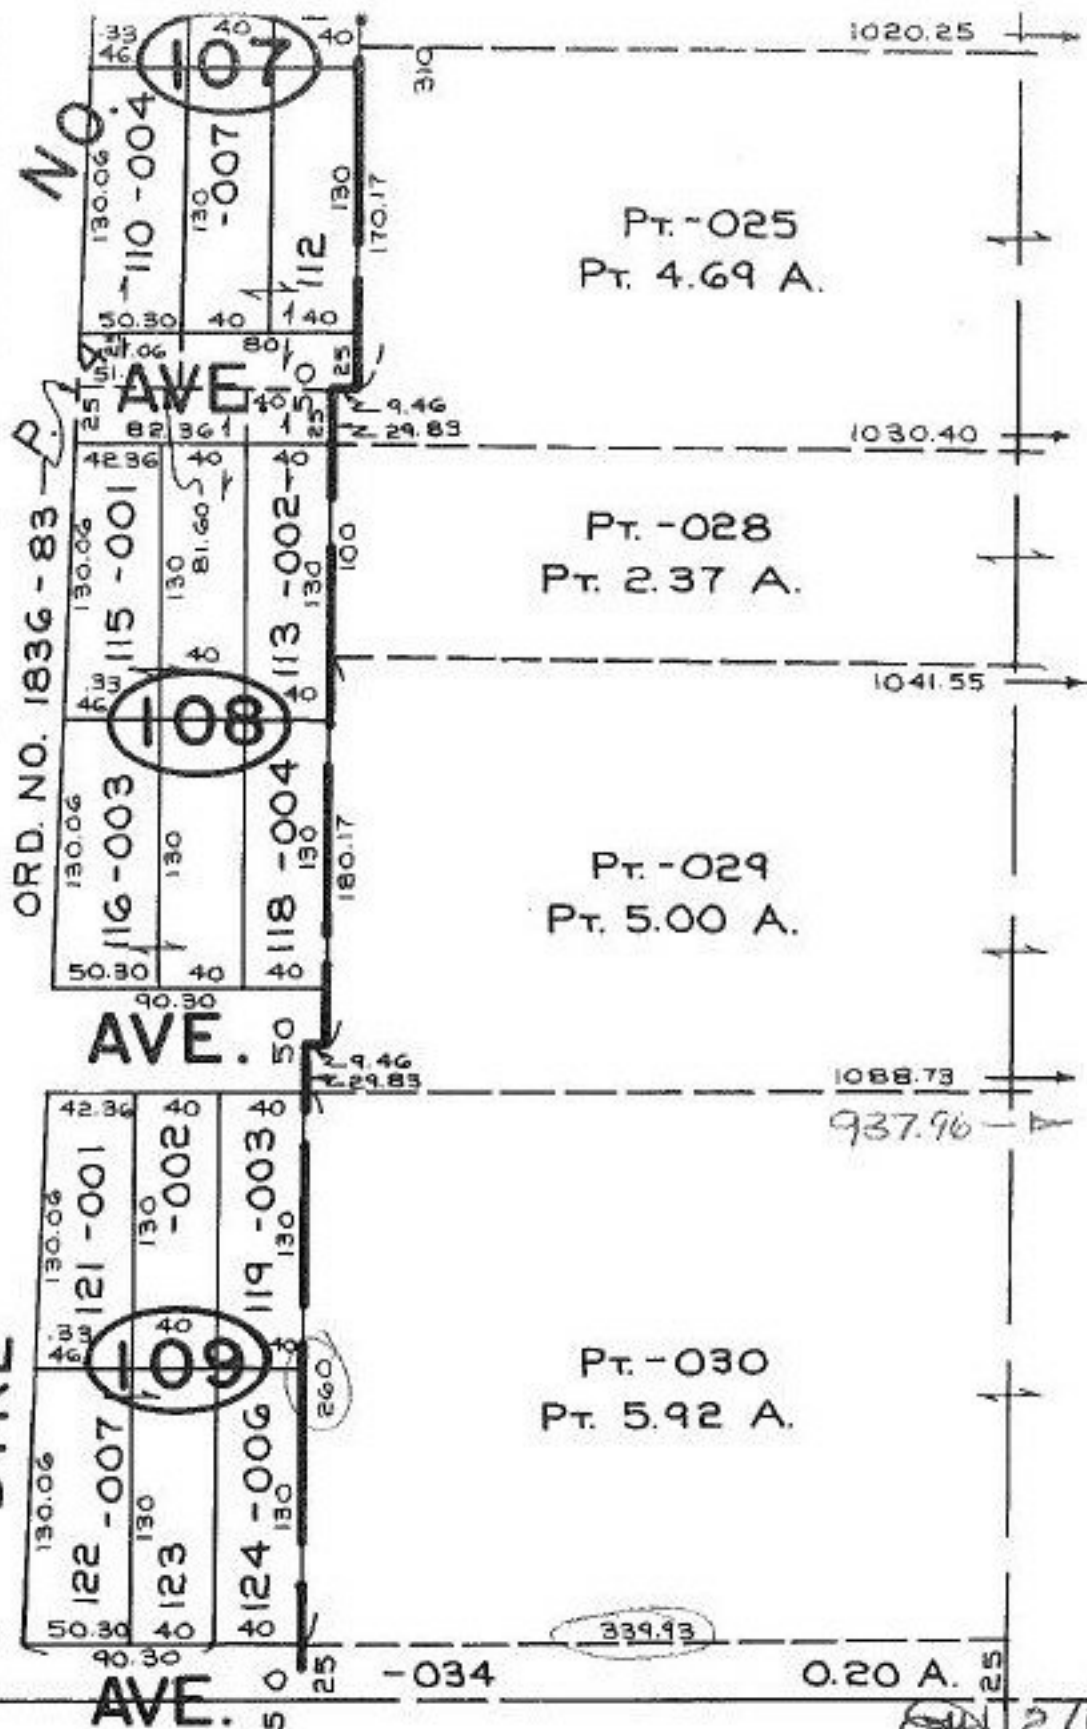

ORD. NO. 1836-83

Distances Added
per Deed Vol. 942/114

"MAP CORR."

2/14/89
#18196A

APPROVED
LORAIN CO.
MAP DEPT.
DATE 11-4-88
7-00- PAGE 045-C
BY Carol Francis
VOID AFTER # 18196A