

RD.

R.

#1820


11-30-87  
UB

-003  
96.75 A.


12

~~002~~  
36.64 A.

~~004~~  
-005  
55.26 A.

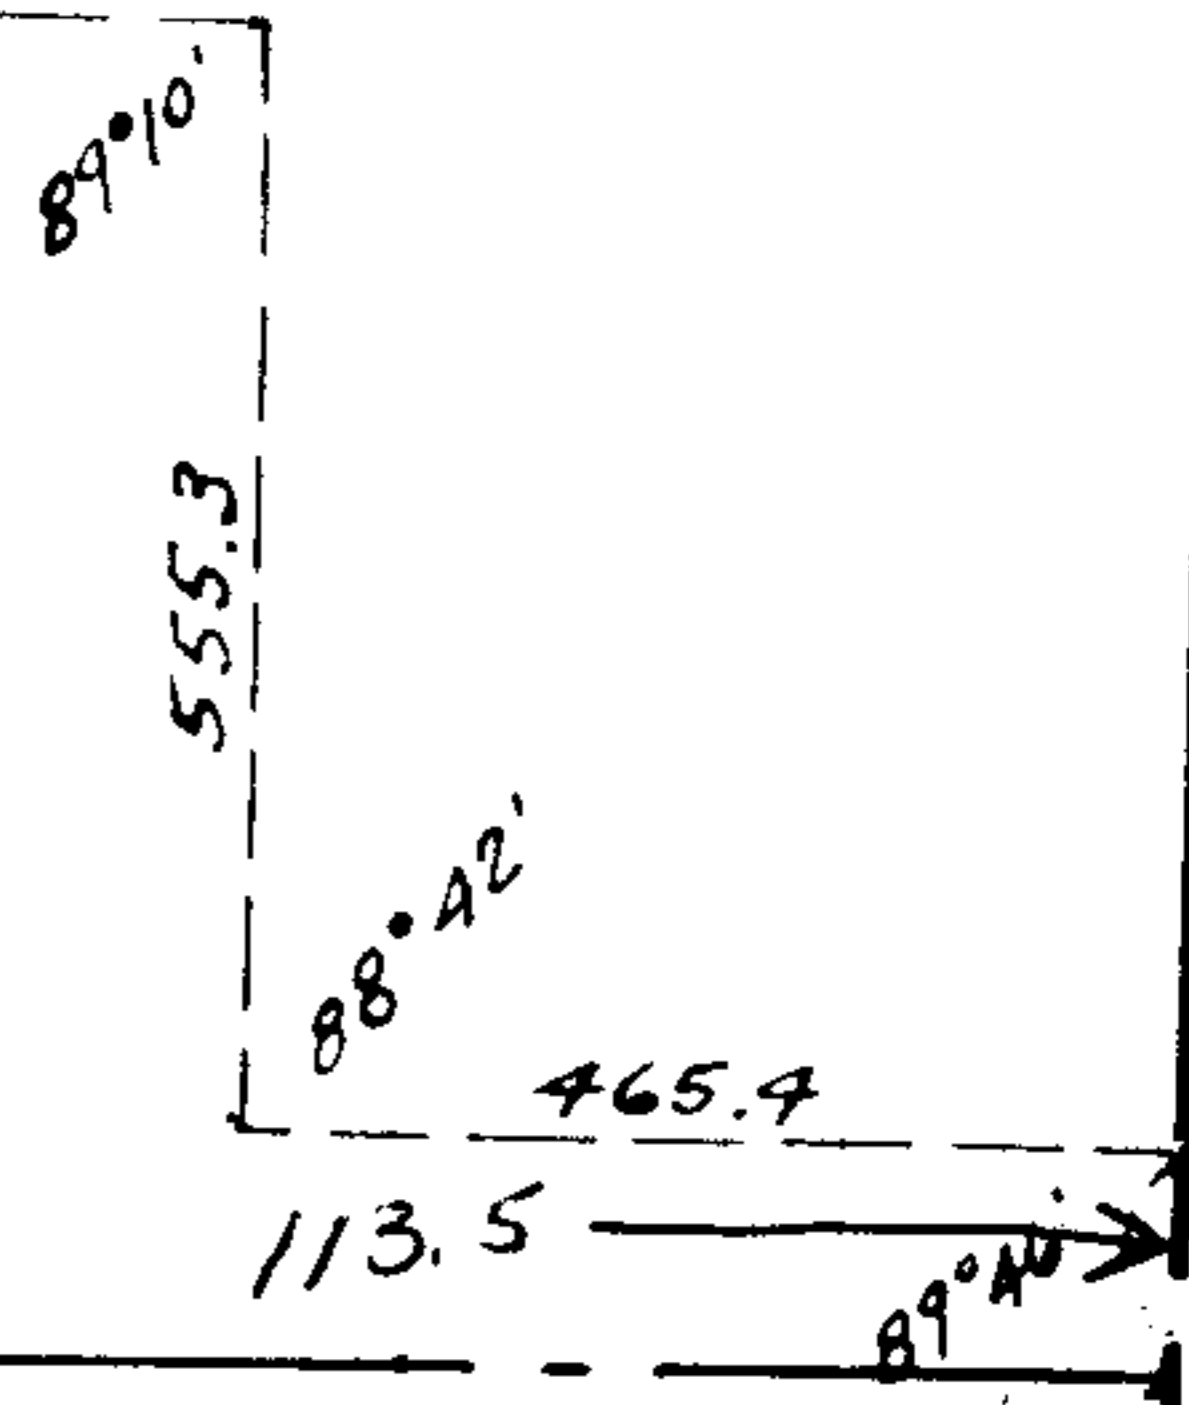

2800

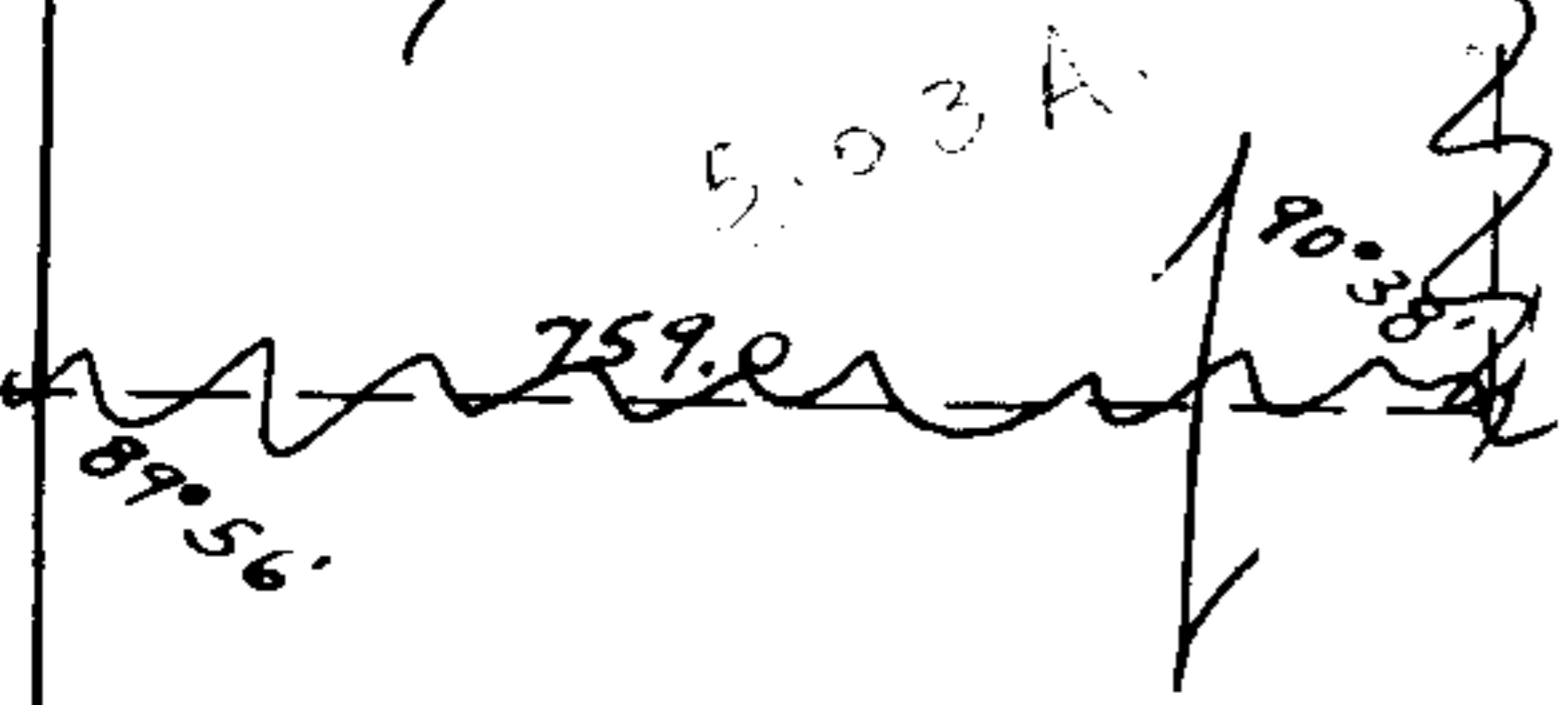

474  
587.6

-005  
71.80 A.

~~004~~  
92.29 A.

1820

APPROVED  
 LORAIN CO.  
 MAP DEPT.  
 DATE 6-7-68  
 21-H.  
 BY  
 Gilbert

18

-006  
25.52 A.

-003  
39.00 A.

DEC 20 1968 -002

1820